



110 Drewry Avenue
Toronto (Ontario) M2M 1C8
Tel. : 416-397-6564 or
1-800-274-3764

Addendum #3

2021-06

Request for Quotation

For

Plumbing Renewal at Sainte-Jeanne-d'Arc

Closing Date:

Friday February 19, 02:00 PM

This Addendum forms part of the Contract Documents and amends the original Bids Documents and Specifications as noted below.

Ensure all parties submitting bids are aware of all items included in this Addendum.

Acknowledge receipt of this Addendum by inserting its number on the Bid Form.
Failure to do so may subject bidder to disqualification.

PART 1: SITE VIDEO

Please note that a copy of the video and the plan identifying the video files can be downloaded on Bids & Tenders.

PART 2 – QUESTIONS & ANSWERS

Question 1: Please clarify the following; Power for 2 x BF-1 is to be part of base bid price and only this fixture type received power in the base bid?

Power for 2 x WF-1 is to be part of alternate bid price (as per note 5 under Specific Electrical notes on ME3-1) and only this fixture type shows any power requirements.

Drawings do not show or mention any power/requirements for any other fixtures such as WC-4, U-1, L-1 L-2 and DL-1. Are we to assume they will not need power?

Answer 1: The bottle filling stations (BF-1) need 120v/1/60 power as part of the base bid. The alternate price for the electronic versions of L-1, L-2, DL-1 are for battery powered faucets that do not require 120v/1/60

Question 2: Specifications Section 01 33 00 - Item 1.6 Submittals - 1.6.1.5 Interference Drawings. Please explain what interference drawings are required since the scope of work is mostly plumbing related.

Answer 2: Interference drawings are not required for this project

Question 3: Why are we changing the PFT just under the toilets in room 122 and 123? And we will have to take out portions to do that

Answer 3: PFT replacement at the toilets in rooms 122 and 123 is not required. Refer to 2003 Arch Addendum 02 attached, including the revised drawing ADD-02.

END OF ADDENDUM 3

Arch ADDENDUM No. 2

Project	Plumbing Renewal At EEC Sainte Jeanne D'Arc	Date of Issue	Feb 4, 2021
Project No.	2003	File	7.1.03Addenda
Owner	Conseil scolaire catholique MonAvenir	Contract(s)	All contracts


This Addendum forms part of the Contract Documents and amends the original Drawings and Specifications as noted below.

Ensure all parties submitting bids are aware of all items included in this Addendum. Read, interpret and coordinate the items contained herein with the Contract Documents and include all related costs as part of the Bid Price. **Acknowledge receipt of all Addenda by inserting its number on the Bid Form.** Failure to do so may subject bidder to disqualification.


This Addendum consists of 1 page + noted attachments

1	PFT replacement at the toilets in rooms 122 and 123 is not required. Refer to revised dwg ADD-02
	Mech / Elec Clarifications by DEI
2	The bottle filling stations (BF-1) need 120v/1/60 power as part of the base bid. The alternate price for the electronic versions of L-1, L-2, DL-1 are for battery powered faucets that do not require 120v/1/60
3	Interference dwgs are not required for this project

END OF ADDENDUM #2

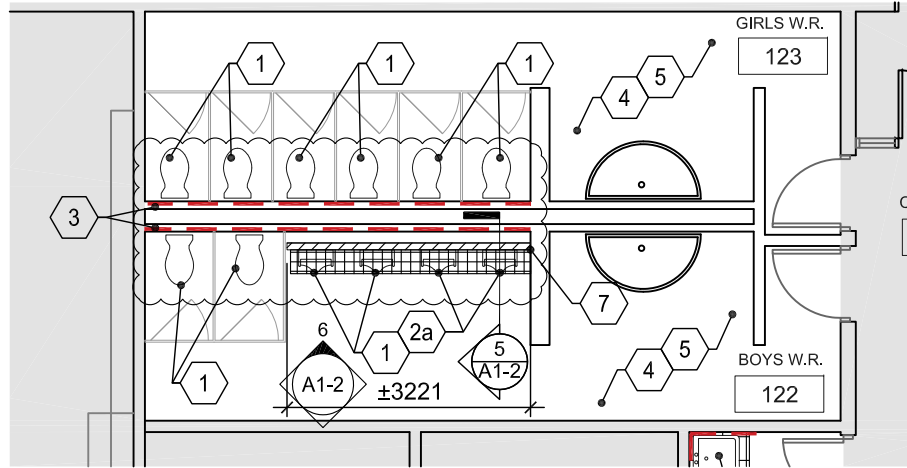


4 PARTIAL GROUND FLOOR RENO PLAN - NORTH
A1-2 SCALE 1:100

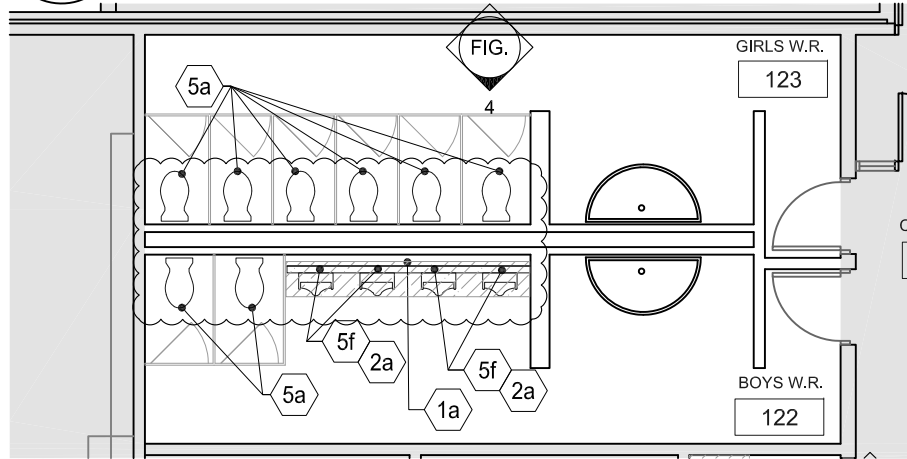

4 PARTIAL GROUND FLOOR DEMO PLAN - NORTH
A1-1 SCALE 1:100

<p>General Contractor shall check and verify all dimensions and report all errors and omissions to the Architect. Do not scale the drawings. Drawings shall not be used for construction purposes until issued by the Architect for construction.</p> <p>Issued for Construction Date _____ Signature _____</p> <p>CADD File</p>		Project	Ecole elementaire Sainte-Jeanne-d'Arc Renovations 25 Rue Laurelcresc, Brampton, Ontario		Project No.	2003	
		Drawing Title	W.R. 122 & 123 - DEMO & RENO PLAN, PARTIAL INTERIOR ELEVATION		Scale	AS NOTED	
		<p>Snyder Architects Inc. 260 King St E, Suite A101, Toronto, ON M5A 4L5 T.416.966.5444 F.416.966.4443, www.snyderarchitects.ca</p>	Revisions	Issued for Addendum 02	Date	2021 02 05	
			Cross Reference		Drawing No.	ADD-02	

Plot Date:

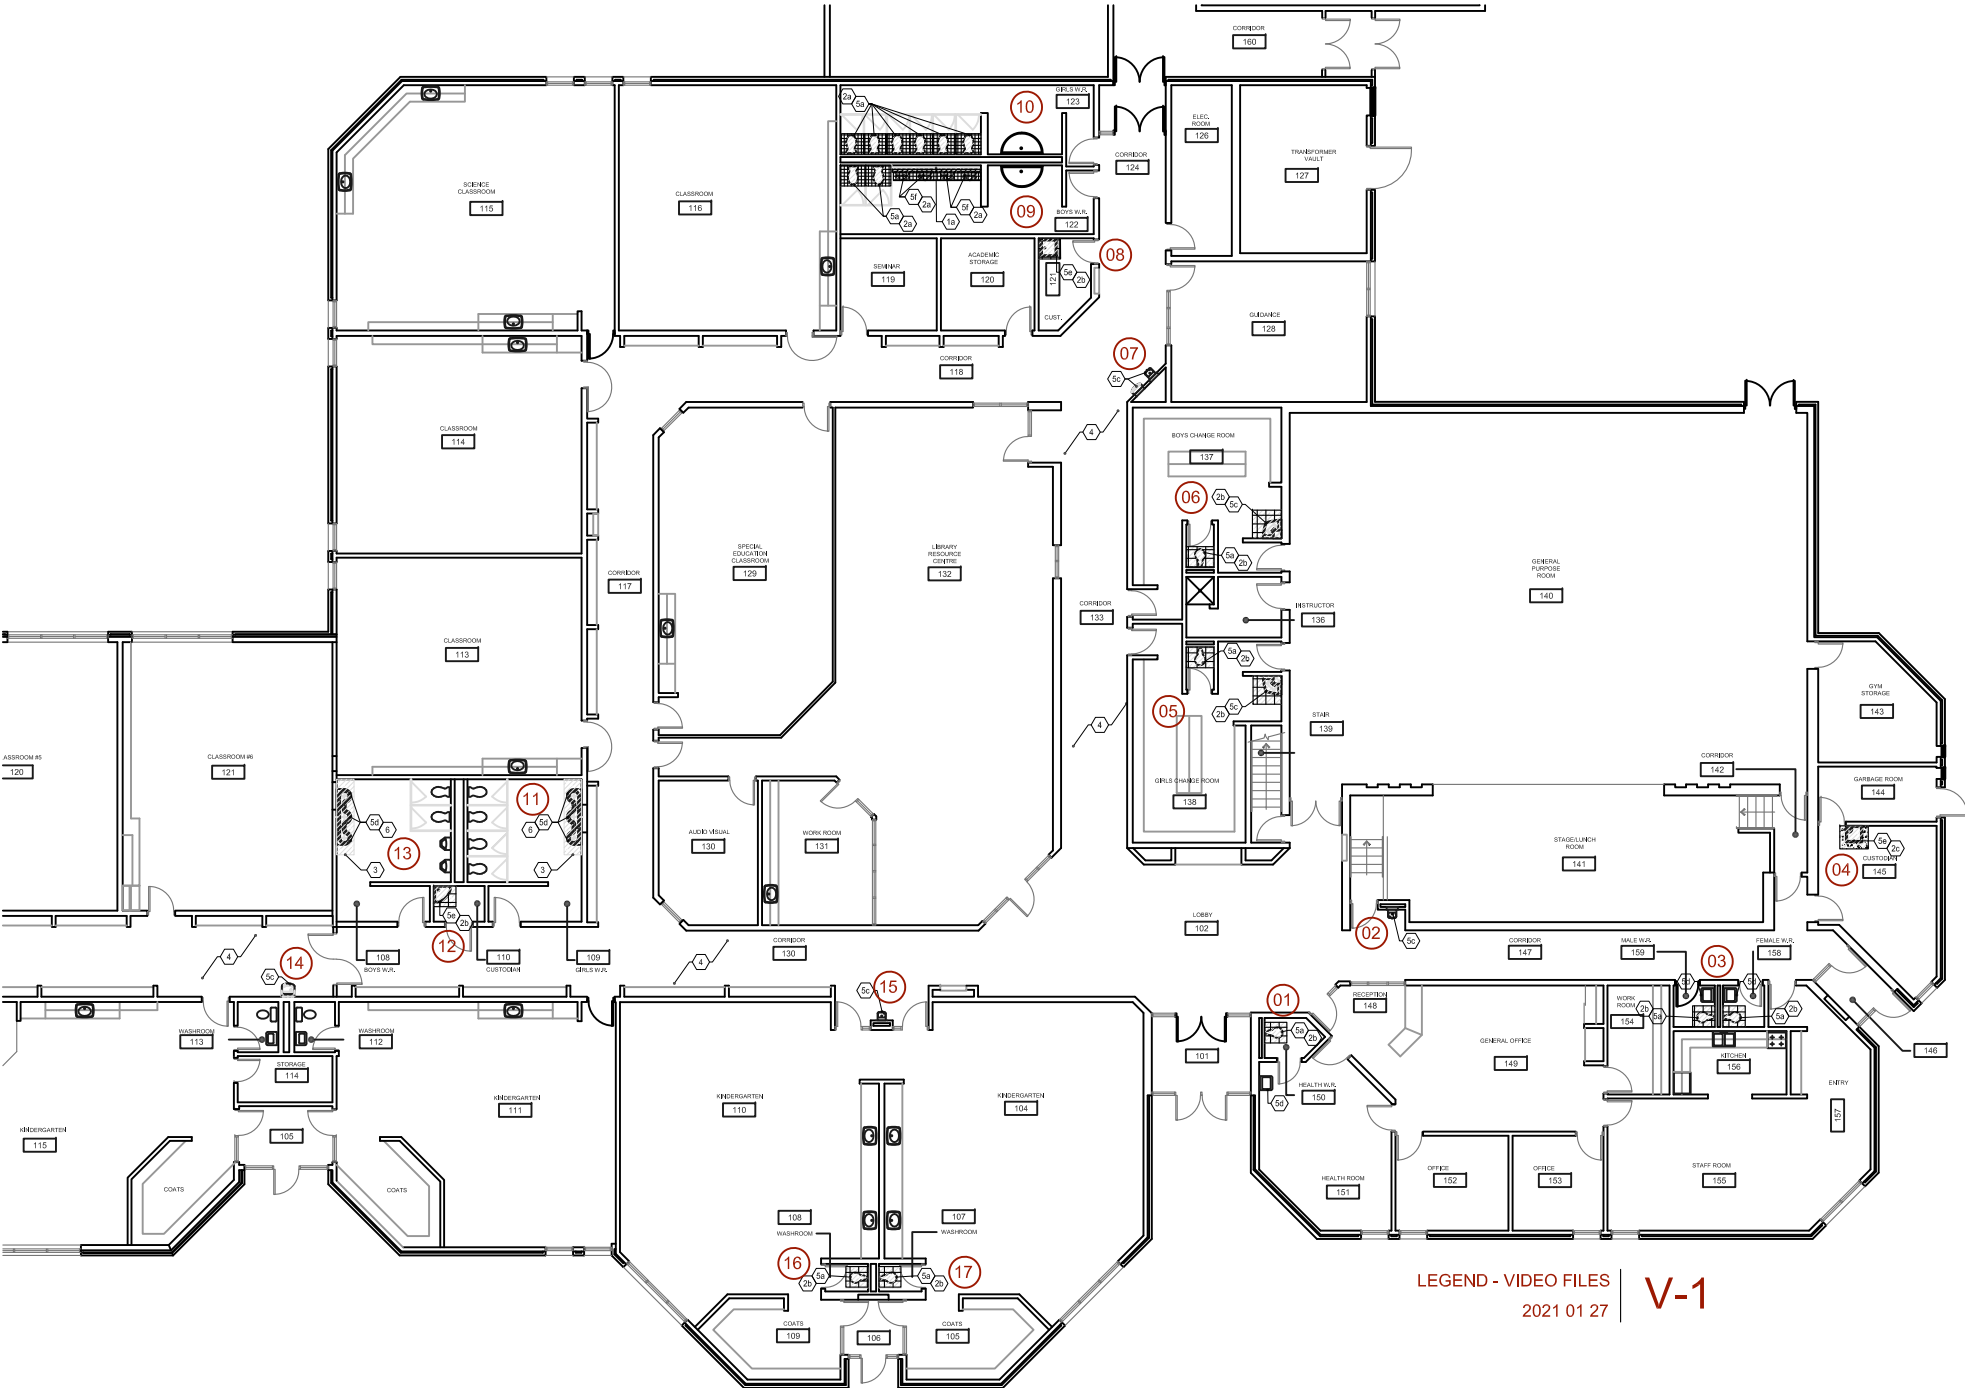

LEGEND - VIDEO FILES | V-1
2021 01 27