



MECHANICAL ADDENDUM NO. MADD-001

Project: Vaughan Willard P.S. – HVAC Upgrades

Date: December 31, 2025

THIS ADDENDUM SHALL FORM AN INTEGRAL PART OF THE TENDER DOCUMENTS. THE CONTENTS OF THIS ADDENDUM SHALL BE BROUGHT TO THE ATTENTION OF ALL CONCERNED.

1. Refer to M-102 (Rev. 2) for highlighted changes.

- a. Updated equipment schedules.
 - i. Added wallfin schedule and unit heater schedule.
 - ii. Revised schedules throughout – most notably RTU schedule and AHU schedule voltage to 575/3/60.

2. Refer to M-103 (Rev. 2) for highlighted changes.

- a. Added 9/M-103 detail re: unit heater piping.

3. Refer to M-104 (Rev. 2) for highlighted changes.

- a. Refer to 6/M-104: added VFD on RTU-3 supply fan.

4. Refer to M-105 (Rev. 2) for highlighted changes.

- a. 1/M-105: revised supply and return fan BAS points.
- b. 2/M-105: revised notes – BAS contractor to match existing BAS points re: existing AHU-1 heat wheel.

5. Refer to M-200 (Rev. 2) for highlighted changes.

- a. 1/M-200: removed existing exhaust fan and wallfin within mechanical room.
- b. 2/M-200: updated keyed notes.
- c. Glycol pumps to be in-line circulator pumps.
- d. Added unit heater in replacement of removed wallfin.
- e. Revised location of RHC-RTU-3 and associated supply and return ductwork.
- f. Added custom door and indoor steps at NE corner of mechanical room to allow for easy roof access.



6. Refer to M-201 (Rev. 2) for highlighted changes.
 - a. Revised keyed notes – added keyed note 3.
7. Refer to M-202 (Rev. 2) for highlighted changes.
 - a. 2/M-202: revised keyed notes – added keyed note 4.
8. Refer to M-300 (Rev. 2) for highlighted changes.
 - a. Revised general notes – ductwork associated with existing AHU-1 is already insulated as required. All new and existing ductwork associated with RTU-3 to be insulated. Refer to general notes on drawing.
9. Refer to M-400 (Rev. 2) for highlighted changes.
 - a. RTU-3 ductwork location revised, acoustically lined for first 10 ft. from unit.
 - b. CDU-1 location moved South (minimum of 10ft. from roof edge).
 - c. Revised keyed notes.
10. Refer to M-500 (Rev. 2) for highlighted changes.
 - a. Revised pumps in schematic – to have single strainer that serves both inline circulator pumps in parallel. Check valve after each individual pump.
11. Electrical and Structural drawings issued for tender – see attached.

End of Mechanical Addendum MADD-001

PERFORM ALL MECHANICAL WORK DETAILED ON THESE DRAWINGS TO PROVIDE A COMPLETE AND FULLY FUNCTIONAL OPERATING SYSTEM TO THE SATISFACTION OF THE MECHANICAL CONSULTANT.

EQUIPMENT SUBSTITUTIONS AFTER AWARD OF CONTRACT WILL NOT BE CONSIDERED WITHOUT WRITTEN EXPLANATION AND CONSULTANT'S WRITTEN AUTHORIZATION. THE QUALITY AND PERFORMANCE CHARACTERISTICS OF SUBSTITUTED PRODUCT SHALL BE EQUIVALENT TO THE SPECIFIED PRODUCT. ALL SUBSTITUTE PRODUCTS SHALL BE APPROVED BY CONSULTANTS. ANY ADDITIONAL COSTS INCURRED BY ALL TRADES FOR SUBSTITUTED EQUIPMENT INSTALLATION MUST BE INCURRED BY THIS CONTRACT.

SCHOOL BOARD STANDARDS SHALL FORM THE BASIS FOR THIS CONSTRUCTION. COMPLY WITH SCHOOL BOARDS' REQUIREMENTS FOR SYSTEM SHUTDOWN AND CONNECTION.

CODES AND BYLAWS SHALL BE STRICTLY ADHERED TO. OBTAIN NECESSARY PERMITS, APPROVALS AND INSPECTIONS FROM THE AUTHORITIES HAVING JURISDICTION.

PERMITS AND FEES REQUIRED BY THE AUTHORITIES HAVING JURISDICTION SHALL BE OBTAINED AND PAID FOR BY THIS CONTRACTOR. INCLUDE ALL APPLICABLE TAXES.

EXISTING SITE CONDITIONS AFFECTING THE WORK OF THIS TRADE SHALL BE REVIEWED PRIOR TO TENDER SUBMISSION. FAILURE TO DO SO SHALL NOT RELIEVE CONTRACTOR OF FULL CONTRACT RESPONSIBILITY.

CUTTING, PATCHING AND CORE DRILLING REQUIRED BY THIS TRADE SHALL BE PAID FOR BY THIS CONTRACTOR. X-RAY CONCRETE STRUCTURE IN ACCORDANCE WITH OWNER/LANDLORD STRUCTURAL ENGINEER'S REQUIREMENTS. PROVIDE DETAILS OF NEW OPENING THROUGH STRUCTURAL COMPONENTS FOR ENGINEER'S APPROVAL. INCLURE ALL COSTS RELATED FOR STRUCTURAL APPROVAL.

FIRE STOP SHALL BE ULC LISTED FOR THE REQUIRED SEPARATION AND PROVIDED AT ALL PIPE PENETRATIONS THROUGH RATED ASSEMBLIES.

PREMIUM TIME COSTS SHALL BE INCLUDED FOR WORK OUTSIDE OF NORMAL WORKING HOURS.

SHOP DRAWINGS SHALL BE COMPLETE WITH CONTRACTORS REVIEWED STAMP. SUBMIT ONE ELECTRONIC COPY. ALLOW ONE (1) WEEK FOR ENGINEERS REVIEW.

CONTROL WIRING AND DEVICES SHALL BE PROVIDED UNDER THIS CONTRACT, UNLESS NOTED OTHERWISE. WHEN REQUIRED, CONTROLS WORK SHALL BE COMPLETED BY SCHOOL BOARD'S APPROVED CONTRACTOR AND PAID FOR UNDER THIS CONTRACT.

ELECTRICAL DEVICES SHALL BE PROVIDED FOR ALL LOAD SIDES INCLUDING WIRING, STARTERS, DISCONNECT, ETC. VERIFY AND COORDINATE VOLTAGE AND PHASE WITH THE ELECTRICAL CONTRACTOR PRIOR TO ORDERING EQUIPMENT.

ACCESS DOORS SHALL BE PROVIDED FOR ALL INACCESIBLE MECHANICAL EQUIPMENT AND SERVICES REQUIRING INSPECTION OR SERVICE. FINISH SHALL SUIT DESIGNERS' REQUIREMENTS. ACCESS DOORS SHALL BE RECESSED AS REQUIRED TO SUIT WALL FINISH (EG. TILE).

ENGINEERS FINAL INSPECTION IS IMPERATIVE. PRIOR TO INSTALLATION OF ALL CEILINGS, THIS CONTRACTOR SHALL CONTACT MARGARET EDWARDS (ROMAR) AT MEDWARDS@ROMARENGINEERING.COM TO PERFORM A FINAL INSPECTION. WHEN CEILING TILES HAVE BEEN INSTALLED IT WILL BE NECESSARY FOR THE CONTRACTOR TO REMOVE PORTIONS FOR INSPECTION.

ONE YEAR WRITTEN WARRANTY SHALL BE PROVIDED FOR THE COMPLETE MECHANICAL INSTALLATION FROM DATE OF ACCEPTANCE.

CAD-BUILT DRAWINGS SHALL BE COMPLETED UTILIZING AUTOCAD. OBTAIN DRAWINGS FROM ENGINEER. RECORD ACCURATELY INSTALLED WORK ON WHITE PRINTS TRANSFERRING TO AUTOCAD. SUBMIT BOTH COPIES.

OPERATING AND MAINTENANCE MANUALS CONTAINING APPROVED SHOP DRAWINGS, AIR AND WATER BALANCING REPORTS, EQUIPMENT DATA SHEETS, WRITTEN WARRANTY, OPERATING INSTRUCTIONS AND MAINTENANCE PROCEDURES SHALL BE SUBMITTED TO CONSULTANT FOR REVIEW. MANUALS SHALL BE SEPARATED WITH DIVIDERS IN APPROPRIATE SECTIONS. MAKE ALL CORRECTIONS REQUESTED BY CONSULTANT AND RESUBMIT FOR REVIEW.

CHANGE NOTICE QUOTATIONS SHALL BE SUBMITTED COMPLETE WITH COST BREAKDOWN OF LABOUR AND MATERIALS. FAILURE TO PROVIDE WILL RESULT IN REJECTION. ALL MECHANICAL CHANGE NOTICES SHALL BE PRICED IN ACCORDANCE WITH "MECHANICAL CONTRACTORS ASSOCIATION" (MCA) LABOUR UNITS STRICTLY FOR LABOUR AND FOR MATERIAL COST USE "ALL PRICER" LESS DISCOUNT, TYPICALLY 25% FOR VALVES AND OTHER MATERIALS.

TEMPORARY FILTERS 25MM (1 IN.) SHALL BE PROVIDED AT ALL BASE BUILDING RETURN AIR OPENINGS WHICH REMAIN OPERATIONAL DURING CONSTRUCTION. FILTERS TO BE REPLACED WEEKLY. REMOVE UPON CONSTRUCTION COMPLETION.

MECHANICAL DEMOLITION

PROVIDE LABOUR, MATERIALS, PRODUCTS, EQUIPMENT AND SERVICES REQUIRED TO COMPLETE THE DEMOLITION WORK SPECIFIED HEREIN.

REFER TO DRAWINGS FOR EXTENT OF DEMOLITION WORK. THE DRAWINGS INDICATE THE APPROXIMATE LOCATIONS OF SERVICES AS FAR AS THESE ARE KNOWN.

DISPOSE, OFF SITE, OF ALL DEBRIS IN ACCORDANCE WITH THE JURISDICTIONAL AUTHORITIES.

REMOVAL AND STORAGE OF SALVAGEABLE ITEMS AS DIRECTED BY THIS SPECIFICATION SECTION AND THE OWNER OF THEIR REPRESENTATIVE.

MEET THE REQUIREMENTS AND RECOMMENDATIONS OF ALL MUNICIPAL, PROVINCIAL AND FEDERAL BYLAWS AND ORDINANCES. EXECUTE THIS WORK IN ACCORDANCE WITH THE LATEST EDITION OF THE FOLLOWING CODES AND STANDARDS. CAN/CSA-S350-M1980 CODE OF PRACTICE FOR SAFETY IN DEMOLITION OF STRUCTURES. ONTARIO BUILDING CODE. OCCUPATIONAL HEALTH AND SAFETY ACT. REGULATIONS FOR CONSTRUCTION PROJECTS. ONTARIO FIRE CODE. REGULATIONS UNDER FIRE MARSHALS ACT.

REMOVAL FROM SITE AND DISPOSAL OF DEBRIS SHALL BE CARRIED OUT IN ACCORDANCE WITH THE REQUIREMENTS OF THE LOCAL JURISDICTIONAL AUTHORITIES. ARRANGE AND PAY FOR ALL PERMITS, NOTICES AND INSPECTIONS NECESSARY FOR THE PROPER EXECUTION AND COMPLETION OF THE DEMOLITION WORK. ALL MATERIALS WHICH HAVE NOT BEEN DESIGNATED FOR SALVAGE FROM THE DEMOLITION SHALL BECOME THE PROPERTY OF THE CONTRACTOR. REMOVE ALL MATERIAL AND DEBRIS FROM THE SITE AS QUICKLY AS POSSIBLE AND DISPOSE OF LEGALLY. BURNING OF DEBRIS OR SELLING OF MATERIALS ON THE SITE WILL NOT BE PERMITTED. CONFORM TO REQUIREMENTS OF MUNICIPALITY'S WASTE MANAGEMENT FACILITIES SHALL BE REMOVED FROM SITE AND DISPOSED OF THROUGH RECYCLING COMPANIES SPECIALIZING IN RECYCLABLE MATERIALS. AT THE END OF EACH WORK SHIFT, LEAVE WORK IN A SAFE CONDITION. PATCH SPANNING FIRE RATED ASSEMBLIES. DEMOLISH WORK INTO SECTIONS OF PRACTICAL SIZE FOR REMOVAL WITHOUT ALTERATION OR DAMAGE TO EXISTING BUILDING. STORE MATERIALS ONLY IN AREAS DESIGNATED BY THE OWNER AND AS PERMITTED BY THE LOCAL JURISDICTIONAL AUTHORITIES. MATERIALS AND DEBRIS SHALL NOT BE STACKED IN BUILDING TO THE EXTENT THAT OVERLOADING OF ANY PART OF THE STRUCTURE WILL OCCUR.

CONFER WITH THE OWNER CONCERNING SCHEDULE, DUST AND NOISE CONTROL, PRIOR TO COMMENCING WORK IN OR ADJACENT TO EXISTING FACILITIES WHERE SUCH WORK MIGHT AFFECT EITHER THOSE FACILITIES OR THEIR OCCUPANTS. EXECUTE WORK WITH LEAST POSSIBLE INTERFERENCE OR DISTURBANCE TO OCCUPANTS, PUBLIC AND NORMAL USE OF PREMISES. PROVIDE TEMPORARY MEANS TO MAINTAIN SECURITY WHEN SECURITY HAS BEEN REDUCED BY DIVISION 15.

PROVIDE TEMPORARY DUST SCREENS, BARRIERS, WARNING SIGNS IN LOCATIONS WHERE RENOVATIONS AND ALTERATION WORK IS ADJACENT TO AREAS WHICH WILL BE OPERATIVE DURING WORK.

PROTECT ALL MECHANICAL SYSTEMS, INDICATED TO REMAIN, FROM DAMAGE. PROVIDE AND MAINTAIN READY ACCESS TO FIREFIGHTING EQUIPMENT AT ALL TIMES. PROVIDE AND MAINTAIN PROPER AND SUITABLE FIRE EXTINGUISHERS THROUGHOUT THE DURATION OF THE WORK.

THE DRAWINGS INDICATE THE APPROXIMATE LOCATIONS OF SERVICES AS FAR AS THESE ARE KNOWN. SHOULD ANY MECHANICAL CONTROLS, OR ELECTRICAL SERVICE LINE BE BROKEN, OR DISRUPTED BY OPERATIONS SPECIFIED UNDER THIS CONTRACT, REPAIR SERVICE LINES, AND MAKE GOOD ALL DAMAGE DUE TO THE DISRUPTION OR BREAK, AT NO EXPENSE TO THE BOARD. NOTIFY THE BOARD IMMEDIATELY WHENEVER ANY SERVICE LINE IS BROKEN OR DAMAGED.

ACCEPT LIABILITY FOR COSTS INCURRED BY THE BOARD IN REPAIRING AND CLEANING EQUIPMENT, ETC., RESULTING FROM FAILURE TO COMPLY WITH THE ABOVE REQUIREMENTS.

CLEAN UP

DURING THE PROCESS OF WORK EACH CONTRACTOR SHALL KEEP HIS WORK TIDY. THE PREMISES SHALL AT ALL TIMES BE FREE FROM RUBBISH AND SURPLUS MATERIALS, CLEAN DAILY.

PROTECTING-TRADES

DIVISION 15 IS ENTIRELY FINANCIALLY RESPONSIBLE FOR ALL DAMAGE TO PROPERTY OR ADJACENT PROPERTY, ARISING OF THE WORK OF THIS CONTRACTOR, WHETHER CAUSED BY HIMSELF OR ANY PERSONS ENGAGED ON HIS WORK.

DIVISION 15 CONTRACTORS ARE RESPONSIBLE TO ENSURE THAT THEIR EMPLOYEES AND SUB-TRADES USE ONLY SAFE PRACTICES AND CONDITIONS, OBSERVE ALL SAFETY REGULATIONS, SECURITY REGULATIONS AND FIRE SAFETY RULES.

DUCTWORK

NEW MATERIAL AND EQUIPMENT SHALL BE PROVIDED AND INSTALLED IN ACCORDANCE WITH BASE BUILDING STANDARDS.

DUCTWORK AND HANGERS SHALL BE FABRICATED IN ACCORDANCE WITH THE LATEST SMACNA STANDARDS.

FLEXIBLE DUCTWORK SHALL BE FLEXMASTER TRIPLE LOC OR EQUAL, SPIRAL WOUND ALUMINUM. SECURE TO RIGID DUCT USING GEAR CLAMPS. AT THE INLET OF EACH VAV TERMINAL CONTROL UNIT, PROVIDE A MINIMUM OF 3 DIAMETERS OF STRAIGHT FLEX DUCT. MAXIMUM LENGTH 1200 MM [4 FT.-0 IN.]. FLEXIBLE DUCTS SERVING DIFFUSERS SHALL BE INSTALLED AS ONE CONTINUOUS PIECE AND SHALL NOT EXCEED 10'-0" LENGTHS.

FIRE SMOKE DAMPER SHALL BE OUT OF STREAM ULC LABELED. PROVIDE FIRE SMOKE DAMPERS AS REQUIRED IN NEW AND EXISTING DUCTWORK C/W ACCESS DOORS.

ACOUSTIC DUCT LINING 25MM [1 IN.] SHALL BE PROVIDED WHERE SHOWN ON DRAWINGS. SECURE WITH MECHANICAL FASTENERS AND ADHESIVE. SEAL RAW EDGES. NOTE DUCT DIMENSIONS ARE CLEAR INSIDE.

THERMAL INSULATION WITH VAPOUR BARRIER SHALL BE PROVIDED ON ALL NEW SUPPLY AIR DUCTWORK TO MATCH BASE BUILDING STANDARDS OR REFER TO INSULATION SECTION. ALL THERMAL INSULATION IS TO BE INSTALLED BY A RED SEAL LICENSED INSULATOR AS PER DDSB REQUIREMENTS.

FLEXIBLE DUCT CONNECTIONS SHALL BE DURODYNE NEOPRENE AND INSTALLED BETWEEN ALL AIR HANDLING EQUIPMENT AND SYSTEM DUCTWORK.

AIR TRANSFER OPENINGS INDICATED WITHOUT DUCT SHALL BE THIS CONTRACTOR'S RESPONSIBILITY TO ADVISE AND CONFIRM PROVISION BY GENERAL TRADES.

BALANCING AND VOLUME CONTROL DAMPERS SHALL BE PROVIDED IN NEW OR EXISTING DUCTWORK TO PROVIDE A COMPLETE AND BALANCED SYSTEM. BALANCING WORK SHALL BE COMPLETED BY DDSB APPROVED CONTRACTOR AND PAID FOR UNDER THIS CONTRACT. CONTRACTORS TO CONTACT ARE: QUALITY AIR DISTRIBUTION INC. AT 289-892-7168 OR AIRFLOW TESTING AND BALANCING AT 613-870-9314.

FAN SHEAVES SHALL BE ADJUSTED OR REPLACED AS REQUIRED TO OBTAIN DESIGN AIR QUANTITIES. COORDINATE THIS WORK WITH OWNER/LANDLORD.

HVAC PIPING SYSTEMS

PIPING MATERIAL FOR HEATING, CHILLED AND HEAT PUMP CIRCUITS SHALL BE ASTM A53 BLACK STEEL SCHEDULE 40, ELECTRIC RESISTANCE WELDED. PIPING UNDER 65MM (2-1/2") SHALL BE THREADED FOR 1035 KPA (150 PSI) BEADED MALLEABLE IRON LINE JOINT COUPLINGS AND 860 KPA (125 PSI) THREADED CAST IRON FITTINGS.

PIPING 65MM (2-1/2") AND LARGER SHALL HAVE WELDED LINE JOINTS WITH ENDS BEVELED FOR WELDING AND STANDARD WALL SEAMLESS STEEL, GRINEL, TUBURN OR LADISH FITTINGS AND 1035 KPA (150 PSI) SLIP-ON FLANGES. CONDENSATE DRAINS SHALL BE DWV COPPER DRAINAGE TUBE WITH CAST BRASS FITTINGS AND 50/50 SOLDERED JOINTS.

VALVES CRANE OR JENKINS (JENKINS FIGURE NUMBER LISTED BELOW):

.1 TO 1379 KPA [200 PSI] WORKING PRESSURE:

| | GATE | GLOBE | BALL |
|------------------------------|------|--------|----------------|
| 50 MM [2 IN.] AND SMALLER | | | |
| SOLDERED | 813 | 106-BP | 34 |
| SCREWED | 810 | 106-B | 33 |
| 65 MM [2-1/2 IN.] AND LARGER | | | |
| FLANGED | 454 | 2342 | NOT APPLICABLE |

.2 TO 2068 KPA [300 PSI] WORKING PRESSURE:

| | GATE | GLOBE | BALL |
|------------------------------|------|--------|----------------|
| 50 MM [2 IN.] AND SMALLER | | | |
| SOLDERED | 902A | 106-BP | 34 |
| SCREWED | 2810 | 106-B | 33 |
| 65 MM [2-1/2 IN.] AND LARGER | | | |
| FLANGED | 204 | 162 | NOT APPLICABLE |

CHECK VALVE: CRANE 37

.3 PROVIDE BALL OR BUTTERFLY VALVES FOR ALL SHUT-OFF REQUIREMENTS. GATE VALVES WILL NOT BE APPROVED.

.4 PROVIDE 20 MM [3/4" IN.] HOSE END DRAIN VALVES WITH CAP AND CHAIN AT ALL SYSTEM LOW POINTS.

.5 PROVIDE DI-ELECTRIC COUPLINGS FOR CONNECTION OF DISSIMILAR PIPING MATERIALS.

PROVIDE CIRCUIT BALANCING VALVES AS REQUIRED TO BALANCE WATER FLOW. CIRCUIT BALANCING VALVES SHALL BE ARMSTRONG MODEL CRBV - Y PATTERN STYLE, ALL METAL, WITH SOLDERED OR SCREWED CONNECTIONS, BUILT-IN DRAIN CONNECTION WITH SHUT OFF VALVE AND PROTECTIVE CAPS AND INTEGRAL VALVE INSULATION. PROVIDE FOR EACH VALVE:

.1 VERNIER TYPE HANDWHEEL SETTINGS FOR PRECISION FLOW BALANCING.

.2 POSITIVE SHUT OFF VALVE WITH NO DRIP SEAT AND PLUG TYPE STEM WITH TEFLOON DISC.

.3 TAMPER PROOF HIDDEN MEMORY.

.4 POSITIVE SHUT OFF METERING VALVES WITH CONNECTIONS FOR PORTABLE METER.

SELECT CIRCUIT BALANCING VALVE SIZE TO GIVE A PRESSURE DROP AT 100% OPEN BETWEEN 3.0 KPA [1 FT.] AND 21 KPA [7 FT.]. SELECT VALVES LOCATION REMOTE FROM THE PUMPS IN THE CIRCUIT NEAR MINIMUM PRESSURE DROP AND THOSE LOCATED NEAR THE PUMPS AT HIGHER PRESSURE DROPS.

PROVIDE SAFETY AND RELIEF VALVES FOR ALL CLOSED WATER SYSTEMS. PIPE RELIEF TO NEAREST FLOOR DRAIN. PROVIDE WATTS 174A VALVES RATED AT 1035 KPA [150 PSIG] AT 99°C [210°F] ASTM RATED, CAST IRON BODY BRONZE.

DISC AND SEAT, STEEL SPINDLE ASSEMBLY, CARBON STEEL SPRING.

PROVIDE STRAINERS UPSTREAM OF EACH PUMP AND WHERE INDICATED ON DRAWINGS. STRAINERS SHALL BE BRONZE BODY TYPE WITH SCREWED CONNECTIONS, STAINLESS STEEL SCREENS WITH 1.6 MM [1/16 IN.] PERFORATIONS AND CAPABLE OF SYSTEM PRESSURE OF 860 KPA [125 PSI].

AUTOMATIC AIR VENTS AND COLLECTING CHAMBERS SPIRAX 13W SHALL BE PROVIDED AT ALL HIGH POINTS OF PIPING SYSTEM. ENSURE RATINGS ARE COMPATIBLE WITH SYSTEM PRESSURE.

INSULATION SHALL BE PROVIDED TO MATCH BASE BUILDING STANDARDS OR REFER TO INSULATION SECTION.

FLUSH CLEAN AND PRESSURE TEST ALL HVAC PIPING SYSTEMS. CHEMICALLY CLEAN ALL PIPING SYSTEMS UTILIZING LOW FOAMING CHEMICAL DETERGENTS WHICH SHALL NOT ADVERSELY AFFECT SYSTEM COMPONENTS.

WATER BALANCING SHALL BE PROVIDED FOR ALL WATER SYSTEMS AND SHALL INCLUDE A WRITTEN REPORT INDICATING TEMPERATURE, FLOW RATES, OPERATING PRESSURES AND PRESSURE DIFFERENTIAL BETWEEN THE SUPPLY AND RETURN AT EACH PIECE OF EQUIPMENT.

PERFORM PRESSURE TESTING ON ALL NEW AND MODIFIED PIPES TO ENSURE TIGHTNESS OF ALL NEW JOINTS USING HYDROSTATIC TEST AT 150% OF DESIGN WORKING PRESSURE BUT NOT LESS THAN 700KPA (100 PSI). TEST WITHOUT PRESSURE DROP FOR MIN. 4 HOURS AND REMOVE AND REPLACE DEFECTIVE PARTS AND COMPONENTS THAT WILL NOT WITHSTAND PRESSURE.

CHEMICAL TREATMENT

MK SERVICES AND CONSULTING TO SUPPLY AND INSTALL ALL COMPONENTS, FLUIDS, ACCESSORIES, ETC. ASSOCIATED WITH CHEMICAL TREATMENT FOR THE PROJECT. CONTACT KRISTEN RILEY (KRISTENRILEY@MKSERVICESANDCONSULTING.COM).

AFTER COMPLETION OF FLUSH CLEANING AND PRESSURE TESTING, CHEMICALLY CLEAN ALL PIPING SYSTEMS UTILIZING LOW FOAMING CHEMICAL DETERGENTS WHICH SHALL NOT ADVERSELY AFFECT SYSTEM COMPONENTS.

PROVIDE EACH CLOSED SYSTEM WITH A 7.6 LITRE [2 US GAL] CAPACITY BY-PASS CHEMICAL FEEDER. PIPE ACROSS PUMPING SYSTEM AND LOCATE NOT MORE THAN (1M) [3 FT.] ABOVE FLOOR. PIPE TO FLOOR DRAIN, USING 20MM [3/4"] PIPE C/W BALL VALVES. PROVIDE FEEDERS WITH PRESSURE RATING SUITABLE FOR THE SYSTEM WORKING PRESSURE.

TO COMPENSATE FOR INITIAL LOSSES OF CHEMICALS AND WATER DURING STARTUP OF SYSTEM, PROVIDE TWICE AS MUCH CORROSION INHIBITOR AND BIOCIDE AS ARE NECESSARY TO TREAT SYSTEMS.

Maintain chemical levels from the time the system is filled after cleaning, up to substantial performance of the contract.

The water treatment specialist shall supply all necessary supervision during installation and shall check the systems during construction.

Provide a service program from a specialist with the water treatment supplier/contractor for a period of one year from substantial completion. Include initial water analysis and recommendations, service startup training of operating personnel, and laboratory and technical assistance.

Provide service visits as required to stabilize and commission the systems and a minimum of one visit per month by the water treatment specialist for the year following substantial completion to ensure that a proper treatment program is maintained. Perform corrosion tests to verify performance requirements are being achieved. Document recommendations and submit a written report to the owner's representative after each visit.

REFRIGERANT PIPING

ACCEPTABLE INSULATION MANUFACTURERS ARE OWENS CORNING CANADA, JOHNS MANVILLE, MANSION INSULATION INC. KNAUF FIBER GLASS AND CERTAINTEED.

PROVIDE INSULATION AND COVERS IN STRICT ACCORDANCE WITH AUTHORITIES GOVERNING COMBUSTIBILITY AND FIREPROOFING OF MATERIALS AND IN ACCORDANCE WITH MANUFACTURER'S RECOMMENDATIONS.

PROVIDE NON-COMBUSTIBLE INSULATION JACKETS AND FINISHES HAVING A FLAME SPREAD/SMOKE DEVELOPED RATING OF 25/50 OR LESS, MEETING CAN/ULC S-102 REQUIREMENTS.

ATTACH A COMPLETE AND CONTINUOUS VAPOUR BARRIER OVER INSULATION APPLIED TO COLD AND DUAL TEMPERATURE PIPING, SHEET METAL AND EQUIPMENT. USE EITHER FACTORY APPLIED VAPOUR BARRIER JACKET OF FIELD APPLIED REINFORCED FOIL FLAME RESISTANT KRAFT VAPOUR BARRIER JACKET. APPLY TO PIPING/FITTINGS, VALVES AND INLINE COMPONENTS, SHEET METAL AND FITTINGS AND EQUIPMENT. SEAL LONGITUDINAL AND CIRCUMFERENTIAL LAPS WITH CHILDERNS CP82 OR BAKOR 230-39 ADHESIVE. IF VAPOUR BARRIER JACKET IS NOT LAPPED, SEAL JOINTS WITH SELF-ADHERING 4" WIDE PLAIN ALUMINUM FOIL TAPE, OR ADHERE 4" WIDE ALUMINUM FOIL TAPE WITH CHILDERNS CP82 OR BAKOR 230-39 ADHESIVE. JACKETING WITH SELF-ADHESIVE LAPS AND SELF-ADHESIVE BARRIER TAPE WILL BE AN ACCEPTABLE ALTERNATIVE CLOSURE SYSTEM.

PROVIDE INSULATION MATERIALS WITH A MINIMUM THERMAL CONDUCTIVITY OF 0.24BTU/IN.(HR. SQ.FT²) AT 100°F MEAN TEMPERATURE.

ON HOT PIPING APPLICATIONS, HOLD INSULATION IN PLACE WITH FLARE TYPE STAPLES (OUTWARD CLINCH).

ON COLD PIPING APPLICATIONS, APPLY VAPOUR BARRIER JACKET OVER INSULATION AND SEAL LONGITUDINAL AND CIRCUMFERENTIAL LAPS WITH CHILDERNS CP82 OR BAKELITE 230-39 ADHESIVE. SEAL ALL PIPE TERMINATIONS, INCLUDING FITTINGS, WALL PENETRATIONS AND PIPE SUPPORTS WITH VAPOUR BARRIER MASTIC. FOR CHILLED WATER SYSTEMS PROVIDE VAPOUR SEAL PIPE TERMINATIONS EVERY FOUR PIPE SECTIONS.

APPLY PIPE INSULATION OVER 1-1/2" THICKNESS IN TWO LAYERS WITH JOINTS STAGGERED.

INSULATE FITTINGS WITH FABRICATED MITERED OR PREFORMED SECTIONS OF SPECIFIED INSULATION.

INSULATE OVER FLANGES AND MECHANICAL COUPLINGS WITH SPECIFIED INSULATION AND THICKNESS, SIZED TO SUIT FLANGE DIAMETERS. FILL SPACES BETWEEN INSULATION AND ADJOINING PIPE INSULATION WITH SIMILAR MATERIAL.

INSULATE VALVES AND INLINE COMPONENTS WITH FLEXIBLE INSULATION DENSITY (3/4 LBS./CU.FT.) COMPRESSED NOT MORE THAN 50% OF ORIGINAL THICKNESS. BUILD UP TO SPECIFIED THICKNESS WITH APPROVED ASBESTOS FREE FINISHING CEMENT.

DO NOT INSULATE TERMINAL UNIT AUTOMATIC CONTROL VALVES INSTALLED IN HOT PIPING. DO NOT INSULATE TERMINAL UNIT AUTOMATIC CONTROL VALVES WHICH ARE INSTALLED IN COLD PIPING AND WHICH ARE LOCATED OVER CONDENSATE DRAIN PANS.

UNDER ALL HANGERS USED ON CHILLED WATER AND DOMESTIC COLD WATER, PROVIDE AN INSERT BETWEEN SUPPORT SHIELD AND PIPING 1-1/2" OR LARGER.

PROVIDE THE FOLLOWING PIPE INSULATION TYPE AS INDICATED IN THE PIPE INSULATION TABLE BELOW.

"TYPE P1" OWENS CORNING 850 PIPE INSULATION, JOHNS MANVILLE MICRO-LOK AP-T PLUS FIBERGLAS PIPE INSULATION, MANSION FIBERGLAS PIPE INSULATION OR KNAUF PIPE INSULATION WITH FACTORY APPLIED ALL PURPOSE VAPOUR BARRIER JACKET WHERE SCHEDULED.

| DUTY | INSULATION TYPE | THICKNESS | VAPOUR BARRIER |
|--------------------------------|-----------------|-----------|----------------|
| BUILDING HOT WATER 2" AND LESS | P-1 | 1" | NO |
| 2-1/2" AND LARGER | P-1 | 1-1/2" | NO |

| HORIZONTAL CONDENSATE DRAINS ALL PIPE SIZES | P-1 | 1/2" | YES |
|---|-----|------|-----|
| REFRIGERANT SUCTION PIPE ALL SIZES | P-1 | 1" | YES |

| SHEET METAL INSULATION | P-1 | 1" | YES |
|---|-----|----|-----|
| PROVIDE INSULATION WITH A MINIMUM THERMAL RESISTANCE OF 0.25 BTU/IN.HR. SQ.FT AT 75°F MEAN TEMPERATURE. | | | |

APPLY VAPOUR BARRIER OVER INSULATION ON COLD TEMPERATURE DUCTWORK - FOR NEW AND EXISTING DUCTWORK.

CIRCULAR SILENCERS AND ACOUSTIC PLenums NEED NOT BE EXTERNALLY INSULATED.

DUCTWORK AND CASINGS LINED WITH ACOUSTIC INSULATION 1" OR MORE IN THICKNESS NEED NOT BE EXTERNALLY INSULATED.

PROVIDE THE FOLLOWING DUCTWORK INSULATION TYPE AS INDICATED IN THE DUCTWORK INSULATION TABLE BELOW.

"TYPE D1" OWENS CORNING RIGID VAPOUR SEAL DUCT INSULATION, JOHN MANSVILLE 814 SPIN-GLAS WITH FSK FACING, MANSION SPIN-GLAS RIGID INSULATING BOARD WITH REINFORCED FOIL FACING, OR KNAUF RIGID INSULATION BOARD WITH FSK FACING. DENSITY SHALL BE NOT LESS THAN 3.0LBS./CU.FT. IMPALE ON MECHANICALLY FASTENED PINS LOCATED AT NOT GREATER THAN 12" CENTERS. SECURE WITH SPEED WASHERS. BUTT JOINTS TIGHTLY TOGETHER AND SEAL WASHERS, BREAKS AND JOINTS WITH SELF-ADHERING 4" WIDE PLAIN ALUMINUM TAPE, OR ADHERE FOIL WITH CHILDERNS CP82 OR BAKELITE 230-39 ADHESIVE.

"TYPE D2" OWENS CORNING FLEXIBLE DUCT INSULATION, JOHNS MANVILLE MICROLITE TYPE 75 DUCT WRAP, MANSION MICROLITE INSULATION OR KRAFT DUCT WRAP, (3/4LB./CU.FT.) DENSITY WITH FACTORY APPLIED REINFORCED FOIL FACING. ADHERE INSULATION TO DUCT SURFACE WITH CHILDERNS CP82 OR BAKELITE 230-39 ADHESIVE, WHICH SHALL BE APPLIED IN STRIPS 6" WIDE AT NOT GREATER THAN 12" CENTERS. BUTT EDGES OF INSULATION TIGHTLY TOGETHER, AND SEAL BREAKS AND JOINTS OF FACING WITH SELF-ADHERING 4" WIDE ALUMINUM TAPE OR ADHERE FOIL WITH CHILDERNS CP82 OR BAKELITE 230-39 ADHESIVE.

| DUTY | INSULATION TYPE | THICKNESS | VAPOUR BARRIER |
|---|-----------------|-----------|----------------|
| PANELS BEHIND UNUSED PORTION OF LOUVRES | D-1 | 2" | YES |

| FINAL 10' OF EXHAUST DUCT BEFORE EXITING BUILDING | D-1 | 1" | YES |
|---|-----|----|-----|
| EXPOSED DUCTWORK | D-1 | 1" | YES |

| DUCTWORK OUTSIDE OF BUILDING OR EXPOSED TO WEATHER | D-1 | 2" | YES |
|--|-----|----|-----|
| | | | |

CONCEALED DUCTWORK UP TO TERMINAL CONTROL UNITS D-2 1" YES

CONCEALED DUCTWORK FROM AIR TERMINAL CONTROL UNIT DISCHARGE TO AIR TERMINALS EXCLUDING FLEXIBLE DUCTWORK. D-2 1" YES

PROTECT THE WORK OF THIS TRADE FROM BEING DEFACED BY OTHER TRADES. MAKE GOOD ANY DAMAGE AND LEAVE IN PERFECT CONDITION, READY FOR FINAL PAINTING.

APPLY INSULATION OVER CLEAN DRY SURFACES, FIRMLY BUTTING ALL SECTIONS TOGETHER.

FIRE PROTECTION SYSTEM

SYSTEM SHALL BE IN COMPLIANCE WITH NFPA, GOVERNING AUTHORITIES, AODA AND OWNER'S/LANDLORD'S INSURANCE UNDERWRITER. ALL COMPONENTS SHALL BE ULC LISTED.

CONTROLS

EXISTING CONTROLS WITHIN SCHOOL IS RELIABLE CONTROLS. CONTACT ADRIAN CECCHETTO (ADRIAN@SETPOINT.CA) AT SETPOINT BUILDING AUTOMATION INC. RE: CONTROLS WORK.

MOUNTING HEIGHT SHALL BE 1200 MM [4 FT. 0 IN.] FROM FINISHED FLOOR. COORDINATE LOCATION WITH DDSB. DO NOT INSTALL IN VICINITY OF ELECTRICAL LIGHTING DIMMERS.

COORDINATE FINAL LOCATION OF THERMOSTATS WITH DDSB WITHIN 100MM (40 IN) OF LOCATION SHOWN. ALL RELOCATIONS OUTSIDE OF THIS RANGE SHALL BE REVIEWED WITH THE CONSULTANT.

CLEAN AND RECALIBRATE ALL EXISTING THERMOSTATS UPON COMPLETION OF CONSTRUCTION. SUBMIT REPORT THAT THIS WORK WAS COMPLETED.

PROVIDE ALL NECESSARY EMT CONDUIT, FITTINGS AND WIRE TO PROVIDE A COMPLETE AND OPERATING CONTROL SYSTEM. HARD WIRE ALL ELECTRICAL CONTROL DEVICES INTO THE ASSOCIATED SYSTEM MAGNETIC STARTER. PROVIDE POWER TO CONTROL PANEL FROM THE NEAREST NORMAL POWER ELECTRICAL DISTRIBUTION PANEL.

REVISIONS / STATUS

| | | | |
|-----|-------------------------|----|----------|
| 02 | ISSUED FOR MECH ADD-001 | ME | 12/23/25 |
| 01 | ISSUED FOR TENDER | ME | 12/17/25 |
| No. | DESCRIPTION | BY | DATE |

| | | | |
|-----|-------------------------|----|----------|
| 02 | ISSUED FOR MECH ADD-001 | ME | 12/23/25 |
| 01 | ISSUED FOR TENDER | ME | 12/17/25 |
| No. | DESCRIPTION | BY | DATE |

PROJECT: VAUGHAN WILLARD P.S. - AHU REPLACEMENT

Project No: 25-14

| | |
|-------------|----------|
| Scale: | AS NOTED |
| Drawn by: | GPC |
| Checked by: | ME |

Address: 1911 Dixie Rd N, Pickering, ON L1V 1V4

TITLE: SPECIFICATIONS

DRAWING No:

| HEAT EXCHANGER SCHEDULE | | | | | | | | | | | | | | | | | |
|---|----------------|-------|---------------|-----------|-----|-----|------|-------------|-------|-----|-----|--------|-------------|------------------|---------|----|------------------------------|
| TAG | MANUFACTURER | MODEL | TYPE | COLD SIDE | | | | HOT SIDE | | | | WEIGHT | CAPACITY | NUMBER OF PLATES | REMARKS | | |
| | | | | FLUID | EFT | LFT | FLOW | PRESS. DROP | FLUID | EWT | LWT | FLOW | PRESS. DROP | LBS | MBH | | |
| HX-2 | BELL & GOSSETT | AP19 | PLATE & FRAME | 35% P.G. | 140 | 160 | 60 | 3.6 | WATER | 170 | 150 | 57 | 3.5 | 510 | 561,758 | 30 | PLATE MATERIAL TO BE 304 S/S |
| BASIS OF DESIGN: XYLEM-BELL GOSSETT. ACCEPTABLE ALTERNATES: ARMSTRONG, ALFA LAVAL | | | | | | | | | | | | | | | | | |

| CONDENSER UNIT SCHEDULE | | | | | | | | | | | | | | | |
|-------------------------|----------|---------|--------------|---------|------------------|--------------------|----------------------------|------------|-----|------|------|--------|---------|--|--|
| TAG | LOCATION | SERVICE | MANUFACTURER | MODEL | REFRIGERANT TYPE | REFRIGERANT CHARGE | TOTAL REFRIGERATION EFFECT | ELECTRICAL | FLA | MCA | MOPC | WEIGHT | REMARKS | | |
| | | | | | | | | | | | | | | | |
| CDU-1 | ROOF | AHU-1 | DAIKIN | RCS020D | R410A | 18.5 | 263,672 | 208/3/60 | | 93.5 | 125 | 1,695 | | | |

| COOLING COIL SCHEDULE | | | | | | | | | | | | | | | | | |
|-----------------------|--------------|------------------|--------------|----------|---------|--------------------------|-----------|------------------|-----------------------|---------|----------|-------------|-------------|----------|-----|------|---|
| TAG | LOCATION | SERVICE | MANUFACTURER | MODEL | AIRFLOW | EXTERNAL STATIC PRESSURE | FAN MOTOR | MIN. OUTSIDE AIR | COOLING | | | | ELECTRICAL | FLA | MCA | MOPC | REMARKS |
| | | | | | | | | | TYPE | TOTAL | SENSIBLE | EAT (DB/WB) | LAT (DB/WB) | | | | |
| AHU-1 (EXISTING) | MECH RM. 169 | NORTH CLASSROOMS | ENG. AIR | EXISTING | 8,500 | EXISTING | | 4,250 | PACKAGED DX HEAT PUMP | 263,000 | 196,000 | 77.5/65 | 56.4/54.8 | EXISTING | | | AHU-1 IS AN EXISTING UNIT WITH PROVISION FOR FUTURE DX COOLING COIL WHICH IS TO BE INSTALLED DURING THIS PROJECT SCOPE. |





| AHU SCHEDULE | | | | | | | | | | | | | | | | | | | | |
|--------------|--------------|---------|--------------|-----------|---------|--------------------------|-----------|------------------|-------------------------|----------|-----------|-------------|------------|------|-----|------|----------|---------|--|-------|
| TAG | LOCATION | SERVICE | MANUFACTURER | MODEL | AIRFLOW | EXTERNAL STATIC PRESSURE | FAN MOTOR | MIN. OUTSIDE AIR | HEATING | | | | ELECTRICAL | FLA | MCA | MOPC | WEIGHT | REMARKS | | |
| | | | | | | | | | HOT WATER HEAT CAPACITY | FLUID | FLOW RATE | PRESS. DROP | EAT | LAT | EWT | LWT | | | | |
| AHU-4 | MECH RM. 201 | GYM | DAIKIN | CAH008GHD | 4,500 | 1 | 3 | 2,200 | 224,600 | 35% P.G. | 24.1 | 5 | 34 | 81.7 | 160 | 140 | 575/3/60 | 3,4 | | 1,300 |

| TAG | LOCATION | SERVICE | MANUFACTURER | MODEL | DISCHARGE | RETURN | AIRFLOW | EXTERNAL STATIC PRESSURE | SUPPLY FAN MOTOR | VFD | MIN. OUTSIDE AIR | EXTERNAL STATIC PRESSURE | EXHAUST FAN MOTOR | TYPE | COOLING | | | HEATING (FROM HEAT PUMP) | | | REHEAT COIL (IN MECH. RM.) | | | ELECTRICAL | FLA | MCA | MOPC | WEIGHT | REMARKS | | | | | | | | | | |
|---|
| | | | | | | | | | | | | | | | TOTAL | SENSIBLE | EAT (DB/WB) | LAT (DB/WB) | AMBIENT AIR TEMP | TOTAL CAPACITY | REFRIGERANT | EAT | LAT | AMBIENT AIR TEMP | TAG | HOT WATER HEAT CAPACITY | FLUID | FLOW RATE | PRESS. DROP | EAT | LAT | EWT | LWT | | | | | | |
| RTU-3 | ROOF | SOUTH CLASSROOMS | DAIKIN | DPSH20B | HORIZONTAL | HORIZONTAL | 6,800 | 1.5 | 7.5 | YES | 2,800 | 0.5 | 4.3 | PACKAGED DX HEAT PUMP | 234,141 | 179,115 | 81.2/67.7 | 55.3/55.3 | 95 | 233,000 | R32 | 70 | 100.6 | 47 | RHC-RTU-3 | 337,450 | 35% P.G. | 34.8 | 13.4 | 41 | 86.4 | 160 | 140 | 575/3/60 | 47.3 | 51.4 | 60 | 3,870 | 24" ROOF CURB FOR RTU. HOT WATER REHEAT COIL TO BE LOCATED IN MECH. RM. 201 |

| EXPANSION TANK SCHEDULE | | | | | | | | | | | | | | |
|-------------------------|-------------|-------|--------------|-------------------|--------------------|-----------------------|----------|--------|---------|---------|-----|-----|-----|----------|
| TAG | DUTY | MODEL | TANL. VOLUME | ACCEPTANCE VOLUME | FACTORY PRE-CHARGE | MAX. WORKING PRESSURE | DIAMETER | HEIGHT | REMARKS | | | | | |
| | | | | | | | | | US GAL. | US GAL. | PSI | PSI | IN. | IN. |
| ET-1 | GLYCOL LOOP | D-15 | 7.8 | 6.3 | 12 | 125 | 12 | 19 | | | | | | VERTICAL |




BASIS OF DESIGN: BELL AND GOSSETT. ACCEPTABLE ALTERNATES: AMTROL, EXPANFLEX, WATTS

</div

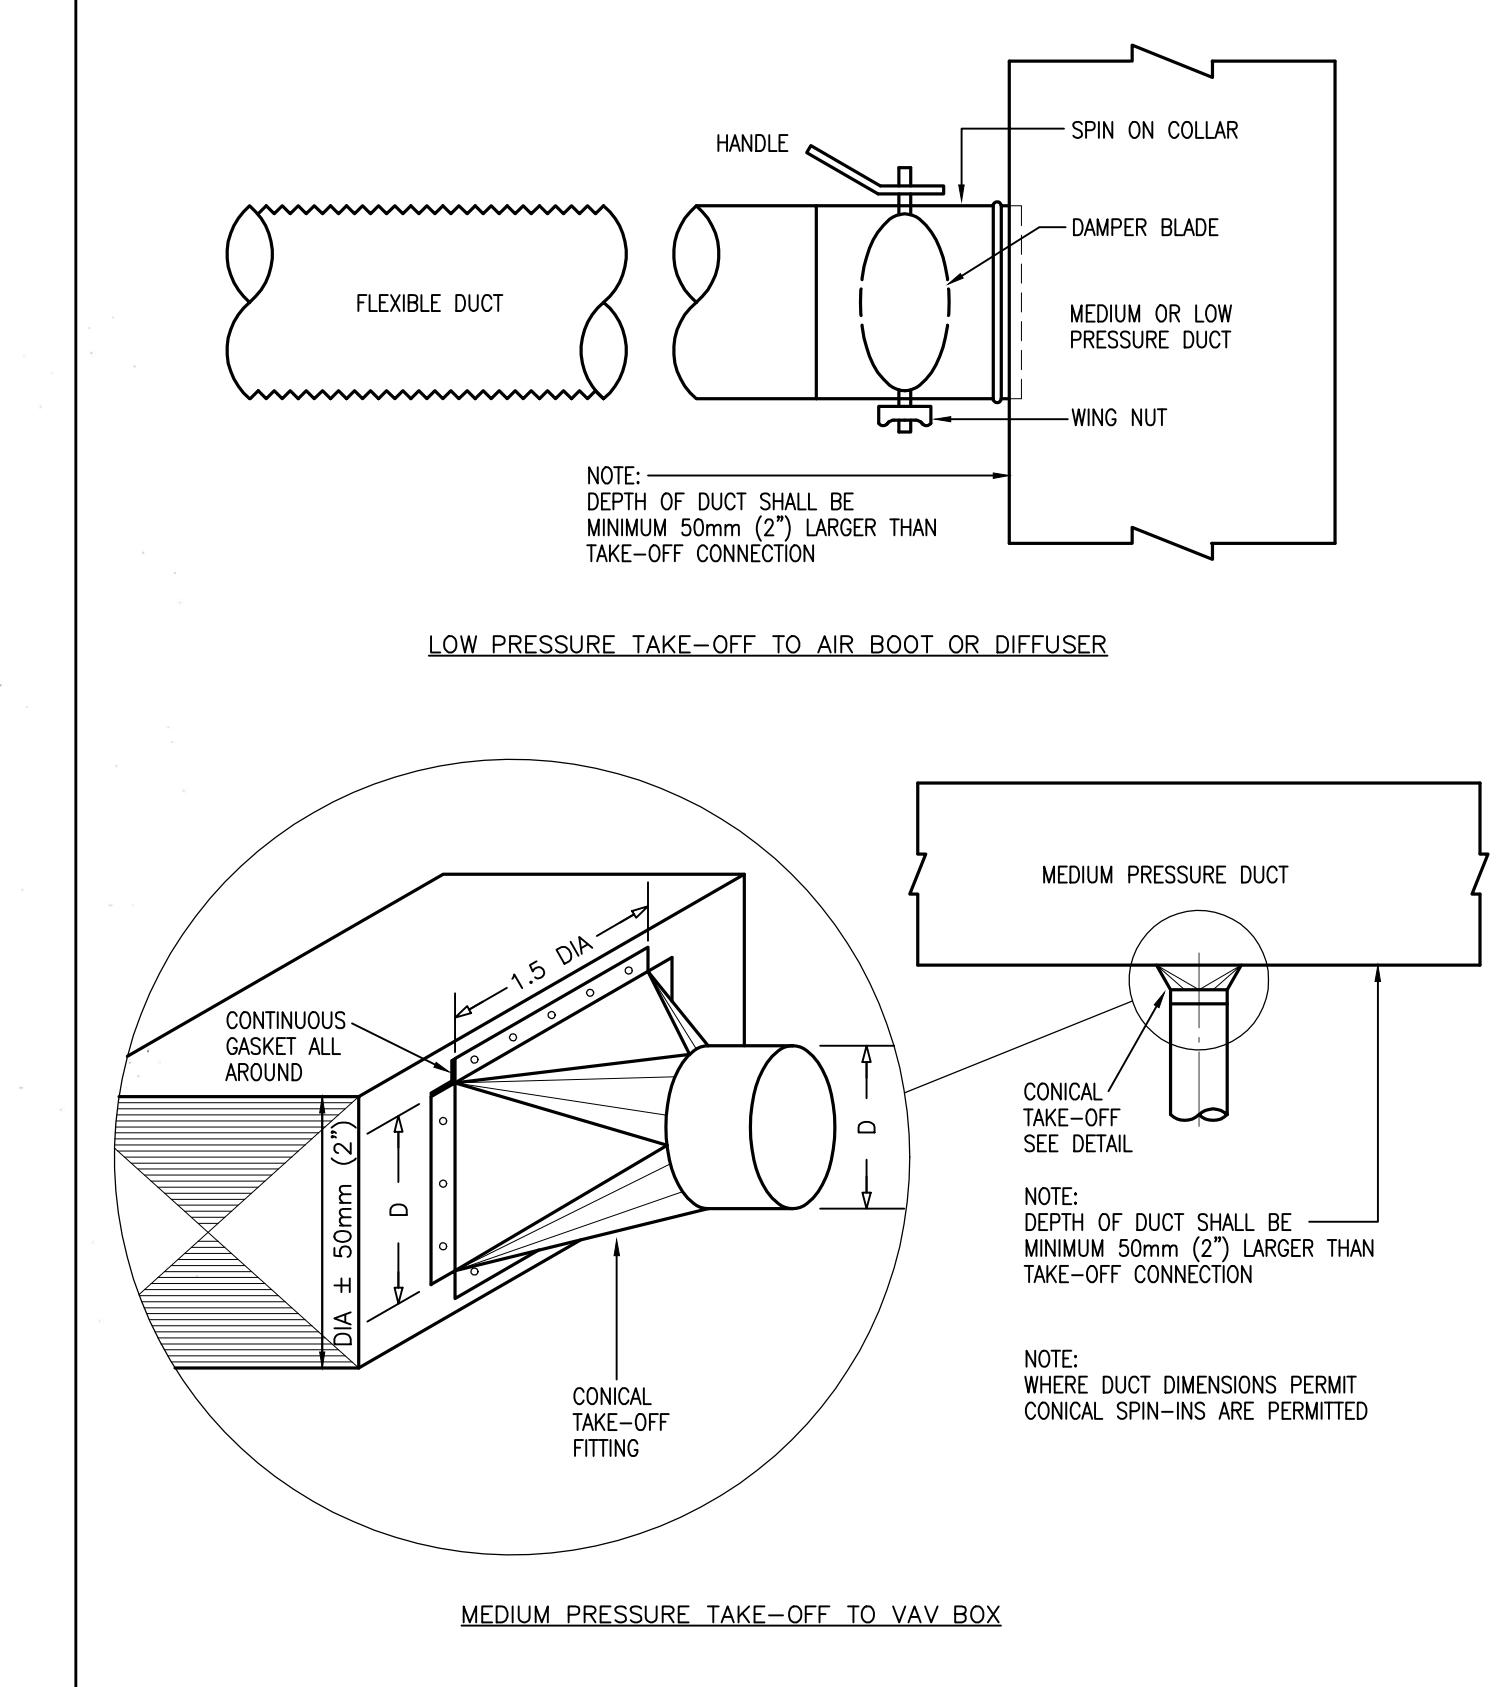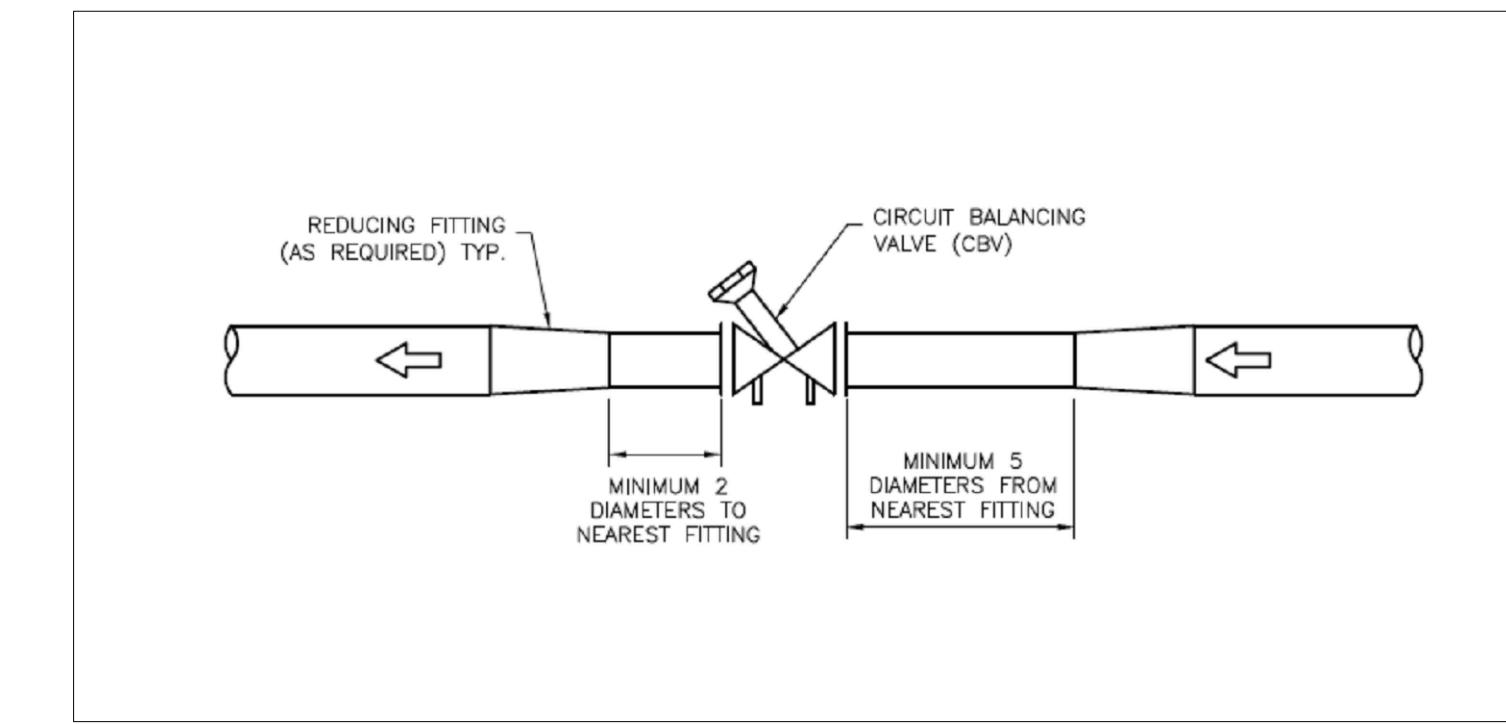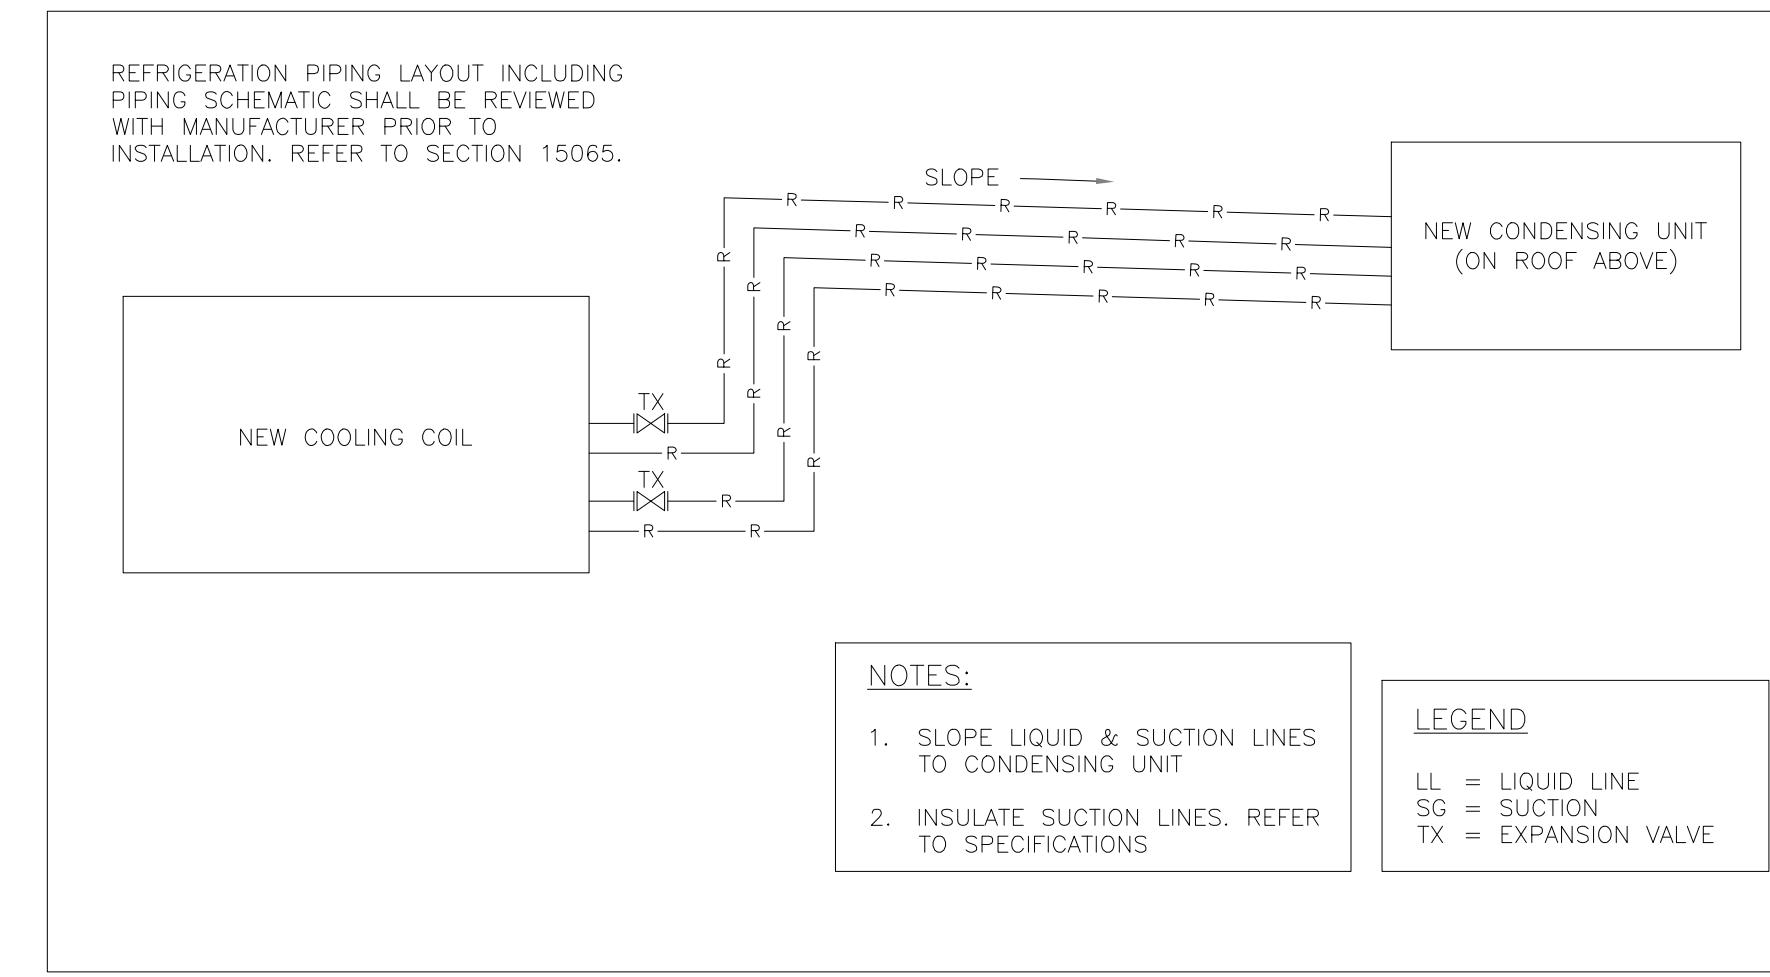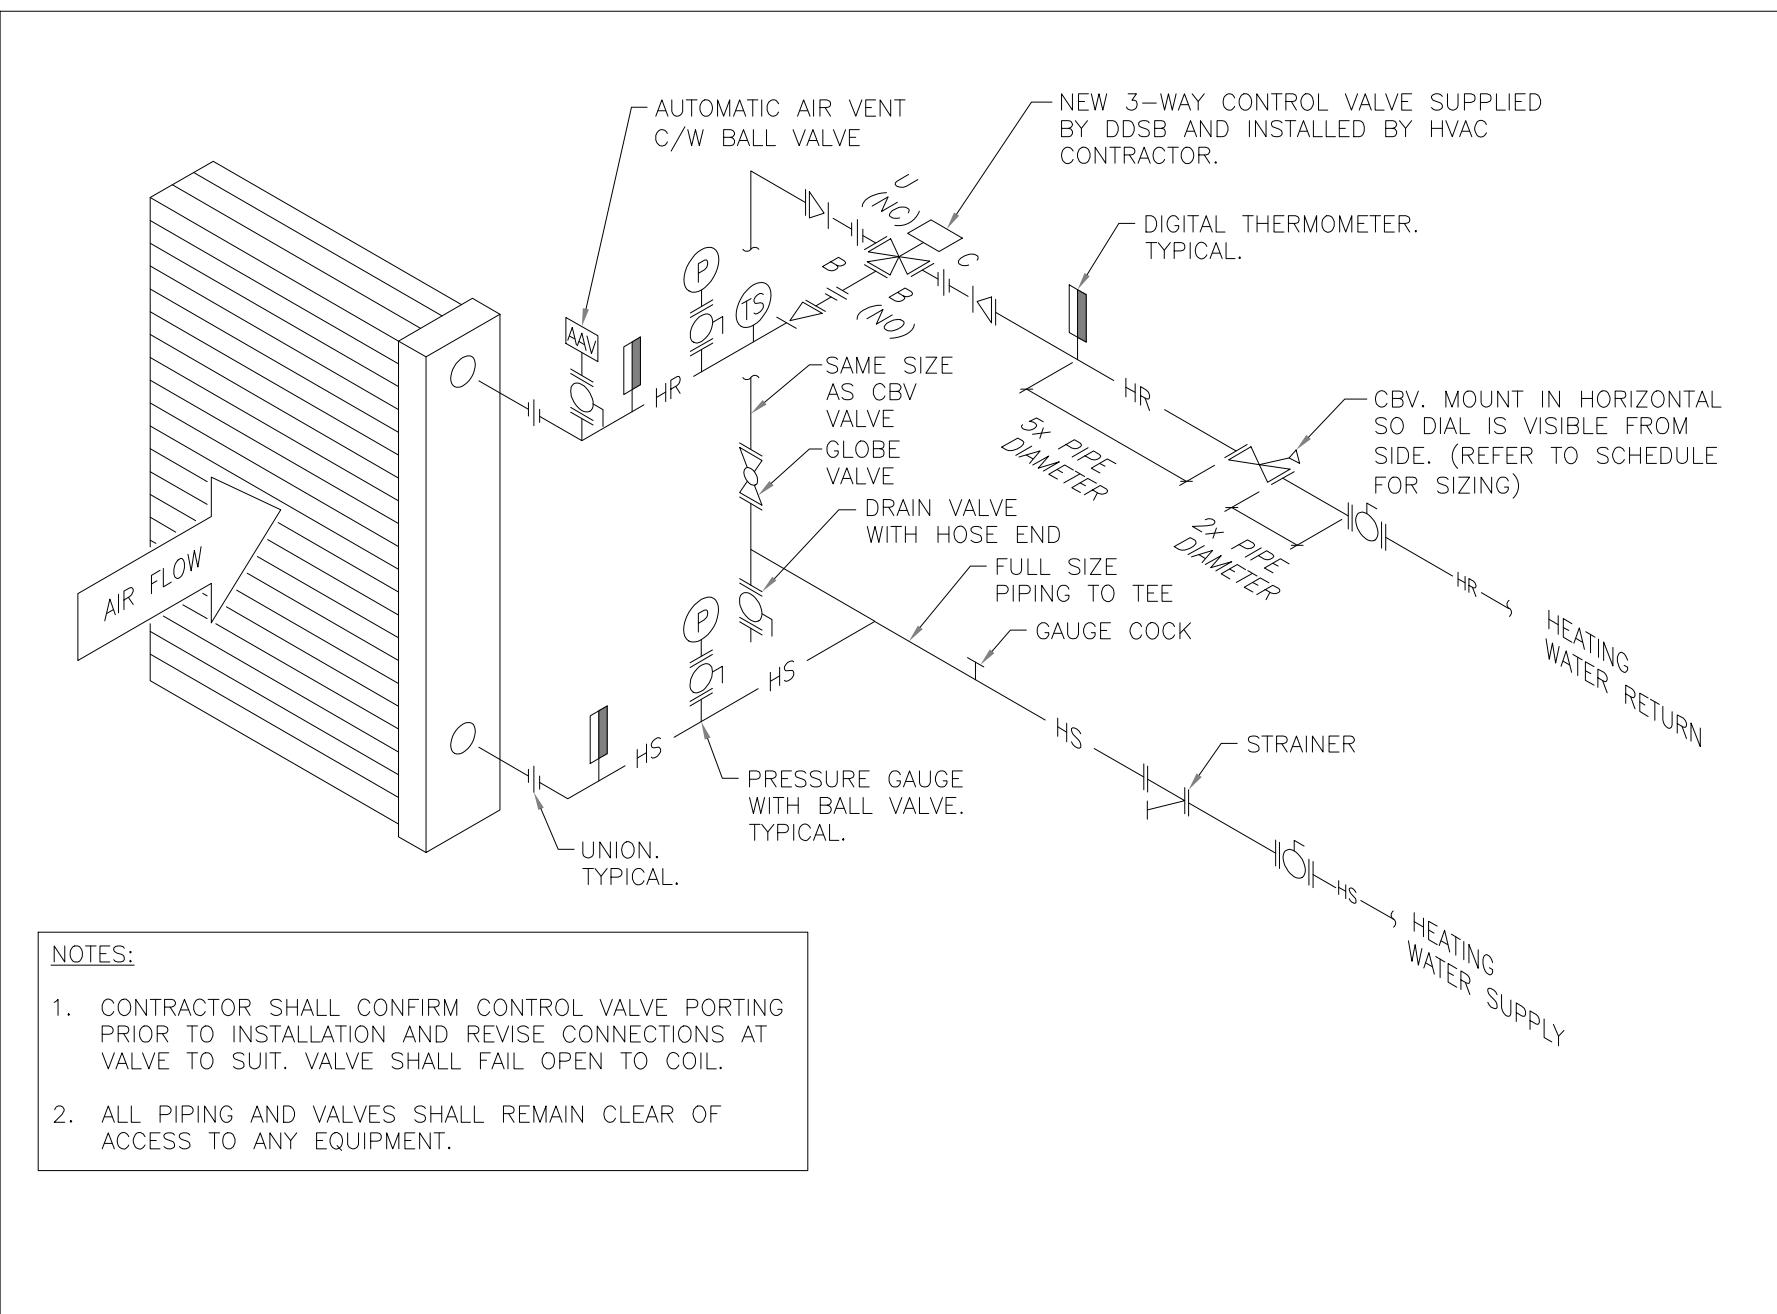

| | | | |
|-----|-------------------------|----|----------|
| 02 | ISSUED FOR MECH ADD-001 | ME | 12/23/25 |
| 01 | ISSUED FOR TENDER | ME | 12/17/25 |
| No. | DESCRIPTION | BY | DATE |

REVISIONS / STATUS

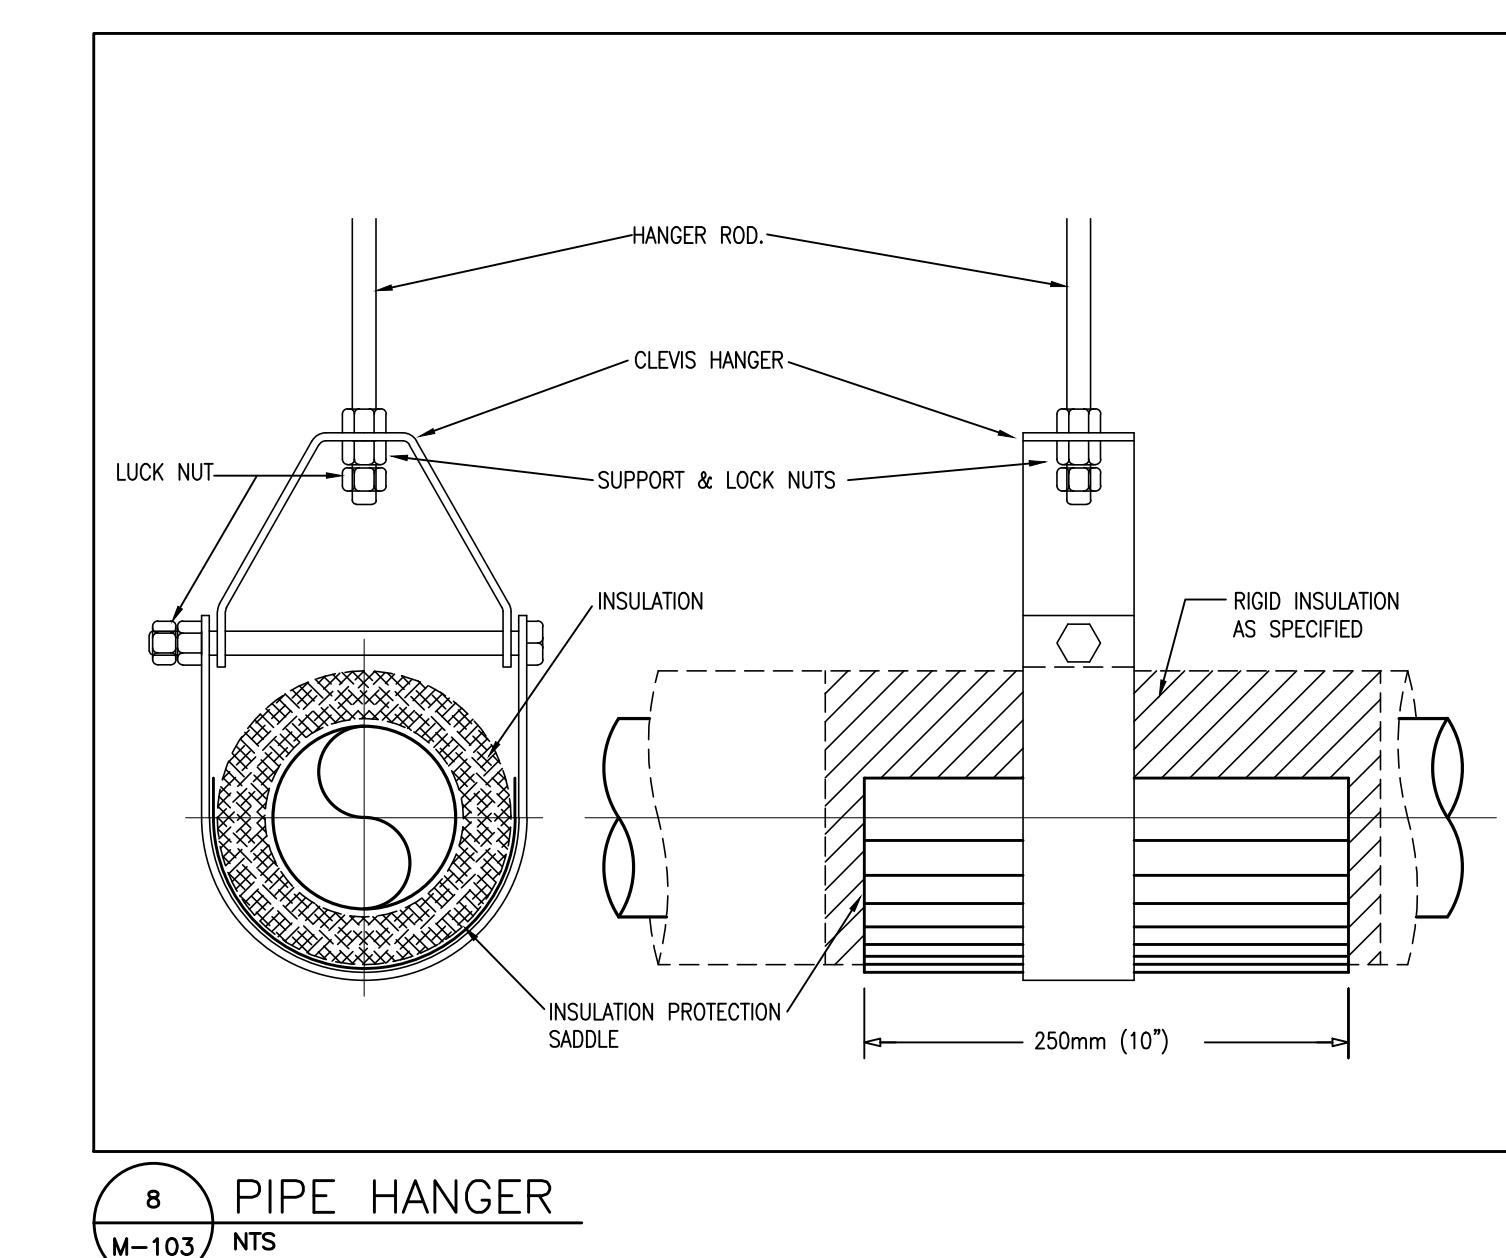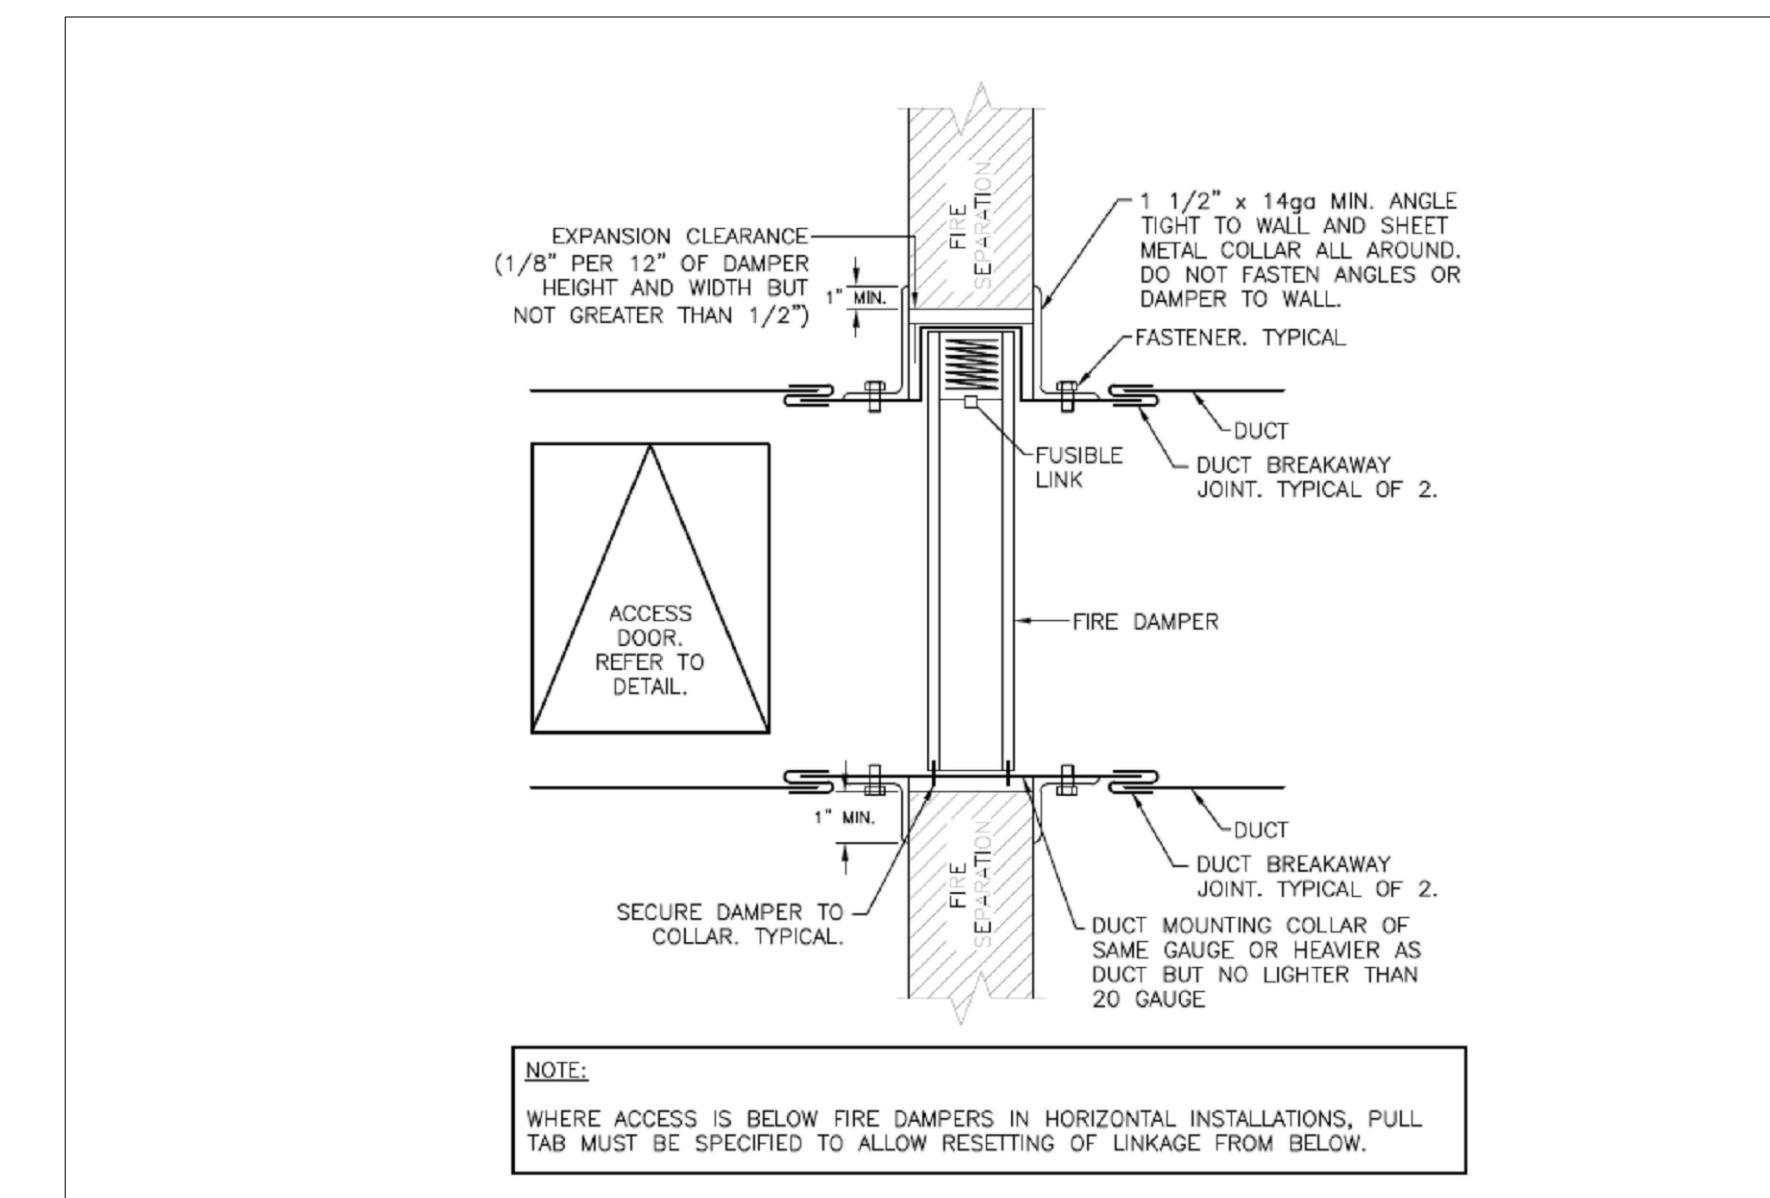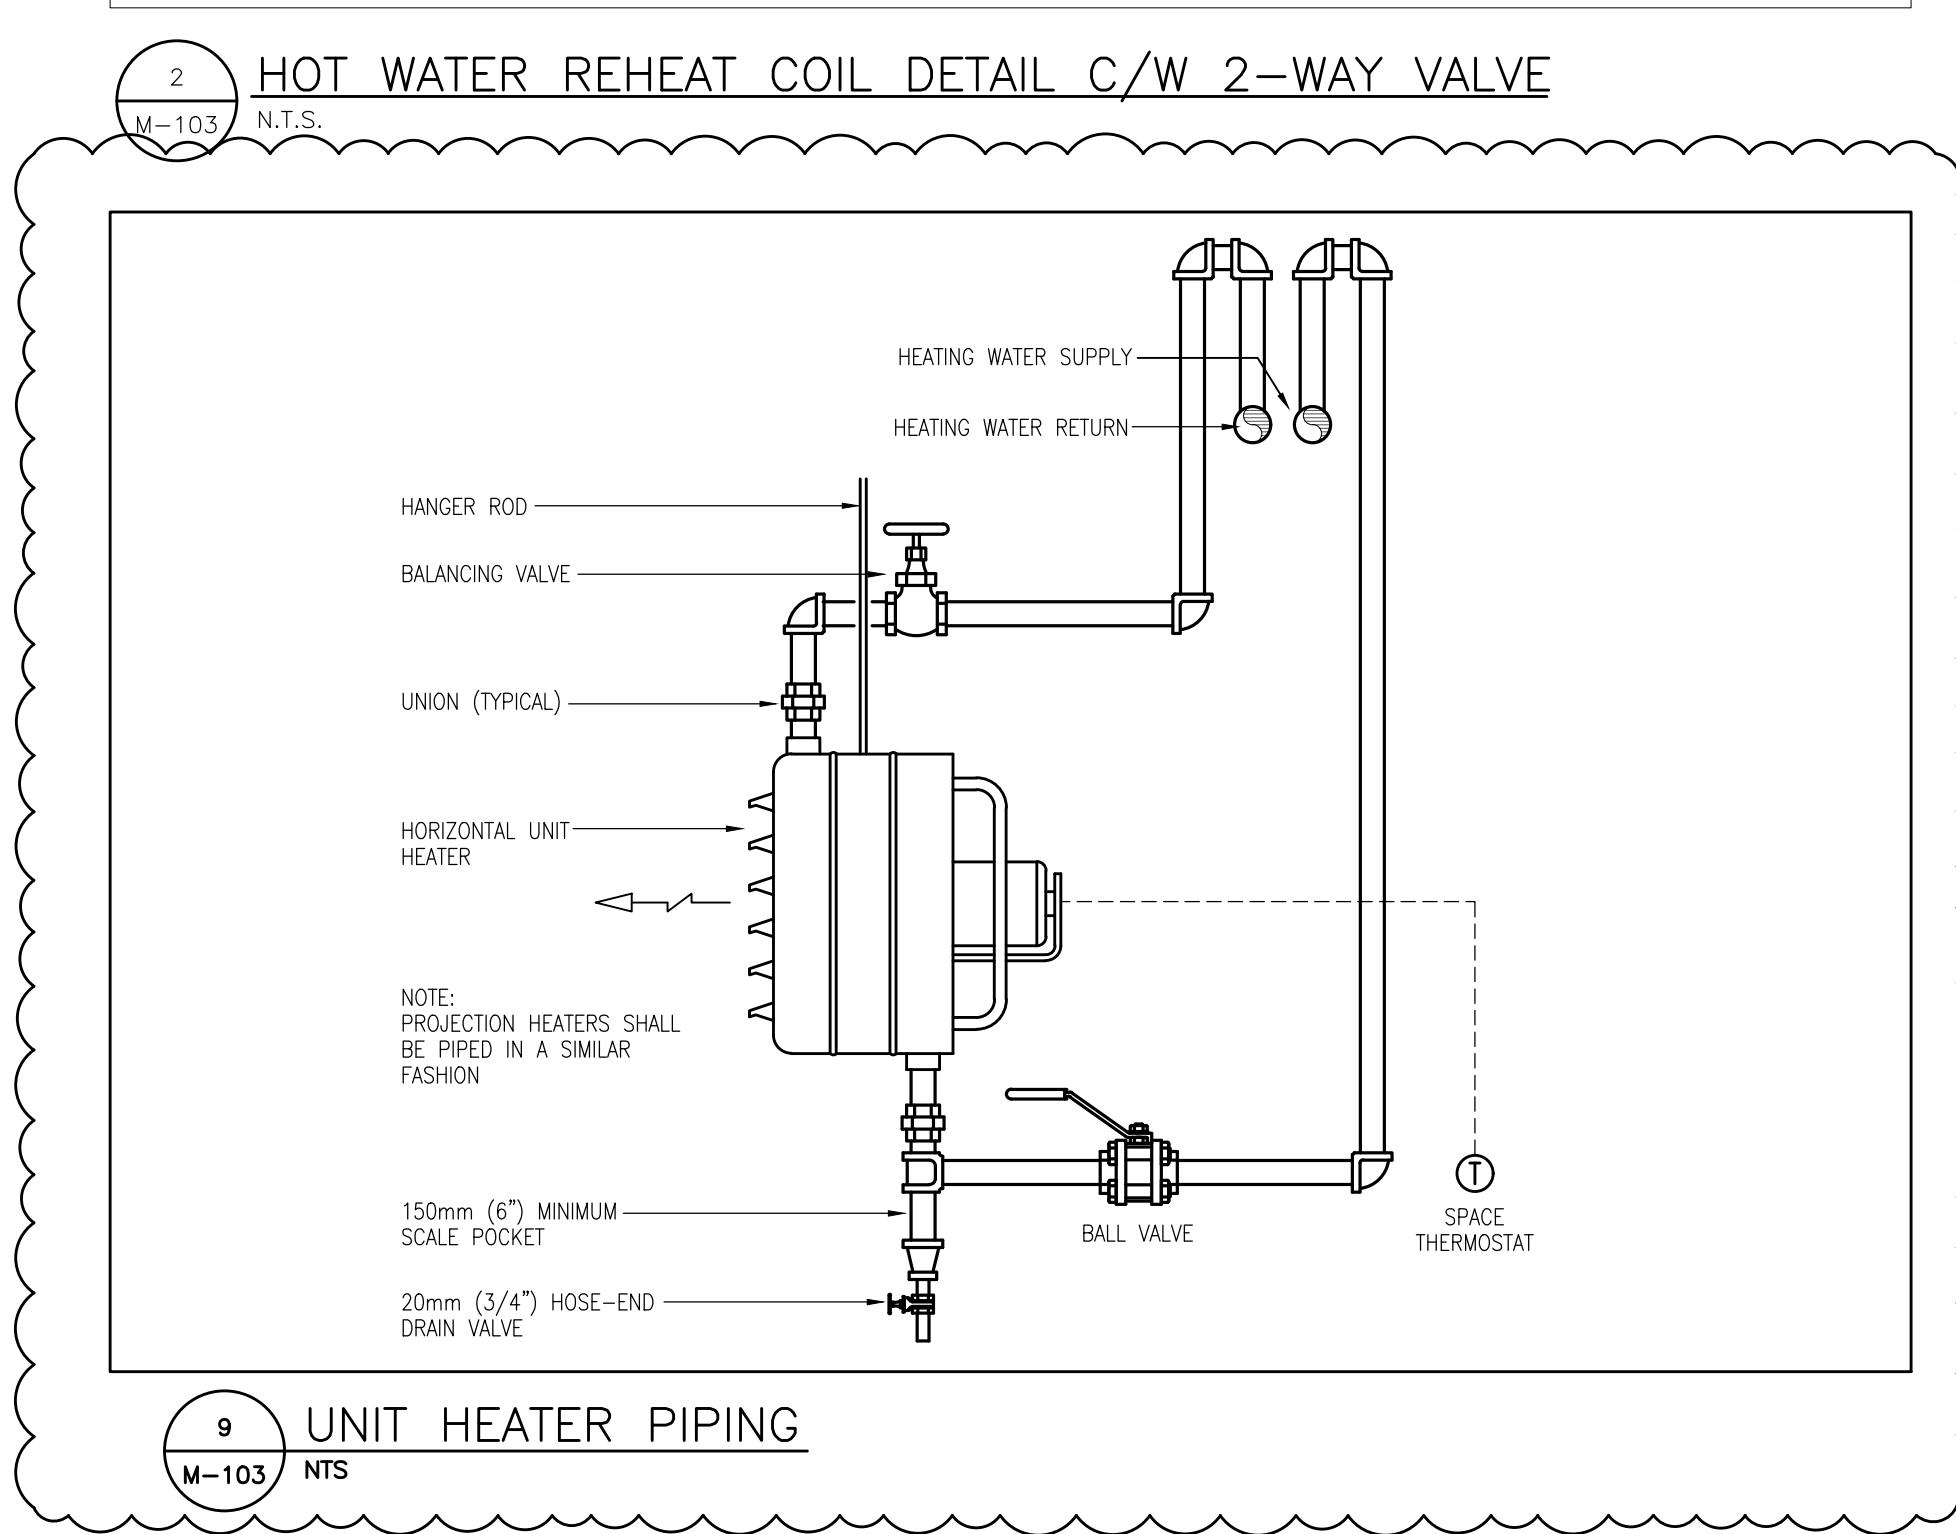



PROJECT:
VAUGHAN WILLARD P.S.
- AHU REPLACEMENT

Project No: 25-14





Scale: AS NOTED
 Drawn by: GPC
 Checked by: ME
 Address: 1911 Dixie Rd N, Pickering, ON L1V 1V4

TITLE:

DETAILS

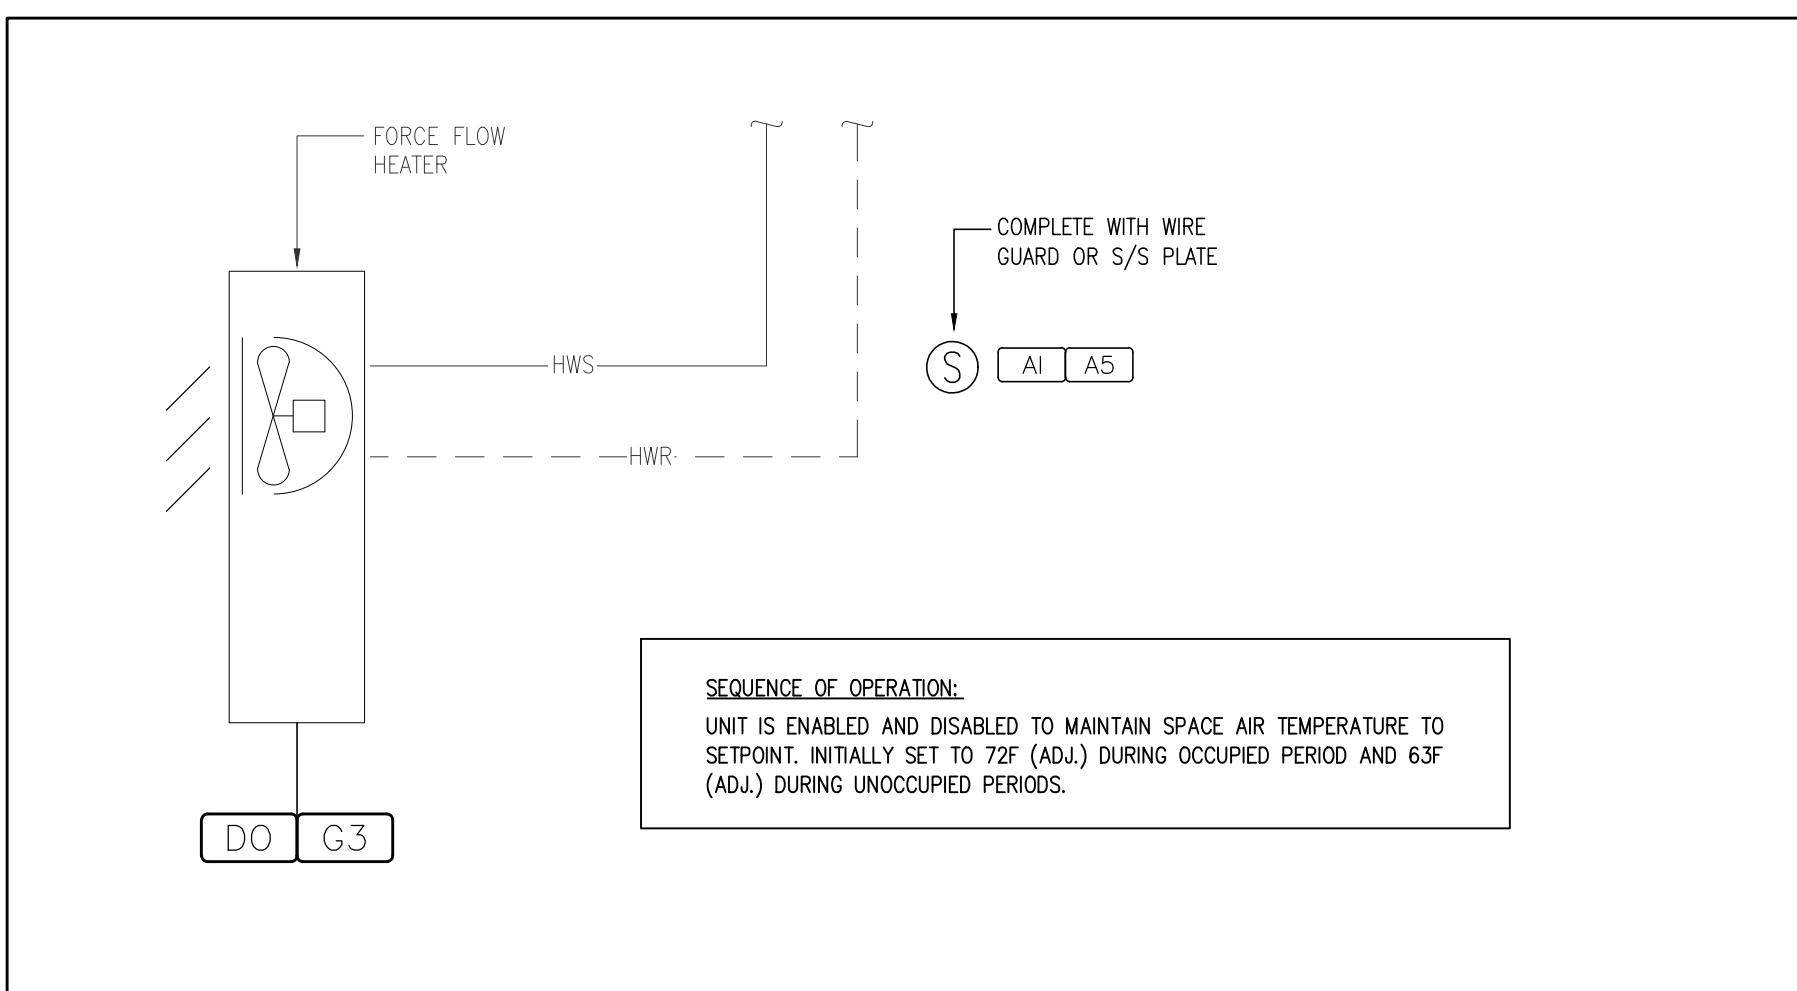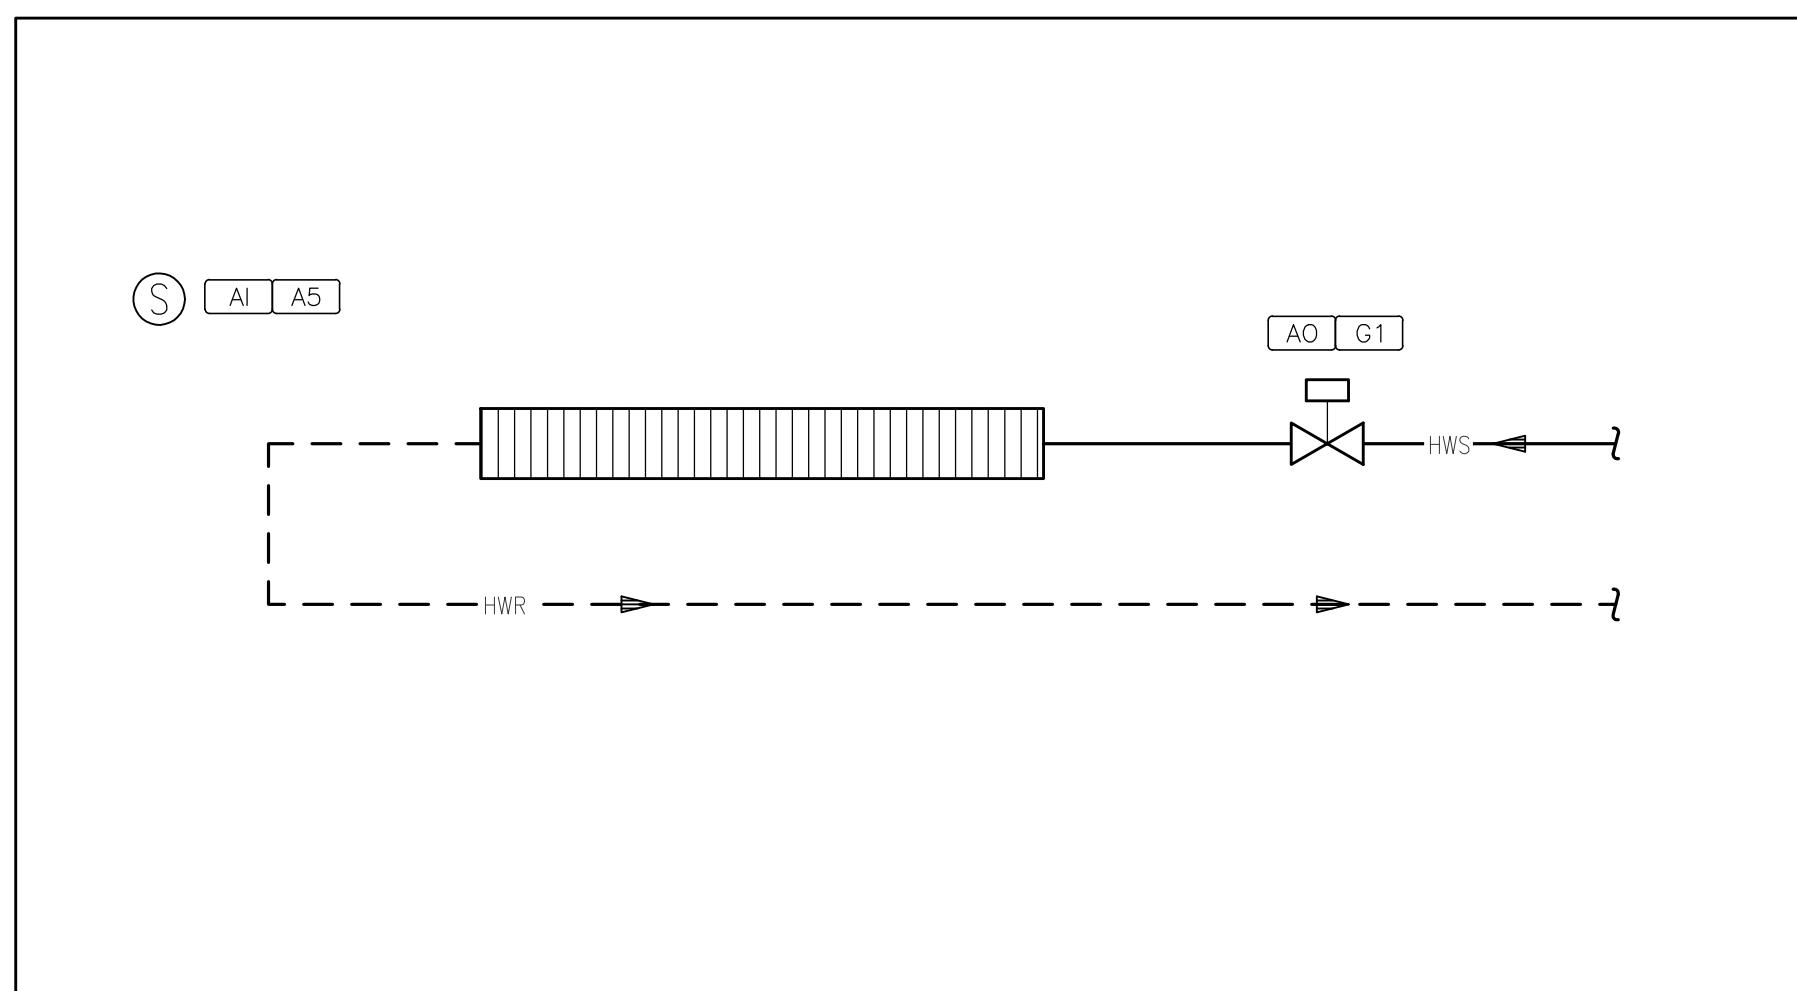

| CONTROL LEGEND | |
|--|---------------|
| SENSOR AND INSTRUMENT CODES | ABBREVIATIONS |
| A1 TEMPERATURE SENSOR, DUCT MOUNTED | AIJ |
| A2 TEMPERATURE SENSOR, DUCT MOUNTED | AI |
| A3 TEMPERATURE SENSOR, AVERAGING ELEMENT | AO |
| A4 TEMPERATURE SENSOR, OUTSIDE AIR TYPE | BAS |
| A5 TEMPERATURE SENSOR, ROOM TYPE | CACF |
| A6 TEMPERATURE SENSOR, LOW LIMIT | CHWS |
| A7 TEMPERATURE SENSOR, HIGH LIMIT | CHWR |
| B1 HUMIDITY SENSOR, DUCT MOUNTED | CLG |
| B2 HUMIDITY SENSOR, ROOM TYPE | CWS |
| B3 HUMIDITY SENSOR, OUTSIDE AIR TYPE | CWR |
| B5 HUMIDITY SENSOR, HIGH LIMIT TYPE | DI |
| C1 DIFFERENTIAL PRESSURE | DO |
| C2 PRESSURE SENSOR | DIP |
| C3 STATIC PRESSURE SENSOR | DS |
| C4 PRESSURE SWITCH | EAT |
| C5 WATER LEVEL SWITCH | EF |
| C6 DAMPER STATUS SWITCH | EWT |
| C7 AIR VOLUME | FPVAV |
| C8 PULSED OUTPUT FROM POWER METER | FCS |
| C9 PULSED OUTPUT FROM WATER METER | FCU |
| C10 EMMERSION HEATER ON/OFF | FS |
| C11 CURRENT SENSOR | HE |
| C12 Co2 SENSOR | HWS |
| C02 CARBON DIOXIDE SENSOR | HWR |
| C0 CARBON MONOXIDE SENSOR | HTG |
| D1 MOTOR CONTROL RELAYS, START/STOP/STATUS TYPE | LL |
| D2 CURRENT TRANSFORMER AND RELAYS | LWT |
| D3 MOTOR STATUS CONTACTS | MAT |
| D4 DIFFERENTIAL PRESSURE SWITCH | MARH |
| D5 LEVEL SWITCH, TANK MOUNTED | MATR |
| D6 LEVEL SWITCH, FLOAT TYPE | RA |
| D7 DIFFERENTIAL PRESSURE TRANSMITTER | RARH |
| D8 CURRENT SENSITIVE RELAY | RAT |
| D9 LEVEL TRANSMITTER | RF |
| D10 WATERFLOW TRANSMITTER, ANNULAR TYPE | RTT |
| K1 WATERFLOW TRANSMITTER, ANNULAR TYPE | SA |
| K2 WATERFLOW TRANSMITTER, TURBINE TYPE | SARH |
| K3 AIRFLOW TRANSMITTER, DIGITRON TYPE | SAT |
| K4 AIRFLOW TRANSMITTER, ANNULAR AIRBAR | SF |
| K5 ENERGY METER, DELTA T AND FLOW | SP |
| K6 GAS DETECTOR | ST |
| F1 INTERFACE CONTACT TO CACF | STS |
| F2 VIBRATION DETECTOR | TUC |
| F3 INTERFACE CONTACT | VAV |
| F4 INTERFACE TO HOOD SUPPRESSION | |
| G1 OUTPUT TO VALVE | |
| G2 OUTPUT TO DAMPER | |
| G3 START/STOP | |
| G4 OUTPUT TO VSD | |
| G5 FAULT INPUT | |
| G6 STATUS | |
| G7 VIBRATION CUT-OFF | |
| G8 ELECTRICAL POWER CONSUMPTION | |
| AO C6 SENSOR CODE | |
| SIGNAL TYPE | |
| S/S/S START/STOP/STATUS RELAYS FOR MOTOR CONTROL | |
| S/S START/STOP RELAYS FOR MOTOR CONTROL | |
| 3-WAY CONTROL VALVE | |
| NORMALLY CLOSED PORT | |
| AO C6 DAMPER CONTROL (AO) WITH DAMPER END SWITCH | |
| WIRE SWITCH TO CACF & STARTER | |
| MONITOR OPEN AND CLOSED POSITION | |
| AO ANALOG OUTPUT TO CONTROLLED DEVICE WITHOUT ADDITIONAL SENSORS | |

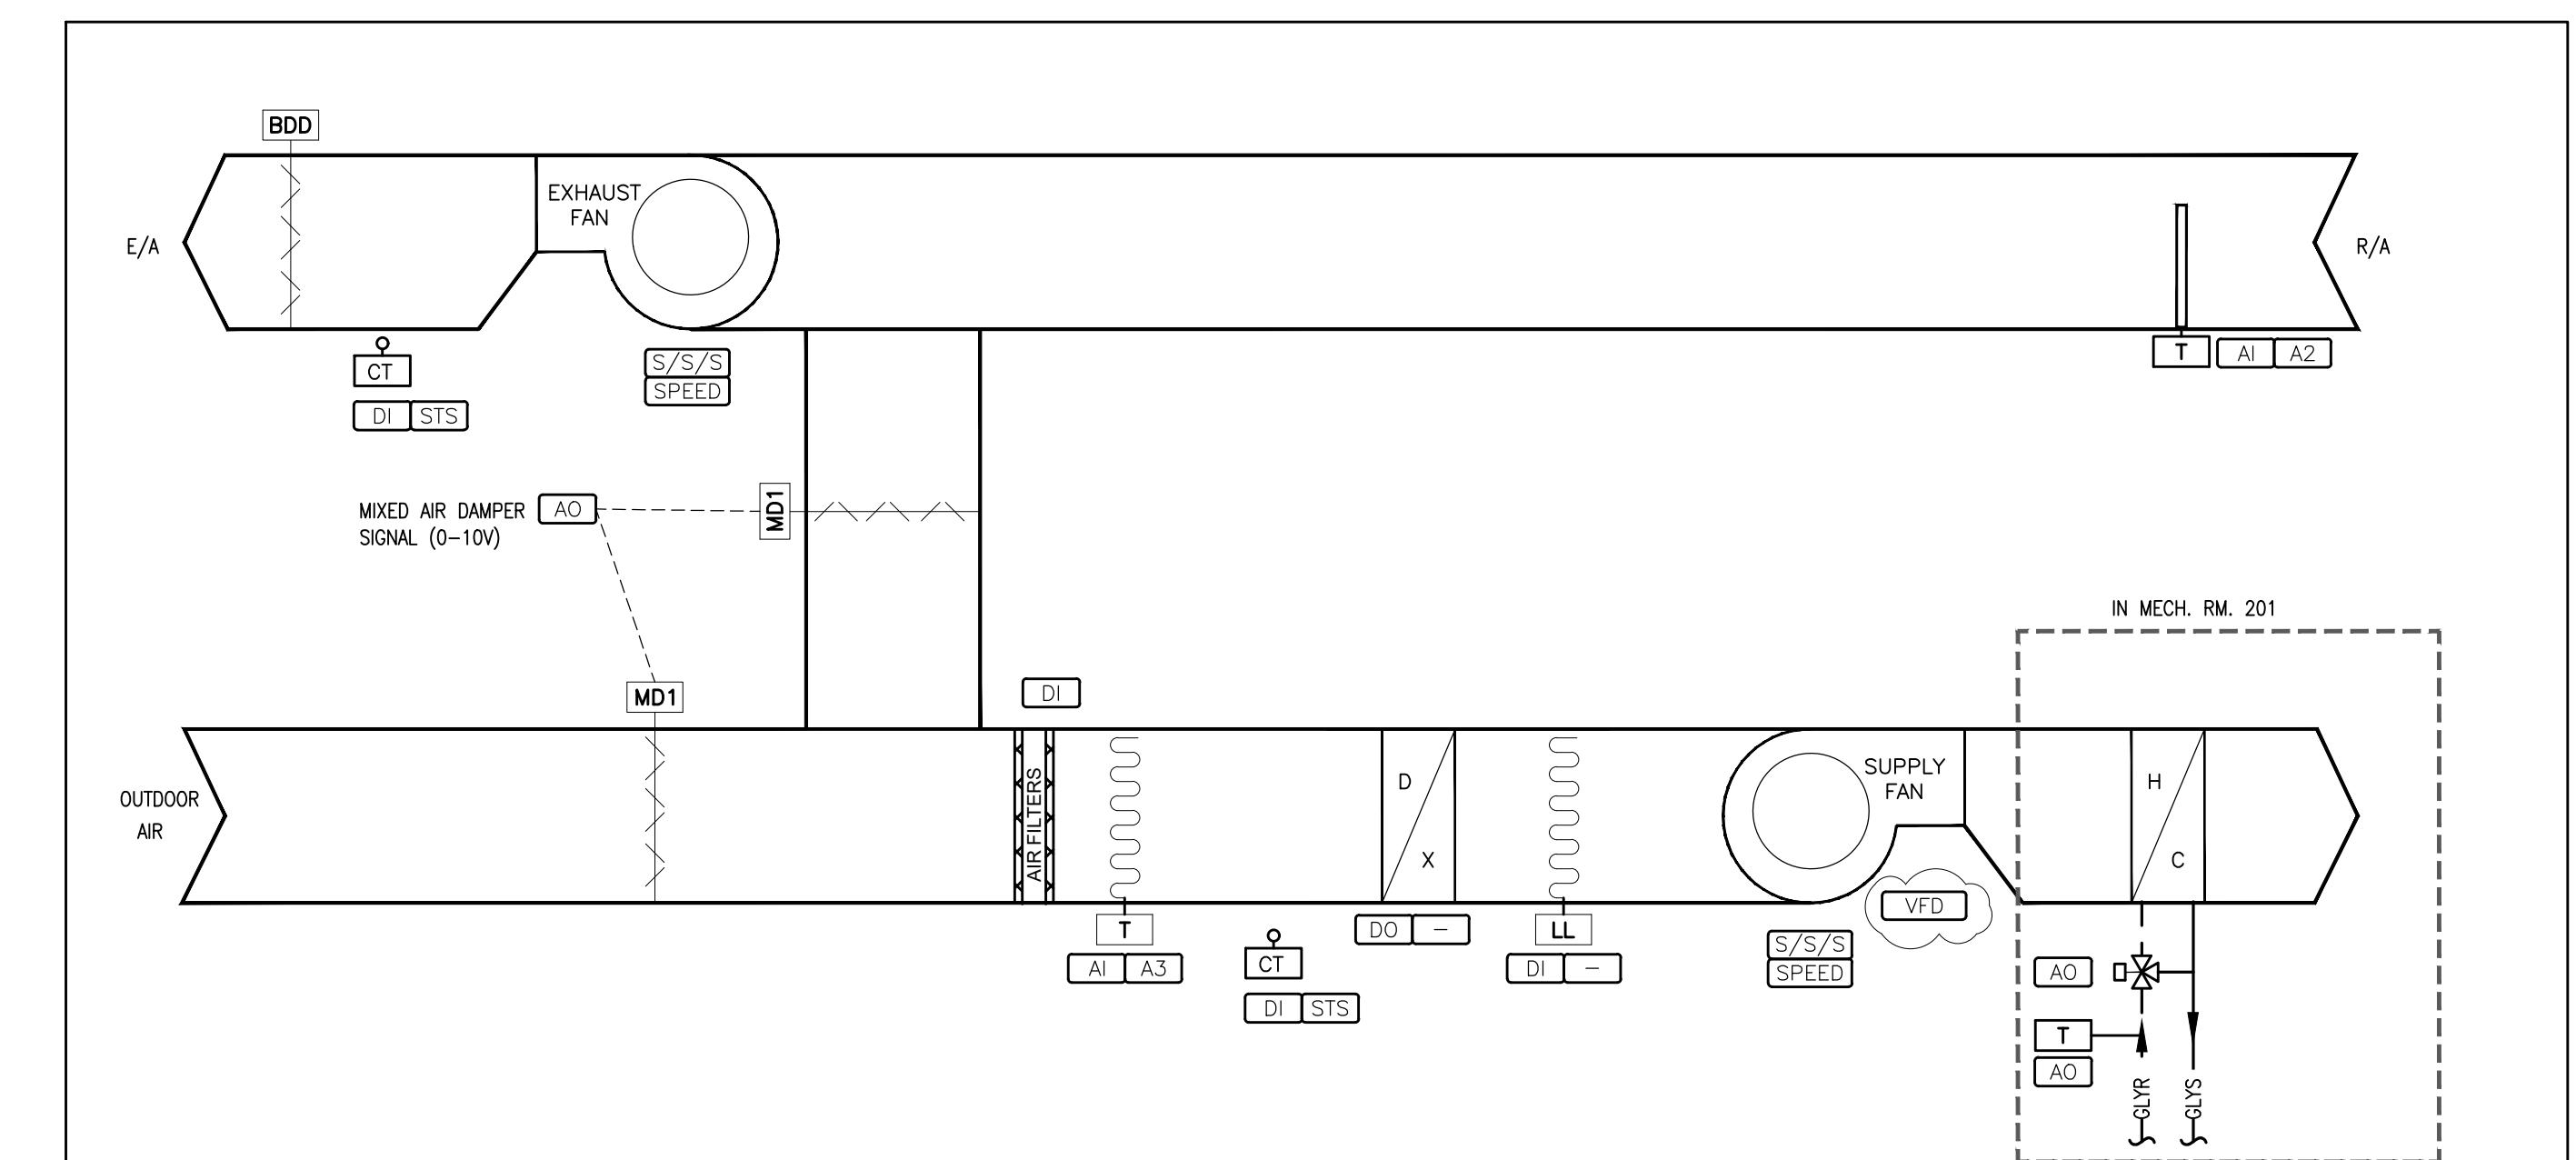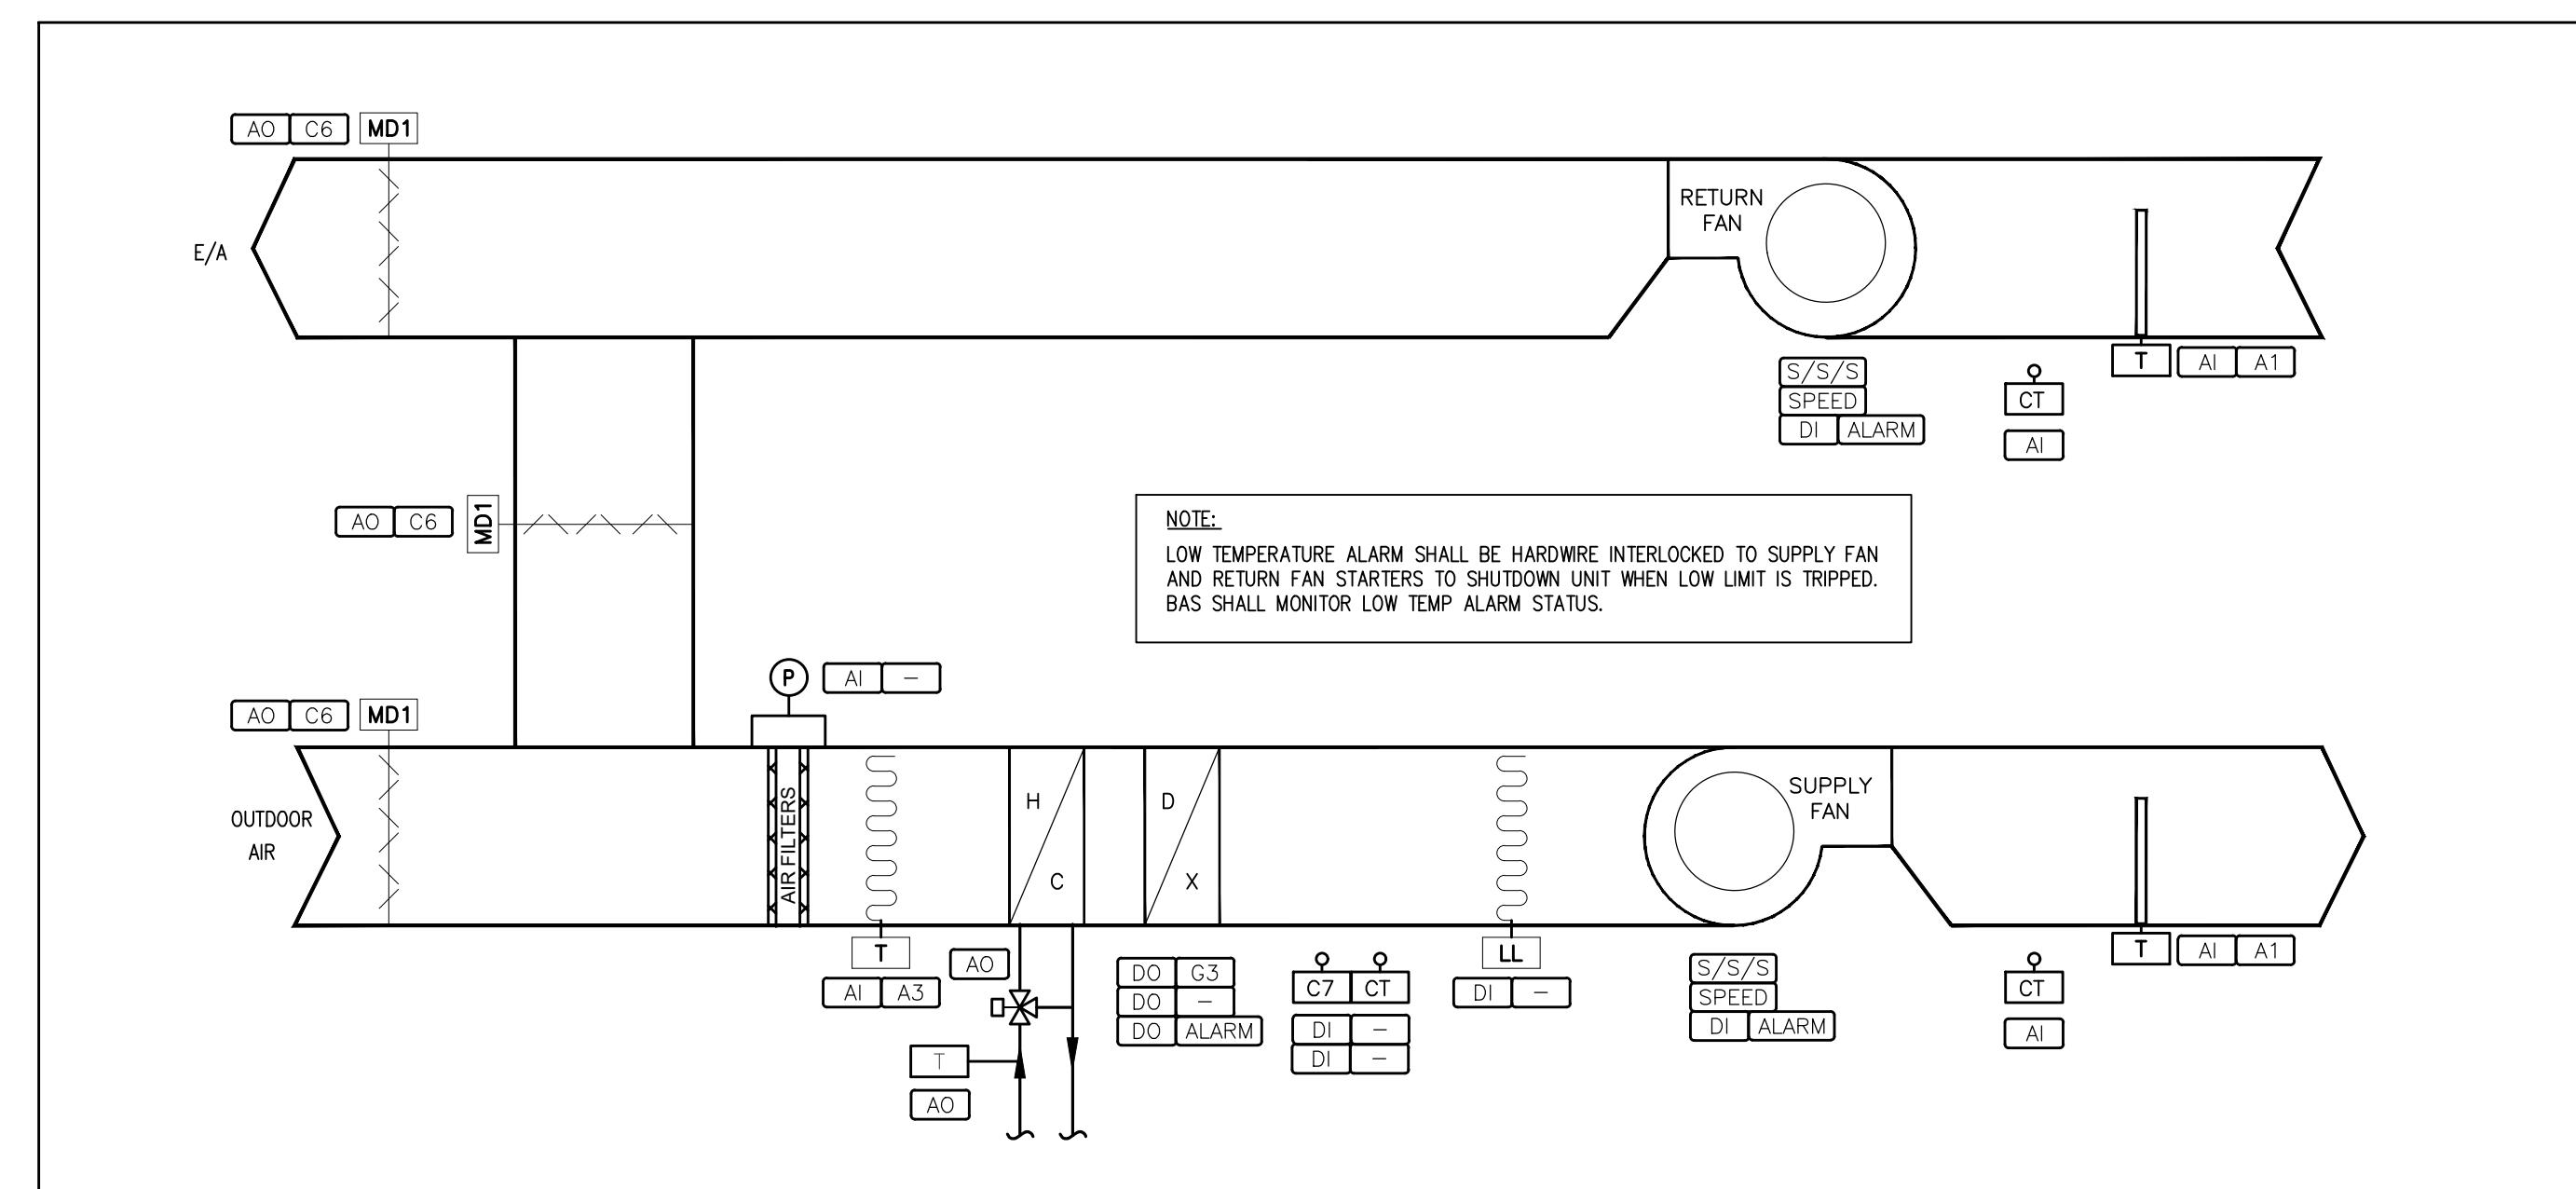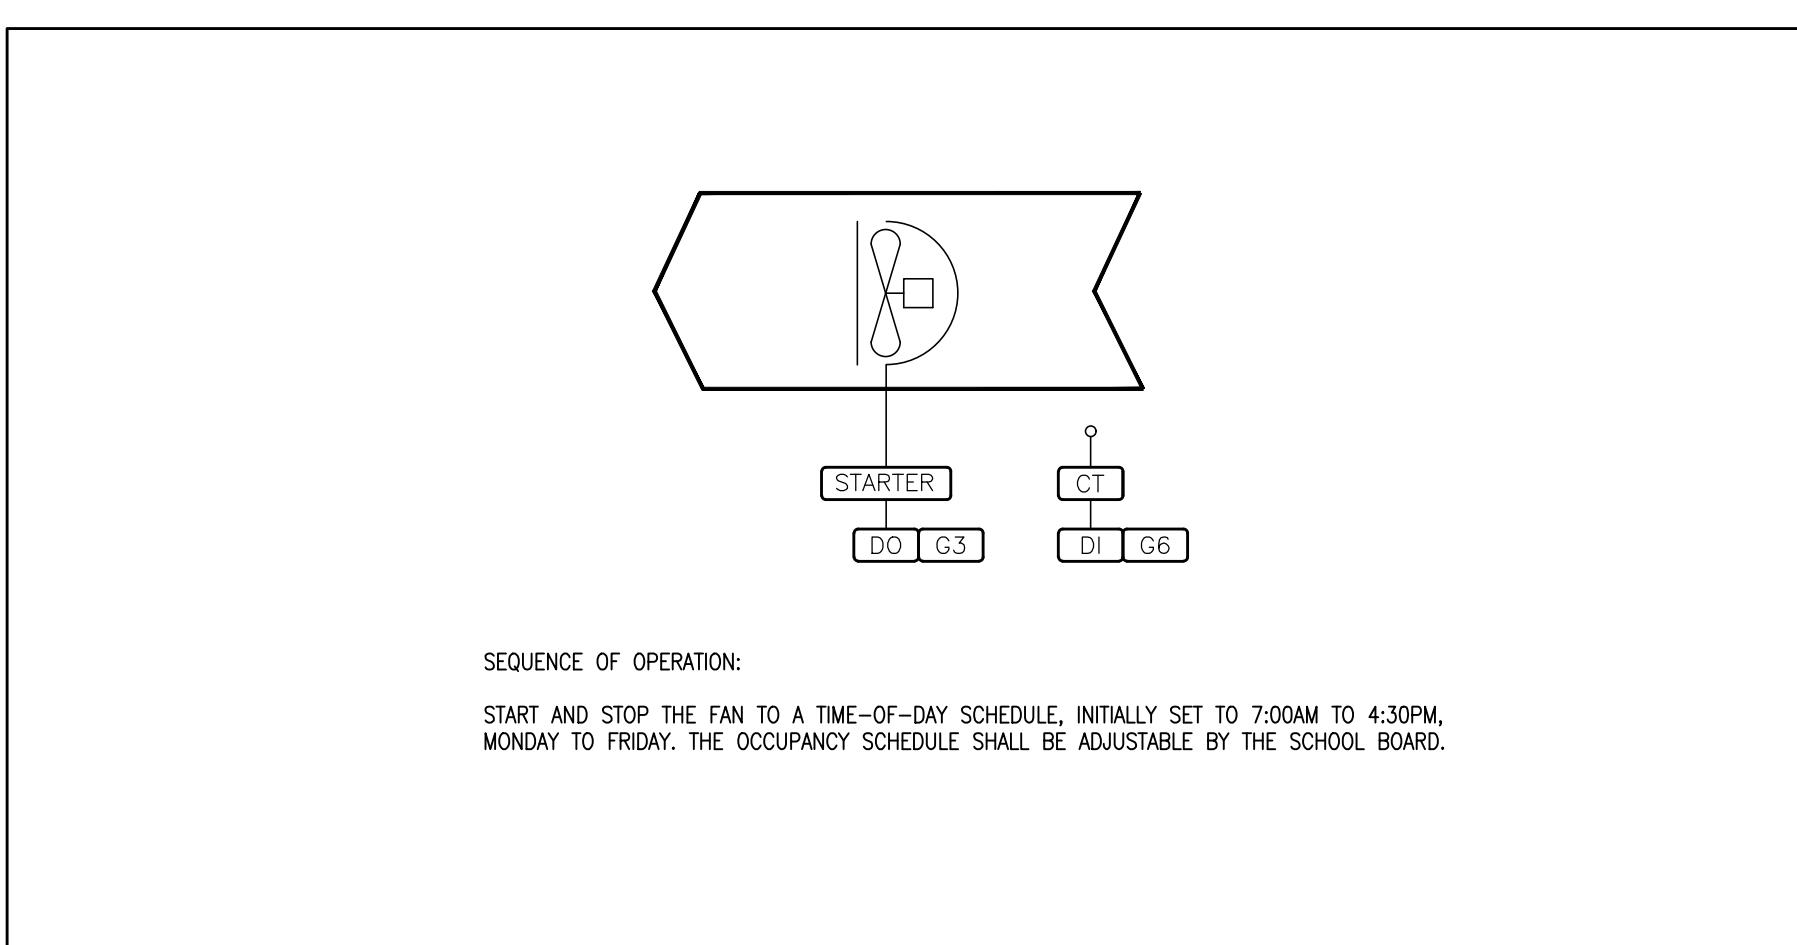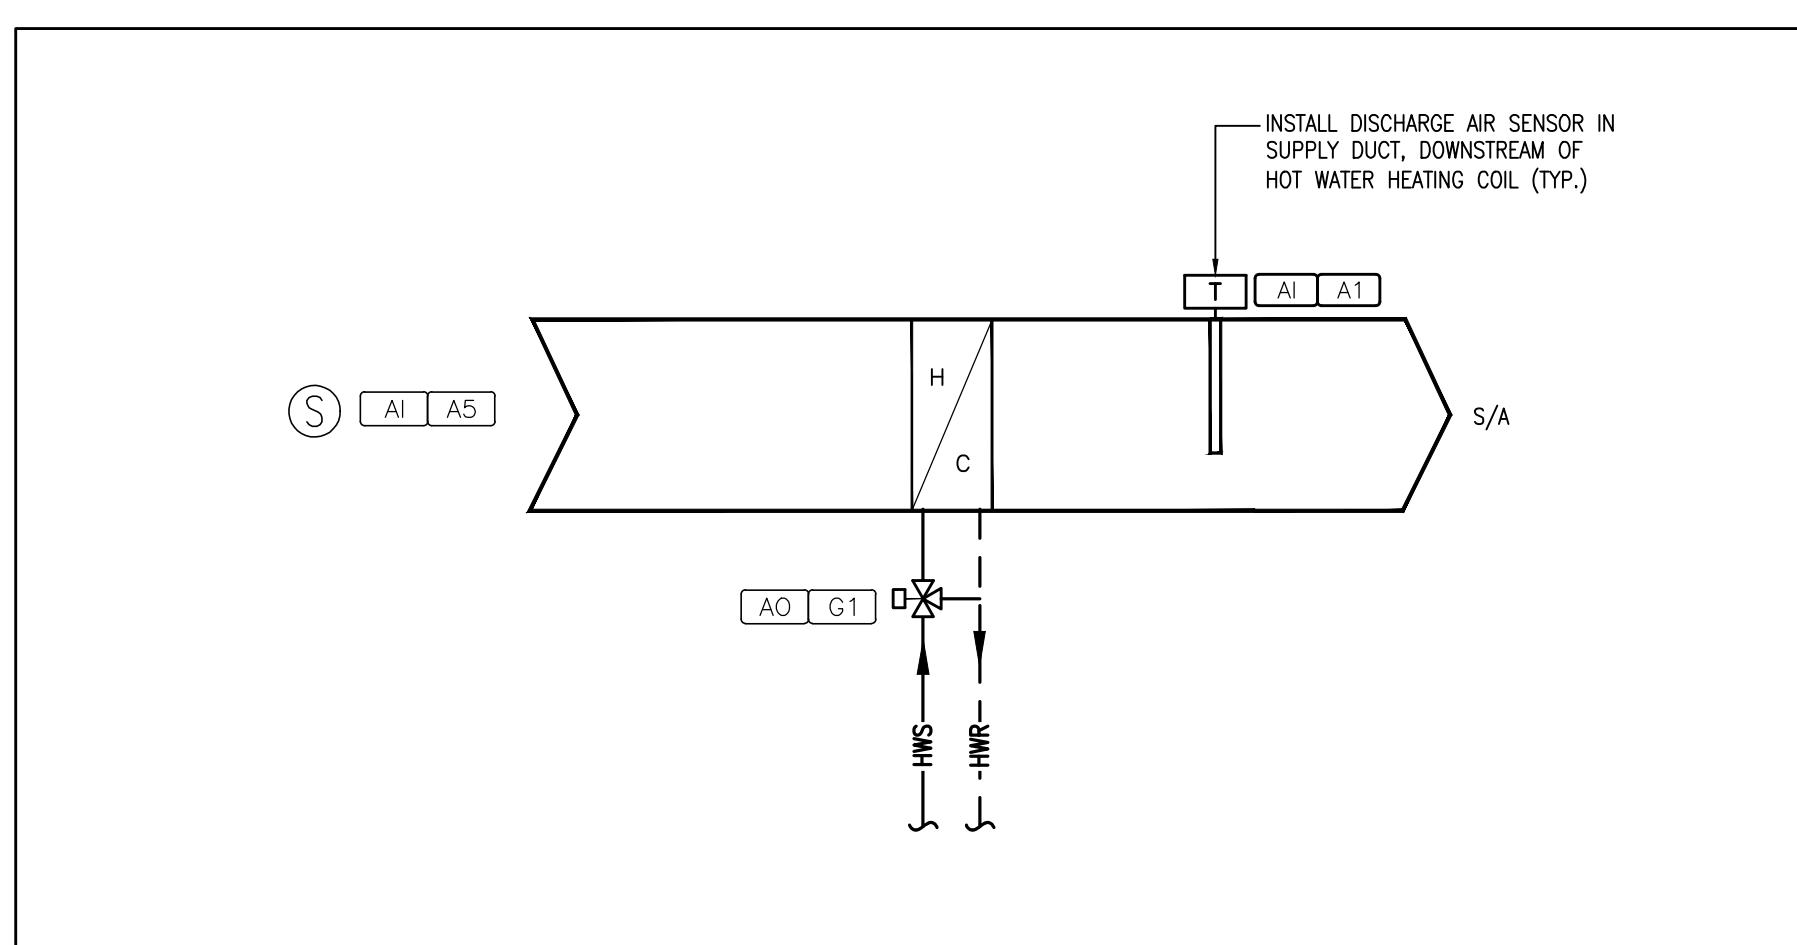

02 ISSUED FOR MECH ADD-001 ME 12/23/25

01 ISSUED FOR TENDER ME 12/17/25

No. DESCRIPTION BY DATE

REVISIONS / STATUS



Project No: 25-14

Scale: AS NOTED


Drawn by: GPC

Checked by: ME


Address: 1911 Dixie Rd N, Pickering, ON L1V 1V4

Title:

CONTROLS & CONTROL DETAILS

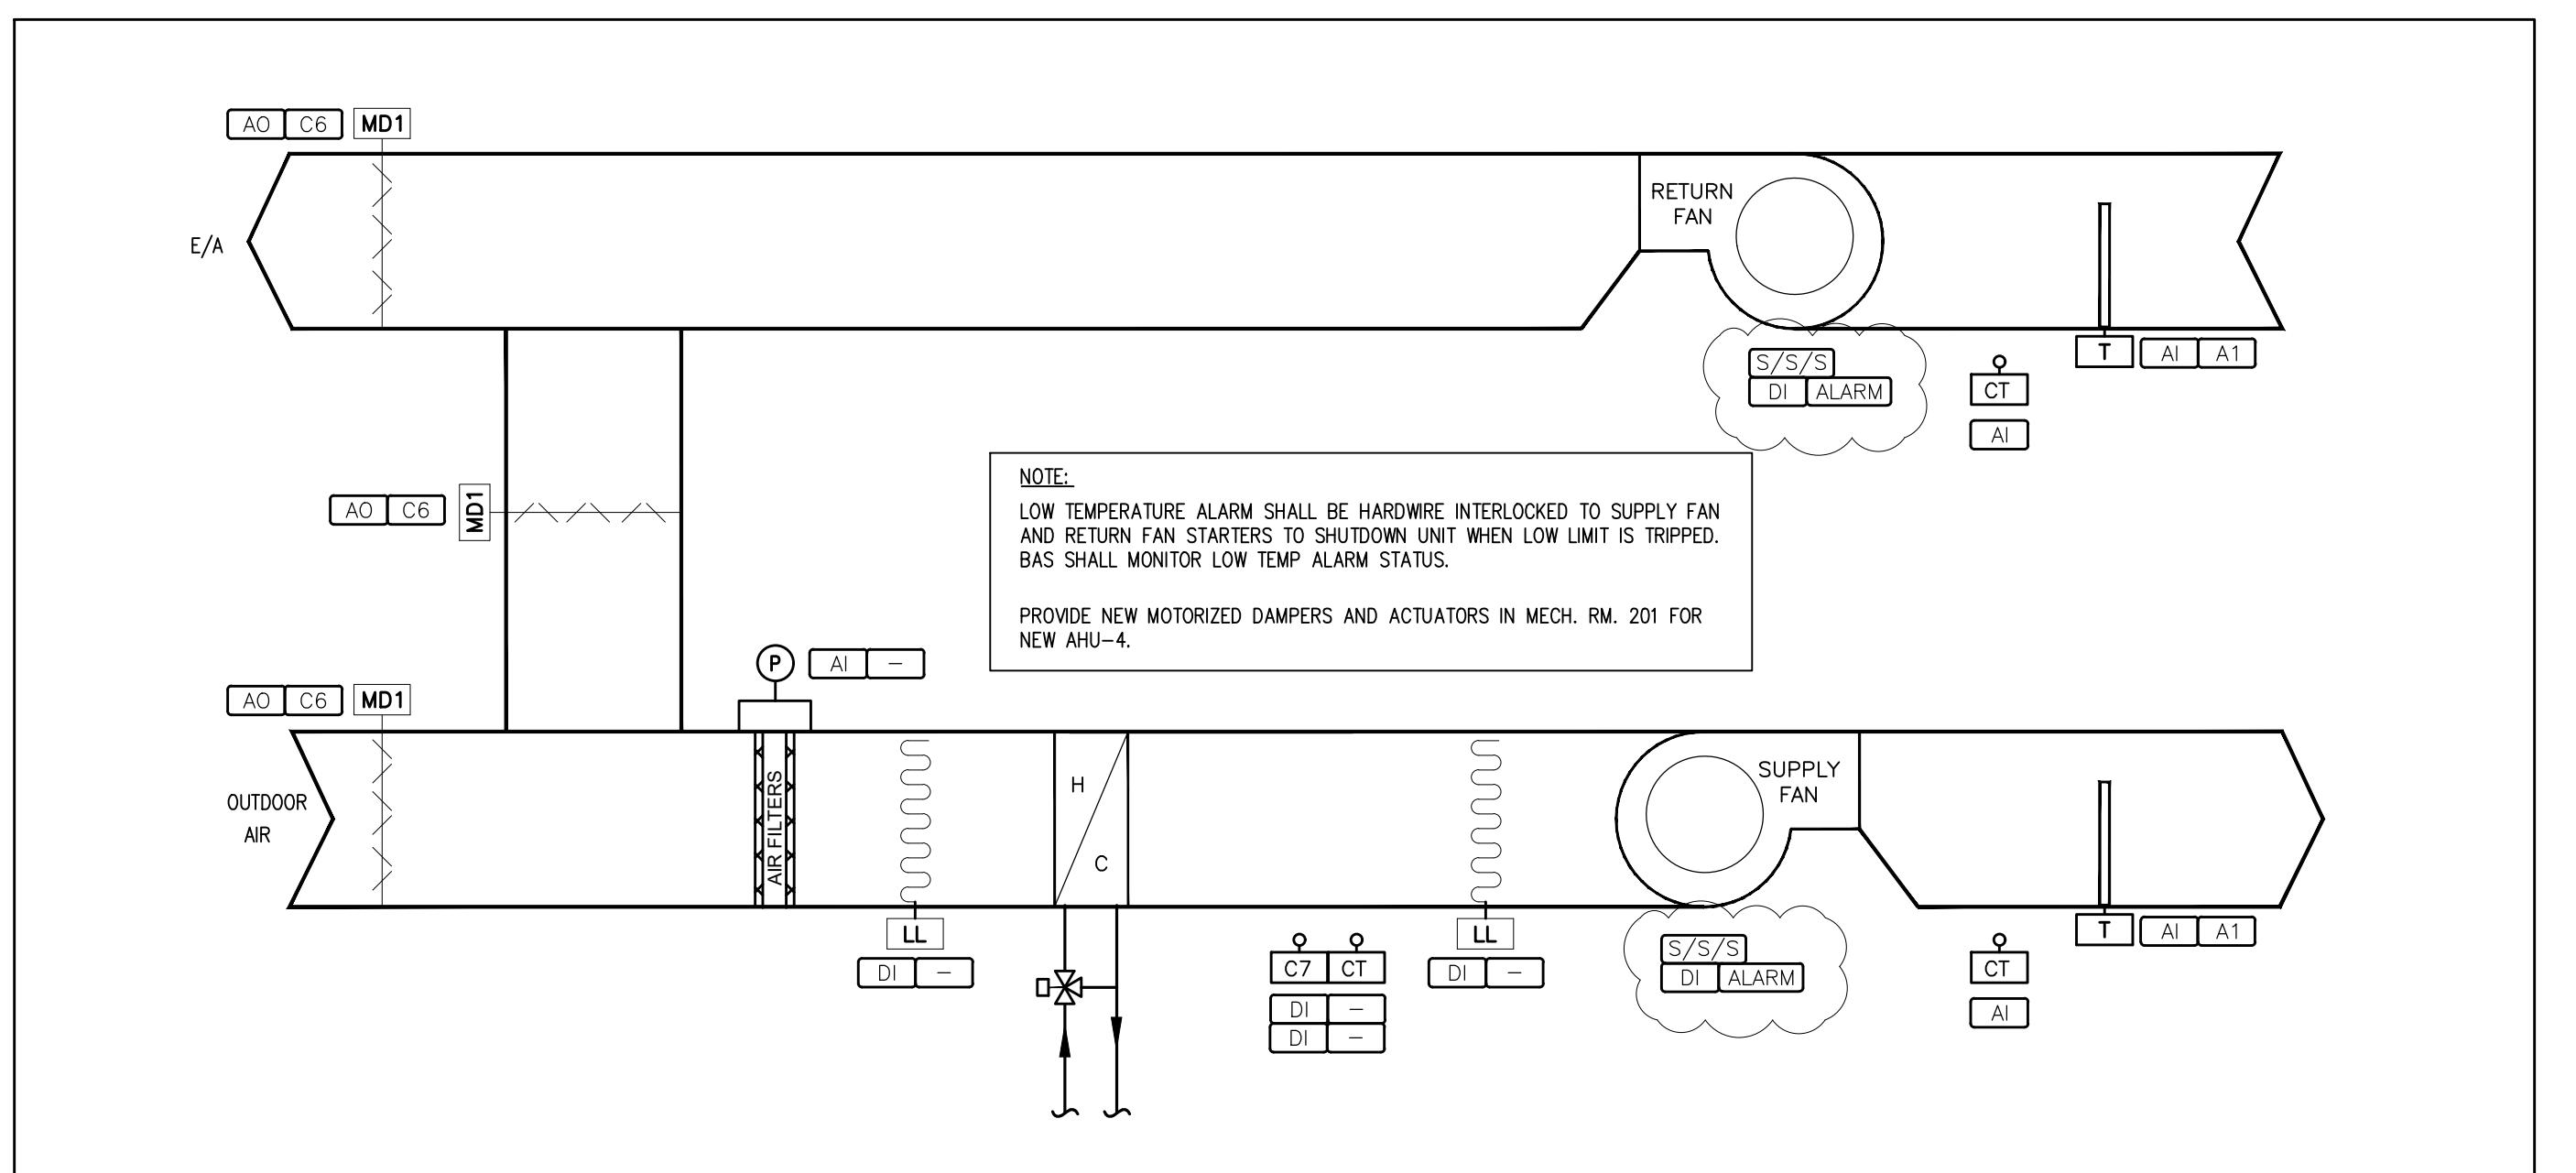

1 AHU-4 (GYM) CONTROL SCHEMATIC
M-105 N.T.S.

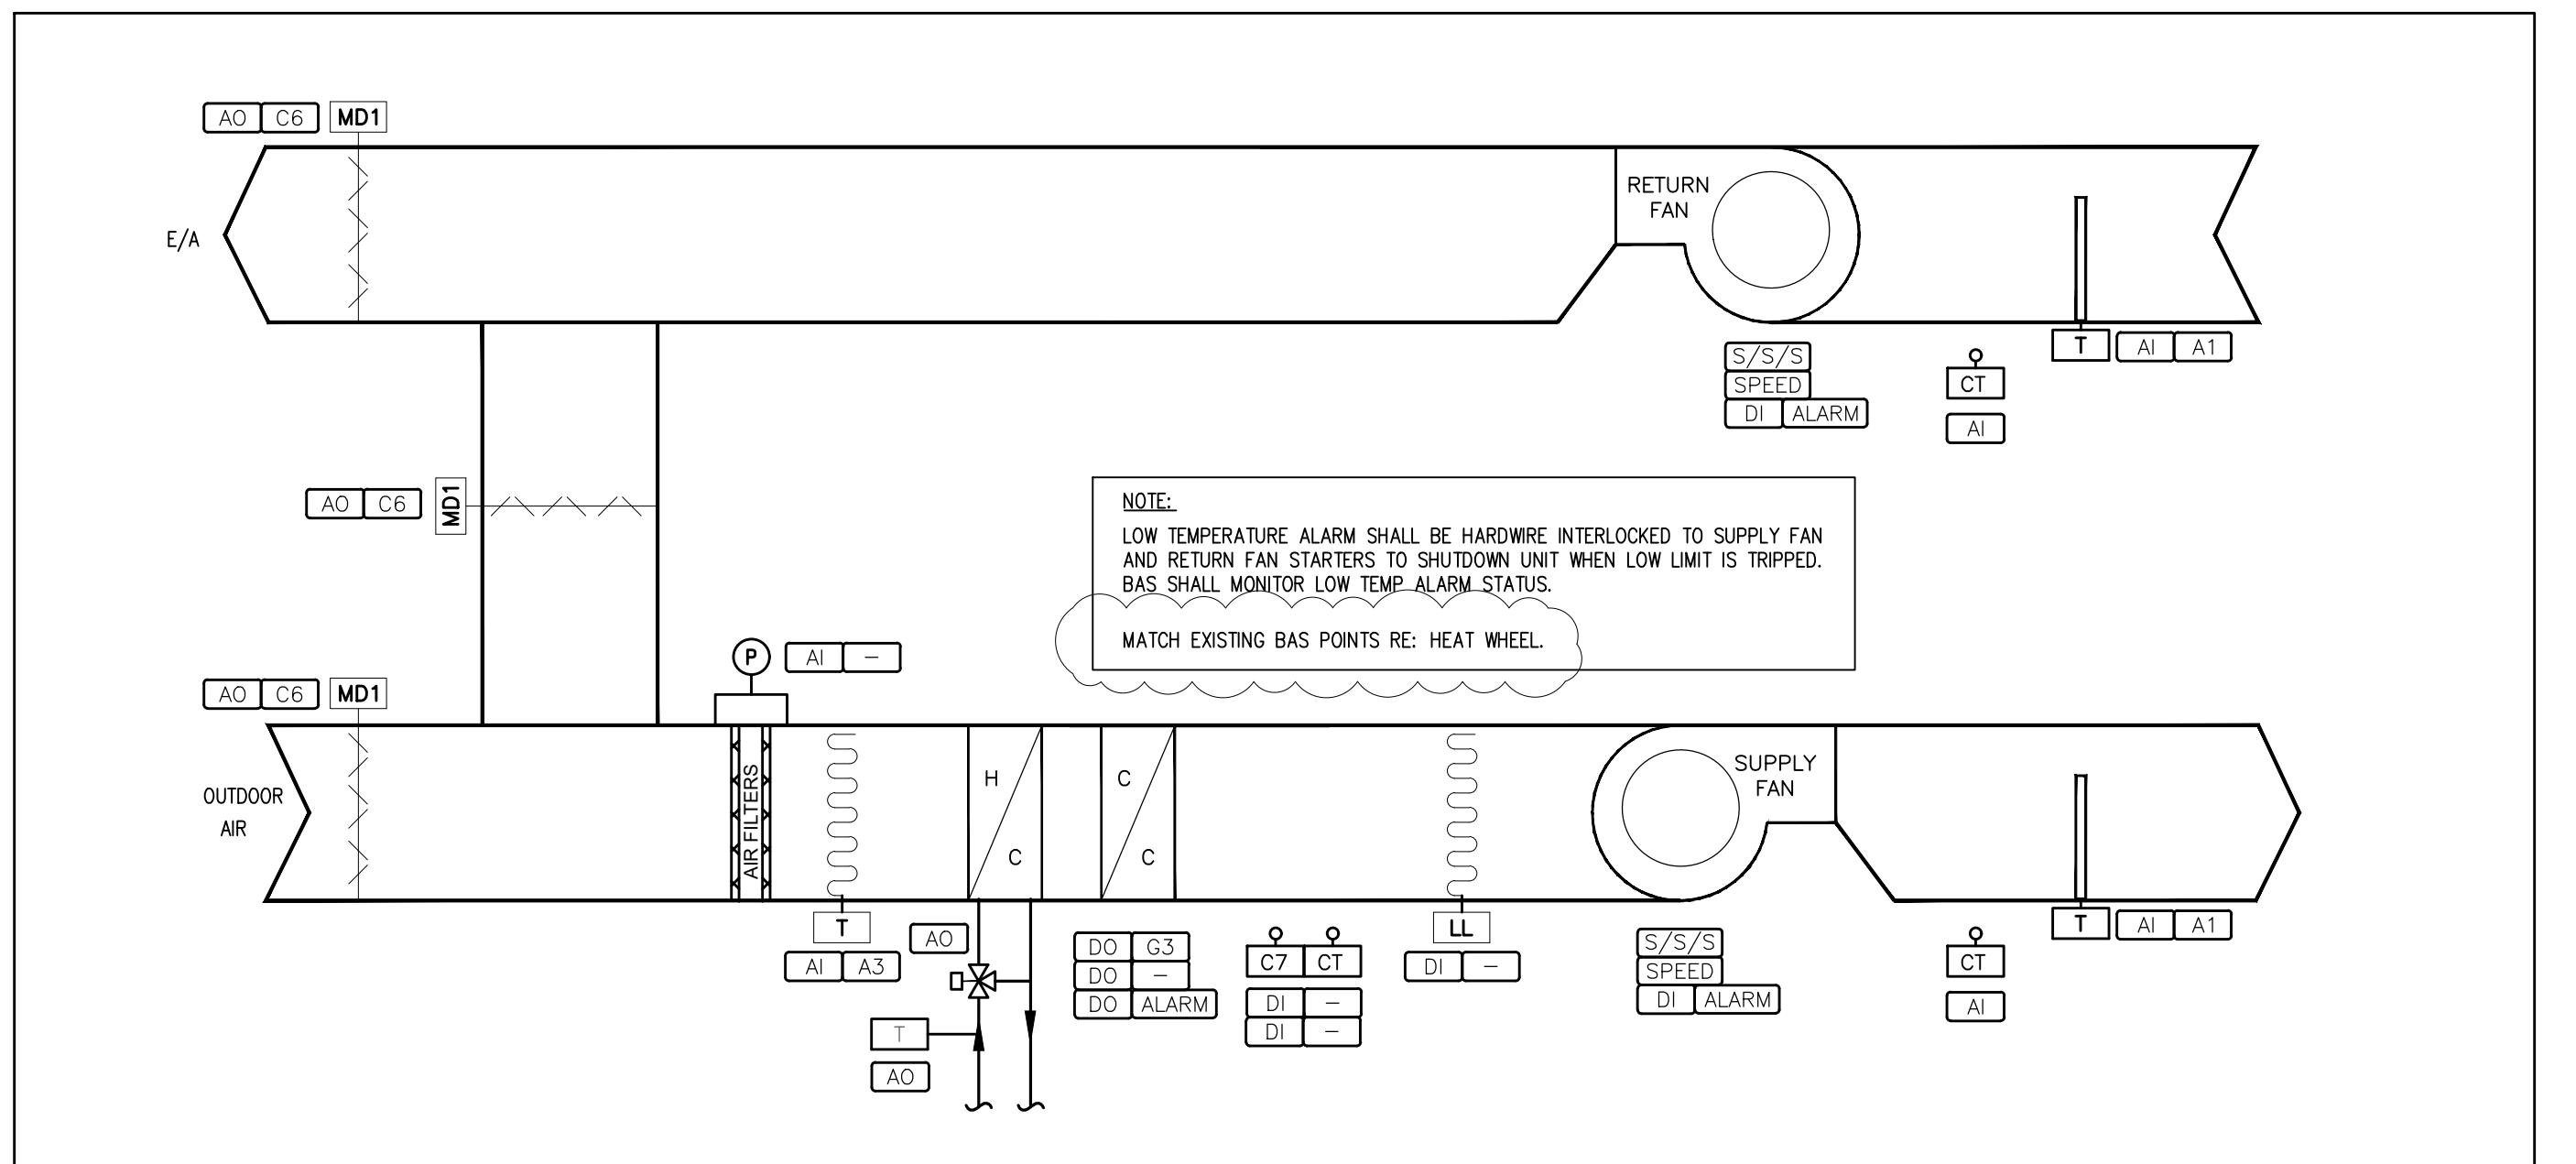

2 AHU-1 (LIBRARY) SYSTEM CONTROL SCHEMATIC
M-105 N.T.S.

| | | | |
|-----|-------------------------|----|----------|
| 02 | ISSUED FOR MECH ADD-001 | ME | 12/23/25 |
| 01 | ISSUED FOR TENDER | ME | 12/17/25 |
| No. | DESCRIPTION | BY | DATE |

REVISIONS / STATUS

| |
|--|
| |
| |

| |
|--|
| |
| |


PROJECT:
VAUGHAN WILLARD P.S.
- AHU REPLACEMENT

Project No: 25-14

Scale: AS NOTED
 Drawn by: GPC
 Checked by: ME
 Address: 1911 Dixie Rd N, Pickering, ON L1V 1V4
 TITLE:


CONTROLS & CONTROL DETAILS

DRAWING No:

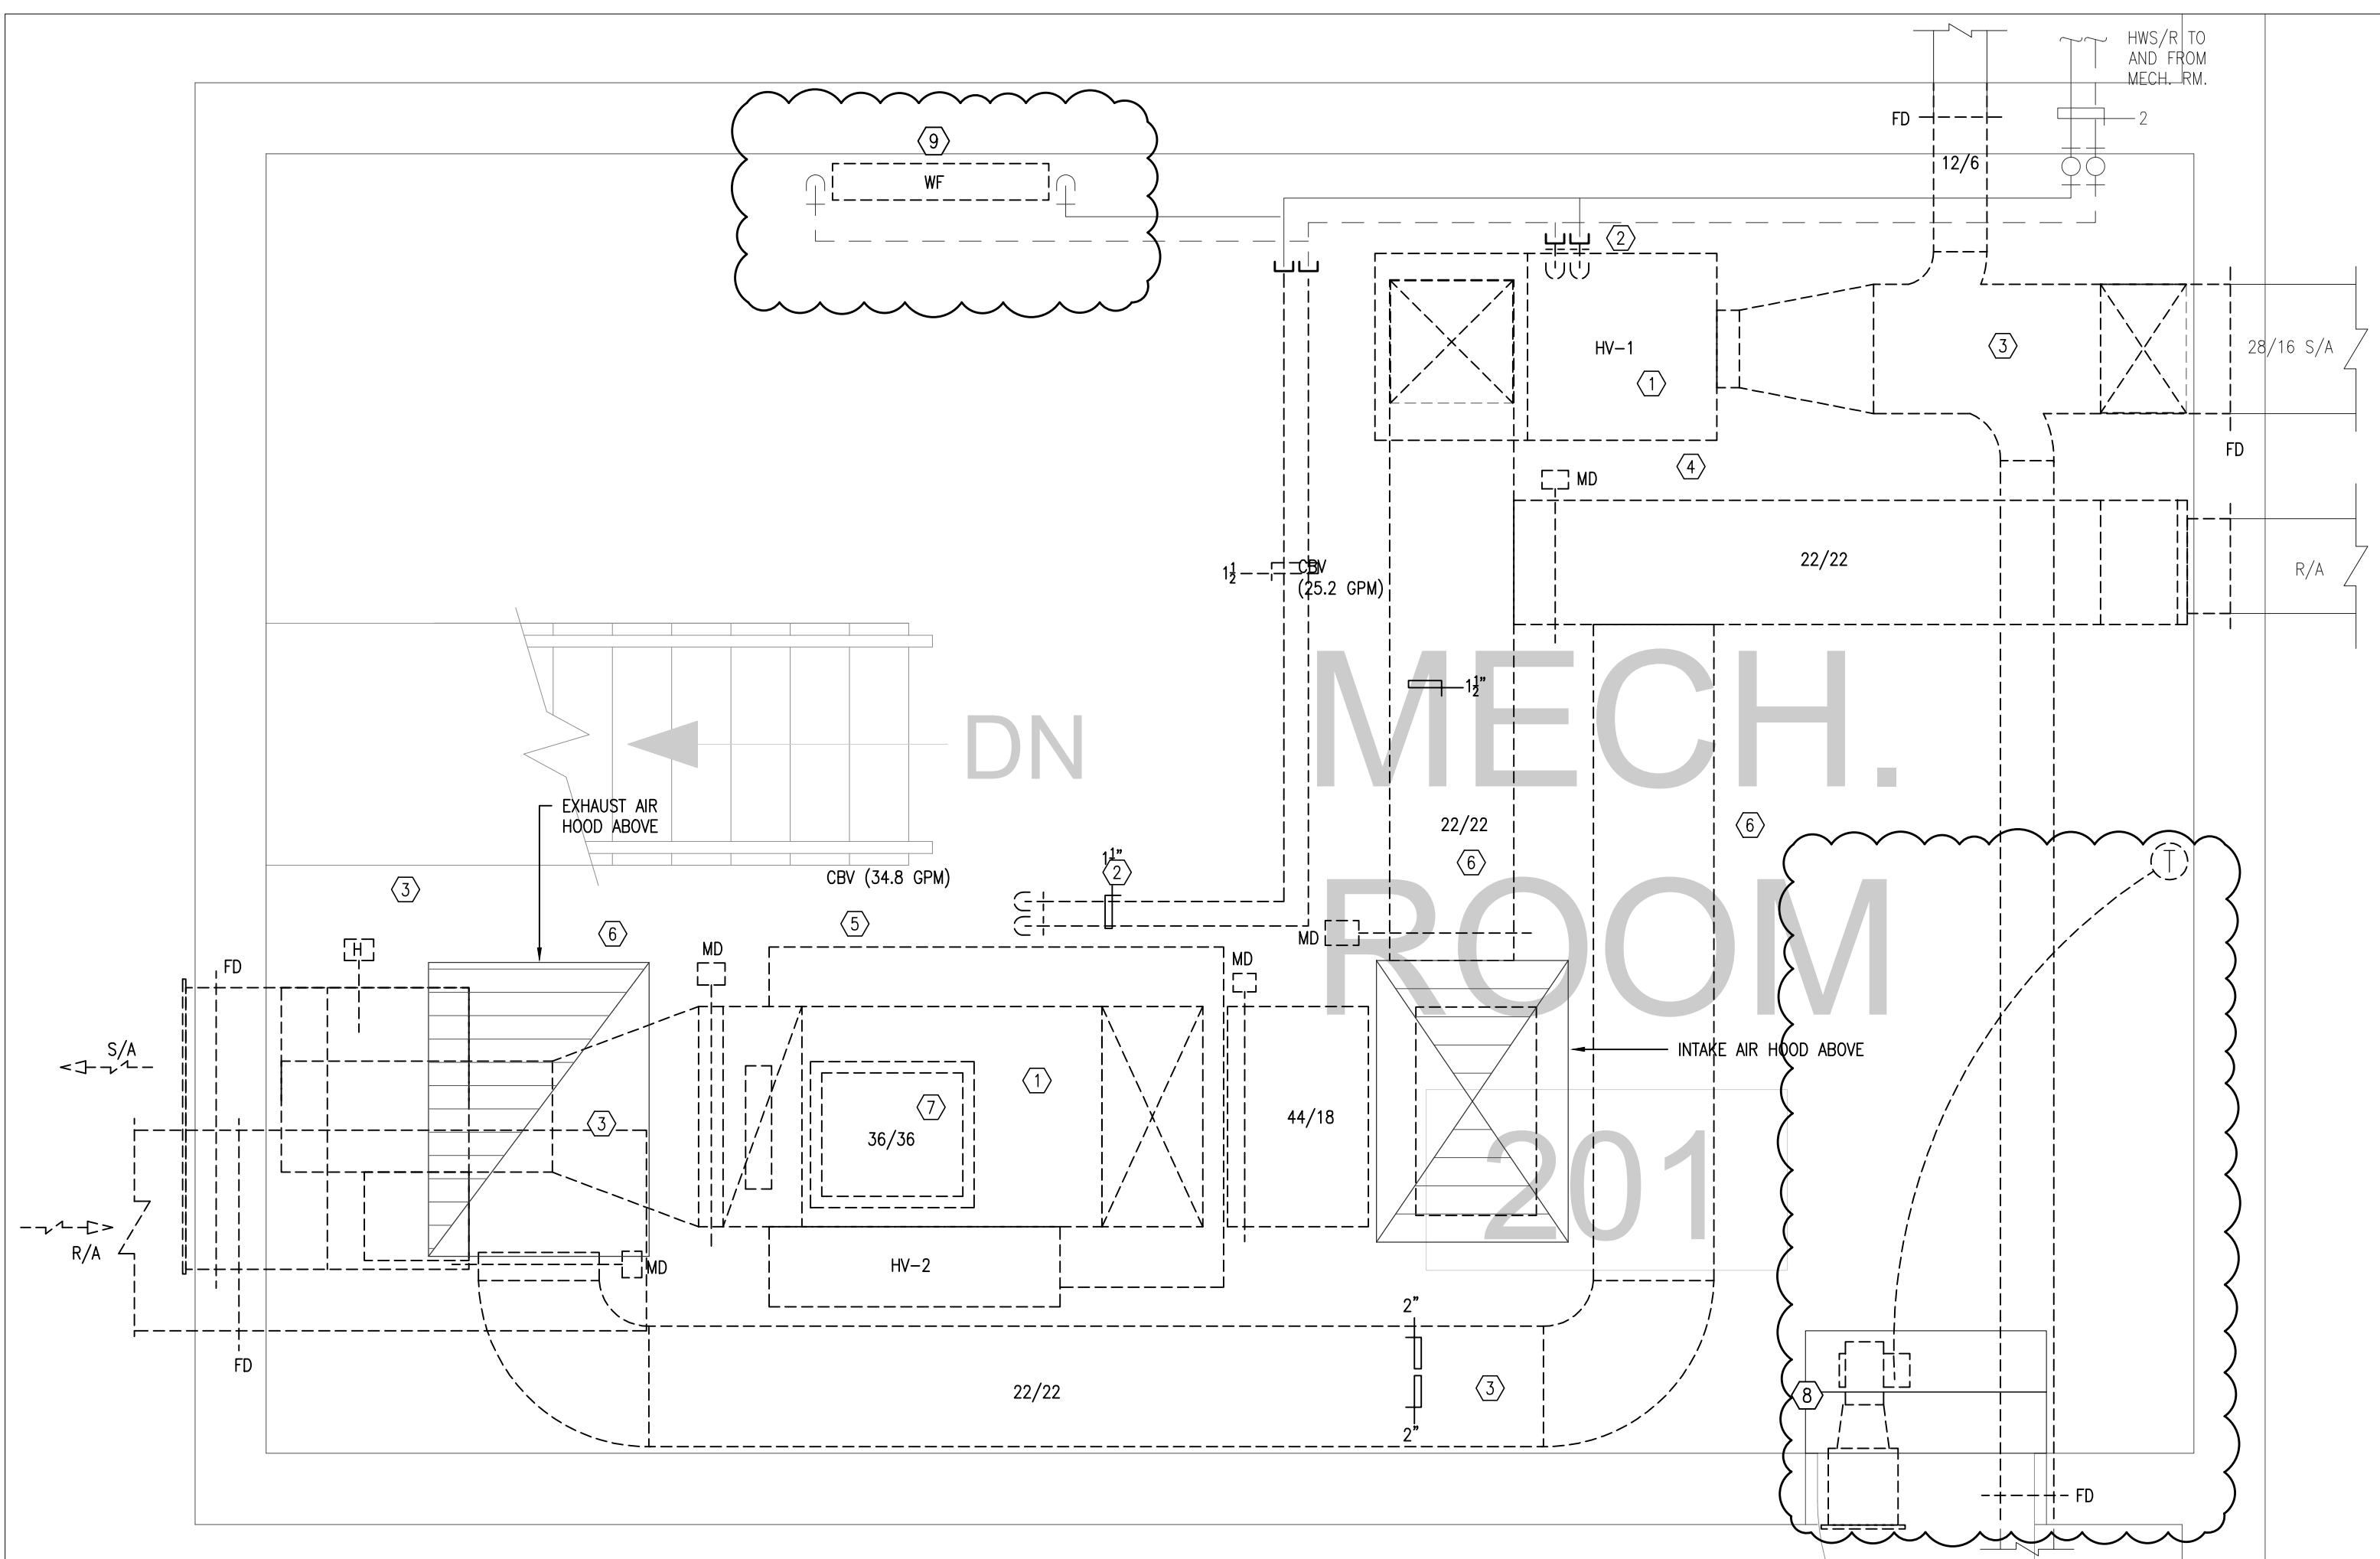

KEYED NOTES:

- ① REMOVE EXISTING AIR HANDLING UNIT COMPLETE WITH DUCT CONNECTIONS, HANGERS, SUPPORTS, AND ALL ACCESSORIES. REMOVE EXISTING CONTROLS AND CONTROL WIRING ASSOCIATED.
- ② REMOVE EXISTING HEATING PIPING TO AHU, INCLUDING ALL VALVES AND ACCESSORIES SHOWN ON DRAWINGS. TURN CONTROL VALVES AND ACTUATORS OVER TO DDSB.
- ③ REMOVE SUPPLY AIR AND RETURN AIR DUCTWORK (AS SHOWN) UP TO FIRE DAMPERS AT PENETRATION OF MECHANICAL ROOM WALLS. REMOVE MOTORIZED DAMPERS, REMOVE FIRE DAMPERS.
- ④ REMOVE EXISTING HOUSEKEEPING PAD FOR HV-1. MAKE FLOOR LEVEL AS REQUIRED TO SUIT NEW HOUSEKEEPING PAD.
- ⑤ REMOVE EXISTING HOUSEKEEPING PAD FOR HV-2. PATCH FLOOR AND MAKE LEVEL.
- ⑥ REMOVE EXISTING OUTSIDE AIR AND EXHAUST AIR DUCTWORK UP FROM AHU, THROUGH MECHANICAL ROOM, AND UP TO PENETRATION AT ROOF COMPLETE WITH DAMPERS, ACTUATORS, AND CONTROL WIRING. EXISTING ROOF HOODS AND INITIAL DUCTWORK PLENUM BEFORE DAMPERS TO REMAIN AND BE REUSED.
- ⑦ REMOVE ANY REMAINING HUMIDIFIER COILS, COMPONENTS, PIPING, WIRING, ETC. FROM ABANDONED HUMIDIFIER.
- ⑧ REMOVE EXISTING FLOOR MOUNT EXHAUST FAN AND ASSOCIATED DUCTWORK & CONTROLS.
- ⑨ REMOVE EXISTING WALLFIN HEATER.

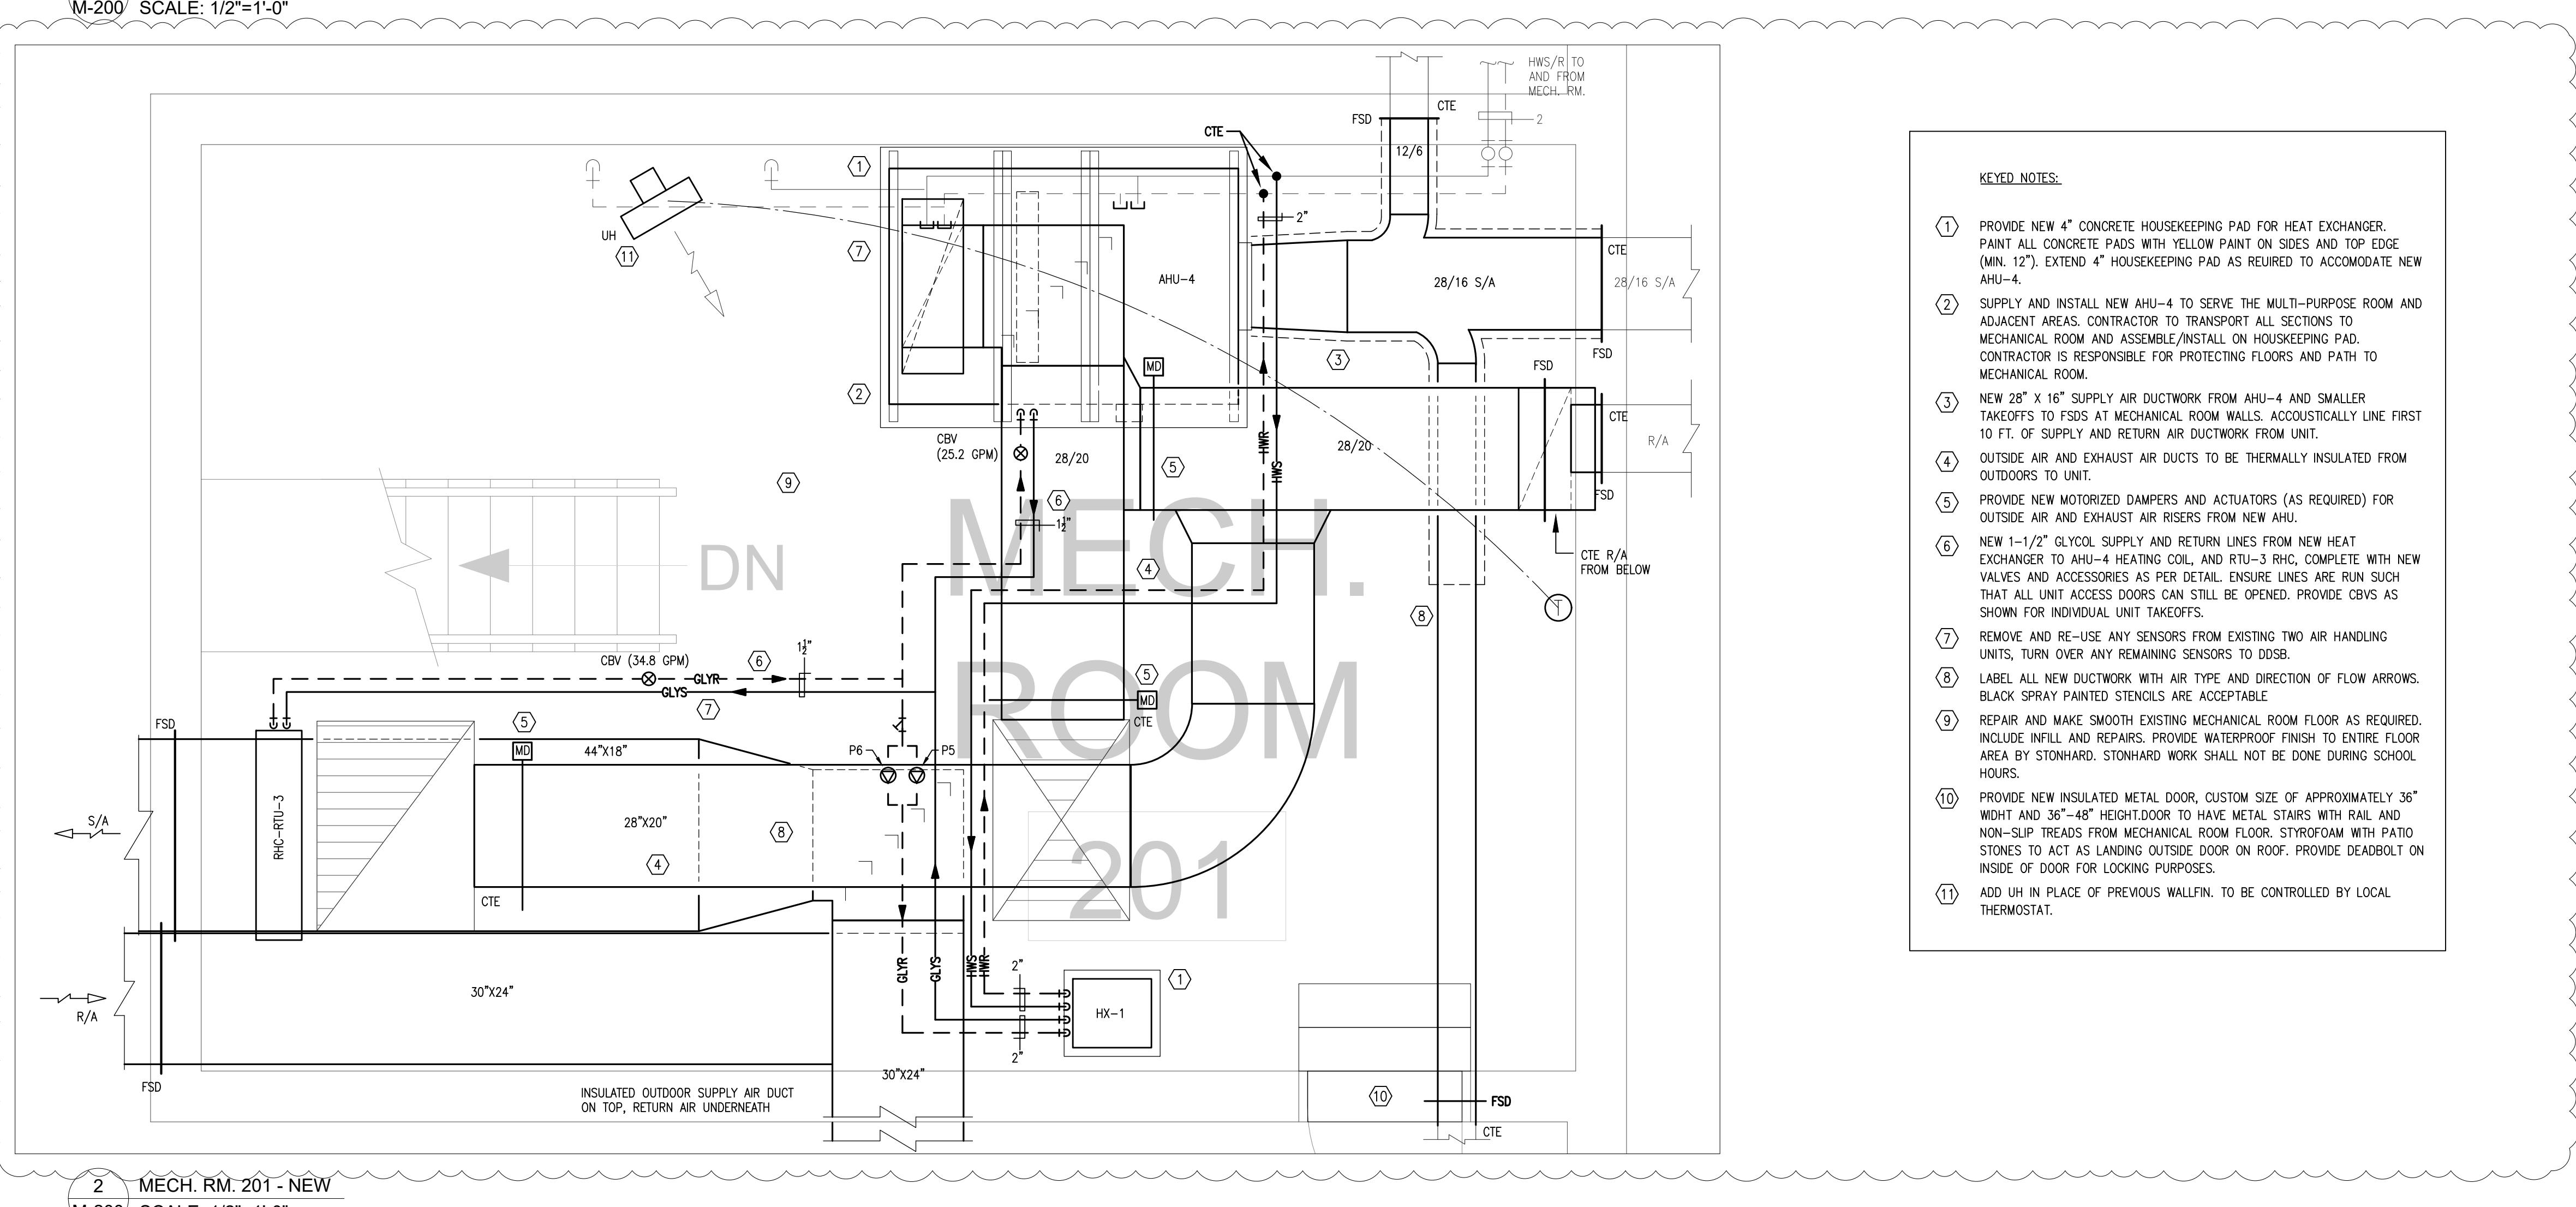

KEYED NOTES:

- ① PROVIDE NEW 4" CONCRETE HOUSEKEEPING PAD FOR HEAT EXCHANGER. PAINT ALL CONCRETE PADS WITH YELLOW PAINT ON SIDES AND TOP EDGE (MIN. 12"). EXTEND 4" HOUSEKEEPING PAD AS REQUIRED TO ACCOMMODATE NEW AHU-4.
- ② SUPPLY AND INSTALL NEW AHU-4 TO SERVE THE MULTI-PURPOSE ROOM AND ADJACENT AREAS. CONTRACTOR TO TRANSPORT ALL SECTIONS TO MECHANICAL ROOM AND ASSEMBLE/INSTALL ON HOUSEKEEPING PAD. CONTRACTOR IS RESPONSIBLE FOR PROTECTING FLOORS AND PATH TO MECHANICAL ROOM.
- ③ NEW 28" X 16" SUPPLY AIR DUCTWORK FROM AHU-4 AND SMALLER TAKEOFFS TO FSD AT MECHANICAL ROOM WALLS. ACOUSTICALLY LINE FIRST 10 FT. OF SUPPLY AND RETURN AIR DUCTWORK FROM UNIT.
- ④ OUTSIDE AIR AND EXHAUST AIR DUCTS TO BE THERMALLY INSULATED FROM OUTDOORS TO UNIT.
- ⑤ PROVIDE NEW MOTORIZED DAMPERS AND ACTUATORS (AS REQUIRED) FOR OUTSIDE AIR AND EXHAUST AIR RISERS FROM NEW AHU.
- ⑥ NEW 1-1/2" GLYCOL SUPPLY AND RETURN LINES FROM NEW HEAT EXCHANGER TO AHU-4 HEATING COIL, AND RTU-3 RHC, COMPLETE WITH NEW VALVES AND ACCESSORIES AS PER DETAIL. ENSURE LINES ARE RUN SUCH THAT ALL UNIT ACCESS DOORS CAN STILL BE OPENED. PROVIDE CBVs AS SHOWN FOR INDIVIDUAL UNIT TAKEOFFS.
- ⑦ REMOVE AND RE-USE ANY SENSORS FROM EXISTING TWO AIR HANDLING UNITS. TURN OVER ANY REMAINING SENSORS TO DDSB.
- ⑧ LABEL ALL NEW DUCTWORK WITH AIR TYPE AND DIRECTION OF FLOW ARROWS. BLACK SPRAY PAINTED STENCILS ARE ACCEPTABLE.
- ⑨ REPAIR AND MAKE SMOOTH EXISTING MECHANICAL ROOM FLOOR AS REQUIRED. INCLUDE INFILL AND REPAIRS. PROVIDE WATERPROOF FINISH TO ENTIRE FLOOR AREA BY STONHARD. STONHARD WORK SHALL NOT BE DONE DURING SCHOOL HOURS.
- ⑩ PROVIDE NEW INSULATED METAL DOOR, CUSTOM SIZE OF APPROXIMATELY 36" WIDTH AND 36"-48" HEIGHT, DOOR TO HAVE METAL STAIRS WITH RAIL AND NON-SLIP TREADS FROM MECHANICAL ROOM FLOOR. STYROFOAM WITH PATIO STONES TO ACT AS LANDING OUTSIDE DOOR ON ROOF. PROVIDE DEADBOLT ON INSIDE OF DOOR FOR LOCKING PURPOSES.
- ⑪ ADD UH IN PLACE OF PREVIOUS WALLFIN. TO BE CONTROLLED BY LOCAL THERMOSTAT.

| | | | |
|----|-------------------------|----|----------|
| 02 | ISSUED FOR MECH ADD-001 | ME | 12/23/25 |
| 01 | ISSUED FOR TENDER | ME | 12/17/25 |

REVISIONS / STATUS


PROJECT:
VAUGHAN WILLARD P.S.
- AHU REPLACEMENT

Project No: 25-14


Scale: AS NOTED
Drawn by: GPC
Checked by: ME
Address: 1911 Dixie Rd N, Pickering, ON L1V 1V4
TITLE:

MECHANICAL ROOM 201 - DEMO/NEW

DRAWING No:

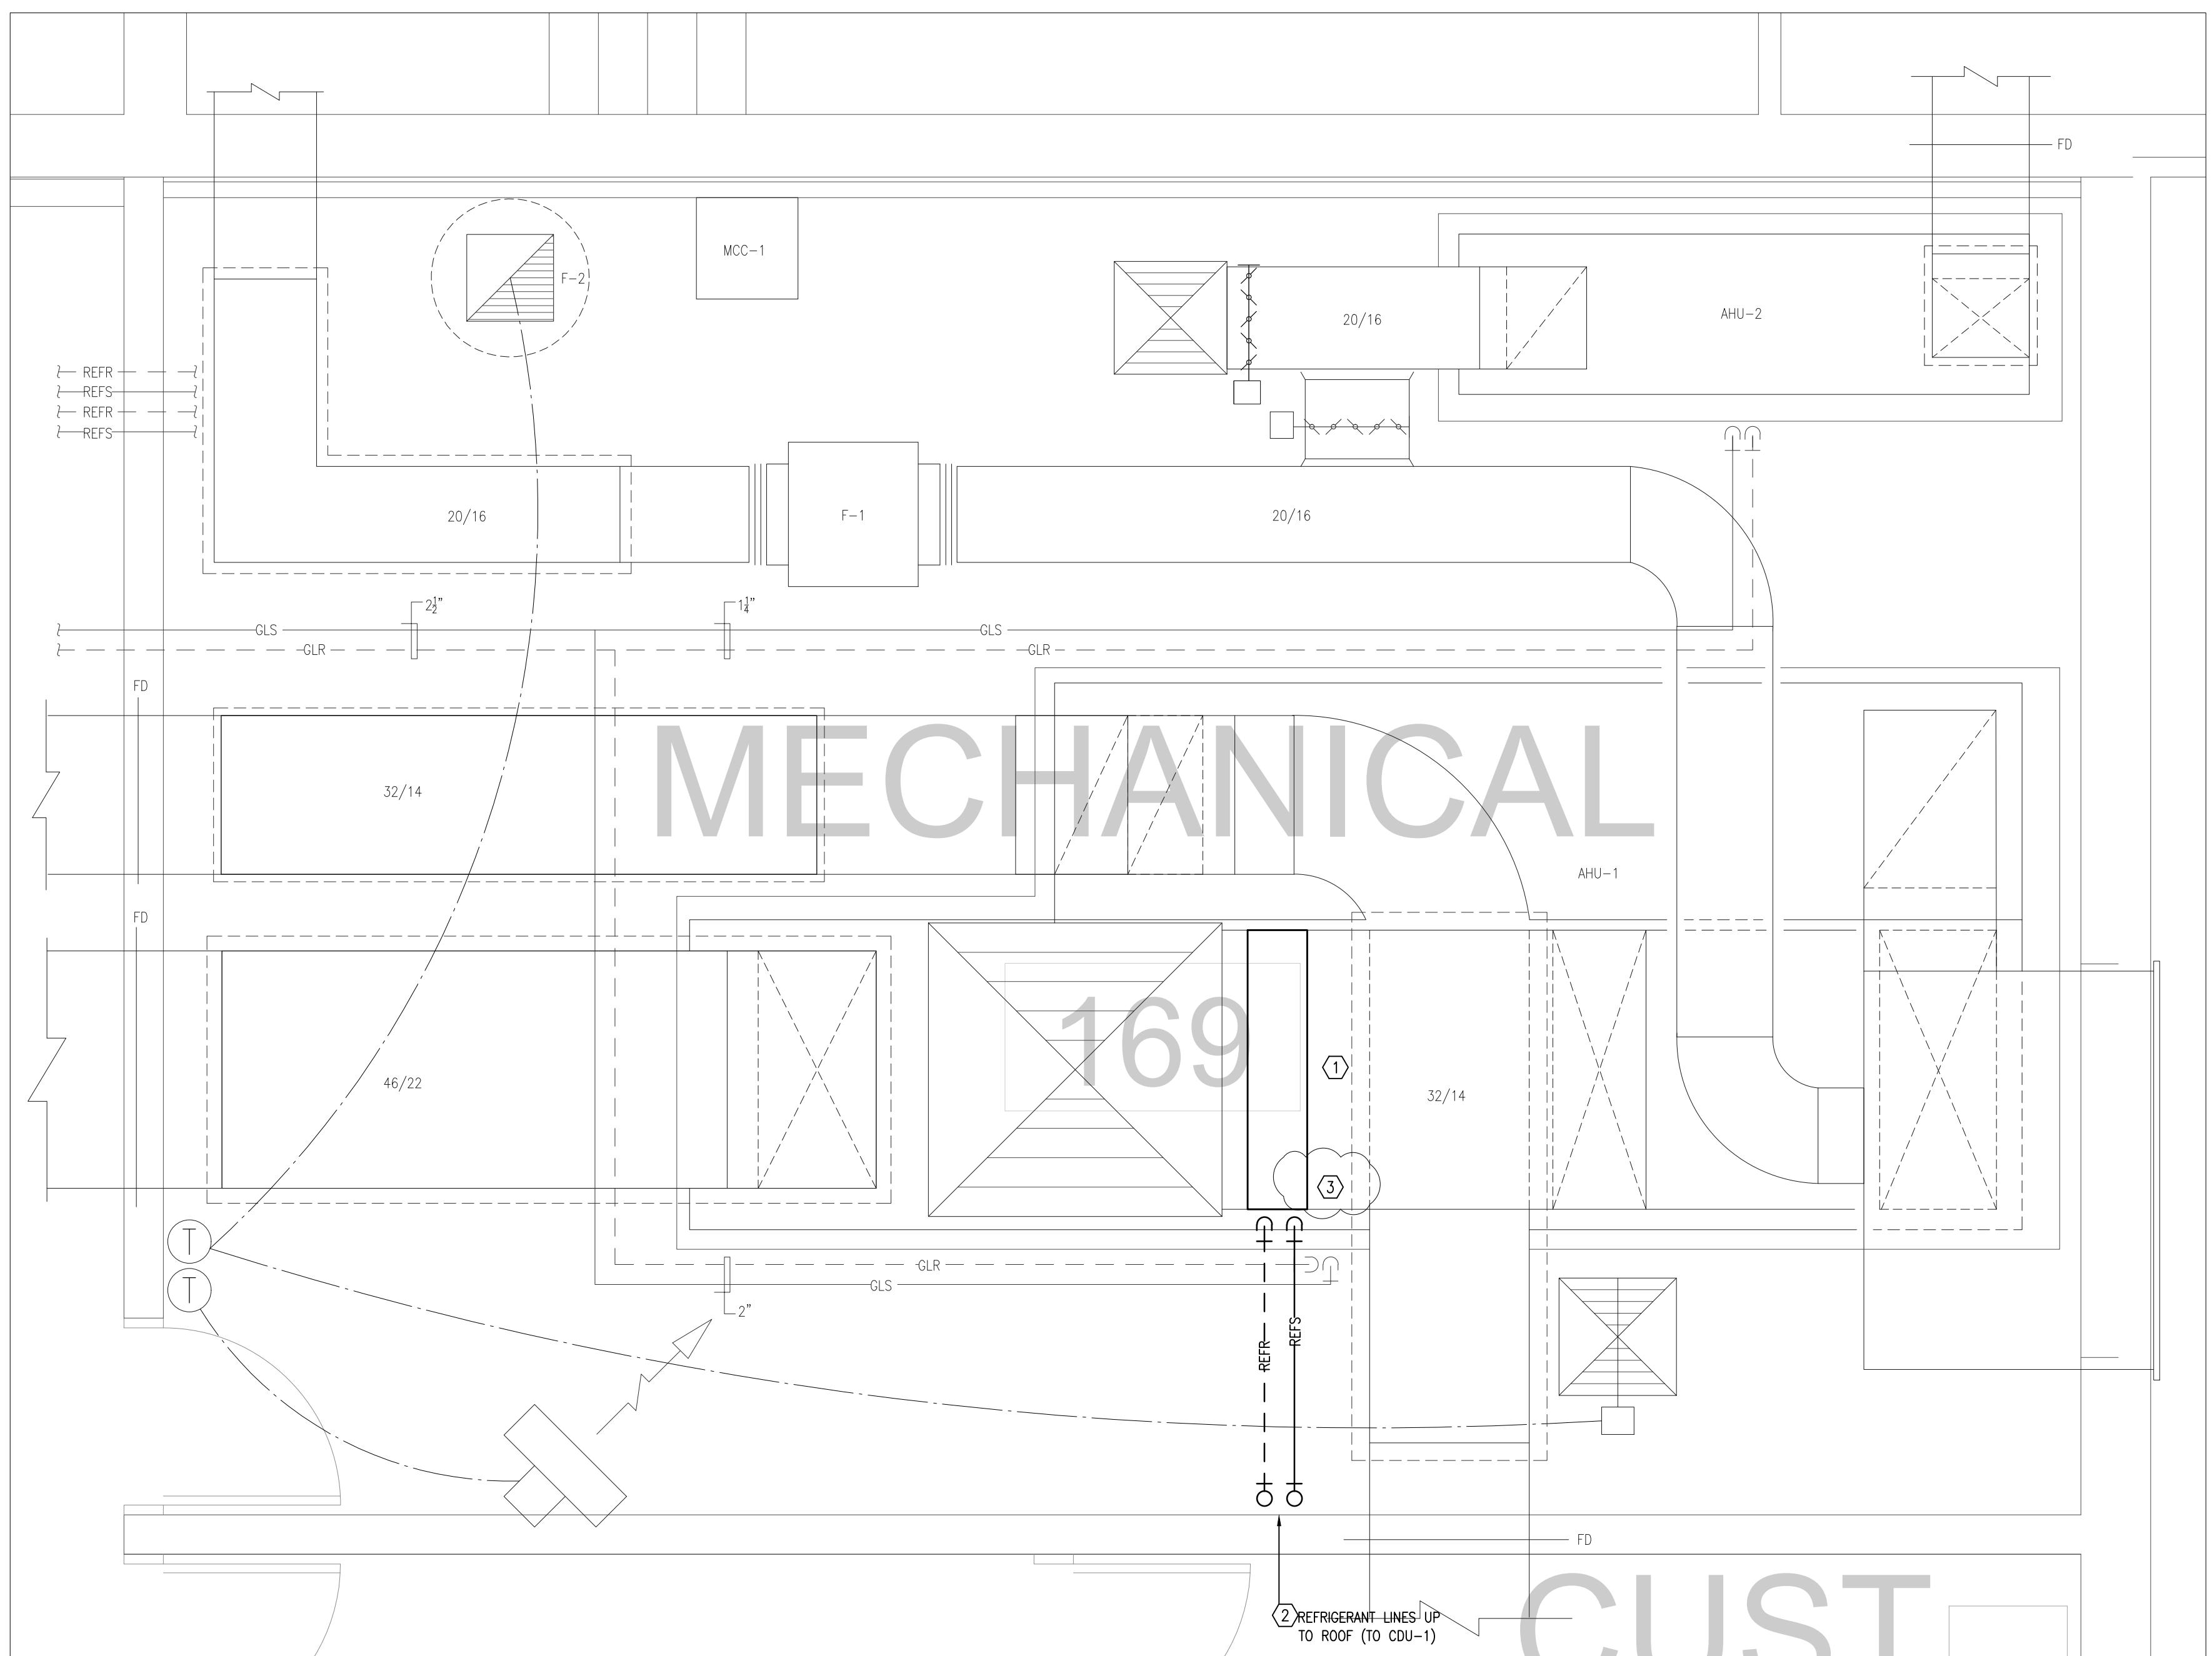

1 MECH. RM. 169 - DEMO/NEW
M-201 SCALE: 1/2"=1'-0"

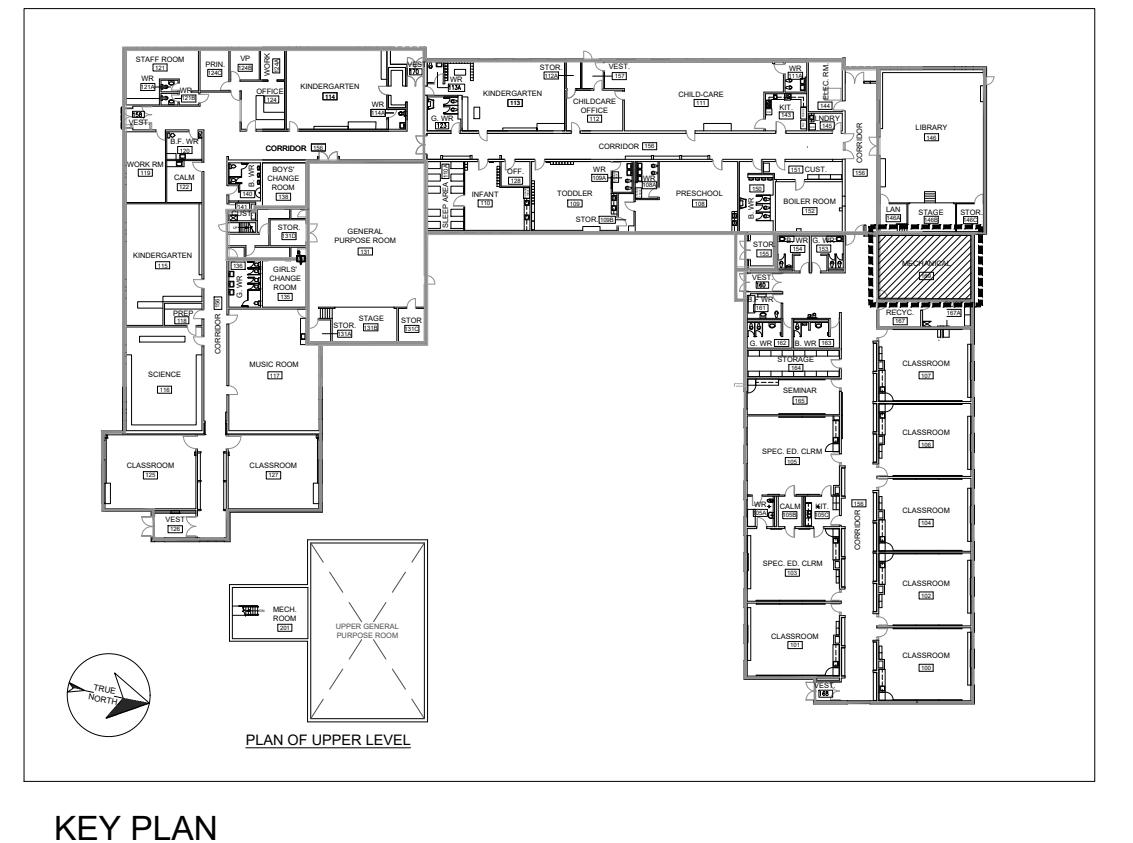

KEY PLAN

KEYED NOTES:

- ① INSTALL NEW DX COOLING COIL AS PER SCHEDULE WITHIN EXISTING AHU-1.
- ② REFRIGERANT LINES FROM NEW DX COOLING COIL TO NEW CDU-1 ON ROOF. PROVIDE DOGHOUSE STRUCTURE ON ROOF. REFER TO ROOF PLAN M-400 FOR FURTHER DETAILS.
- ③ CONTRACTOR TO ENSURE DRAIN AND P-TRAP ARE IN GOOD WORKING ORDER PRIOR TO COIL START UP.

| | | | |
|-----|-------------------------|----|----------|
| 02 | ISSUED FOR MECH ADD-001 | ME | 12/23/25 |
| 01 | ISSUED FOR TENDER | ME | 12/17/25 |
| No. | DESCRIPTION | BY | DATE |

REVISIONS / STATUS

| |
|--|
| |
| |
| |


PROJECT:
VAUGHAN WILLARD P.S.
- AHU REPLACEMENT

Project No: 25-14


Scale: AS NOTED
Drawn by: GPC
Checked by: ME
Address: 1911 Dixie Rd N, Pickering, ON L1V 1V4

TITLE:

MECHANICAL ROOM 169 - DEMO/NEW

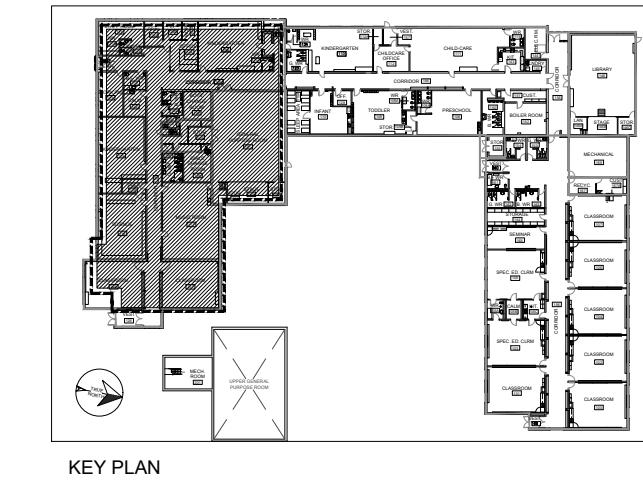


KEY

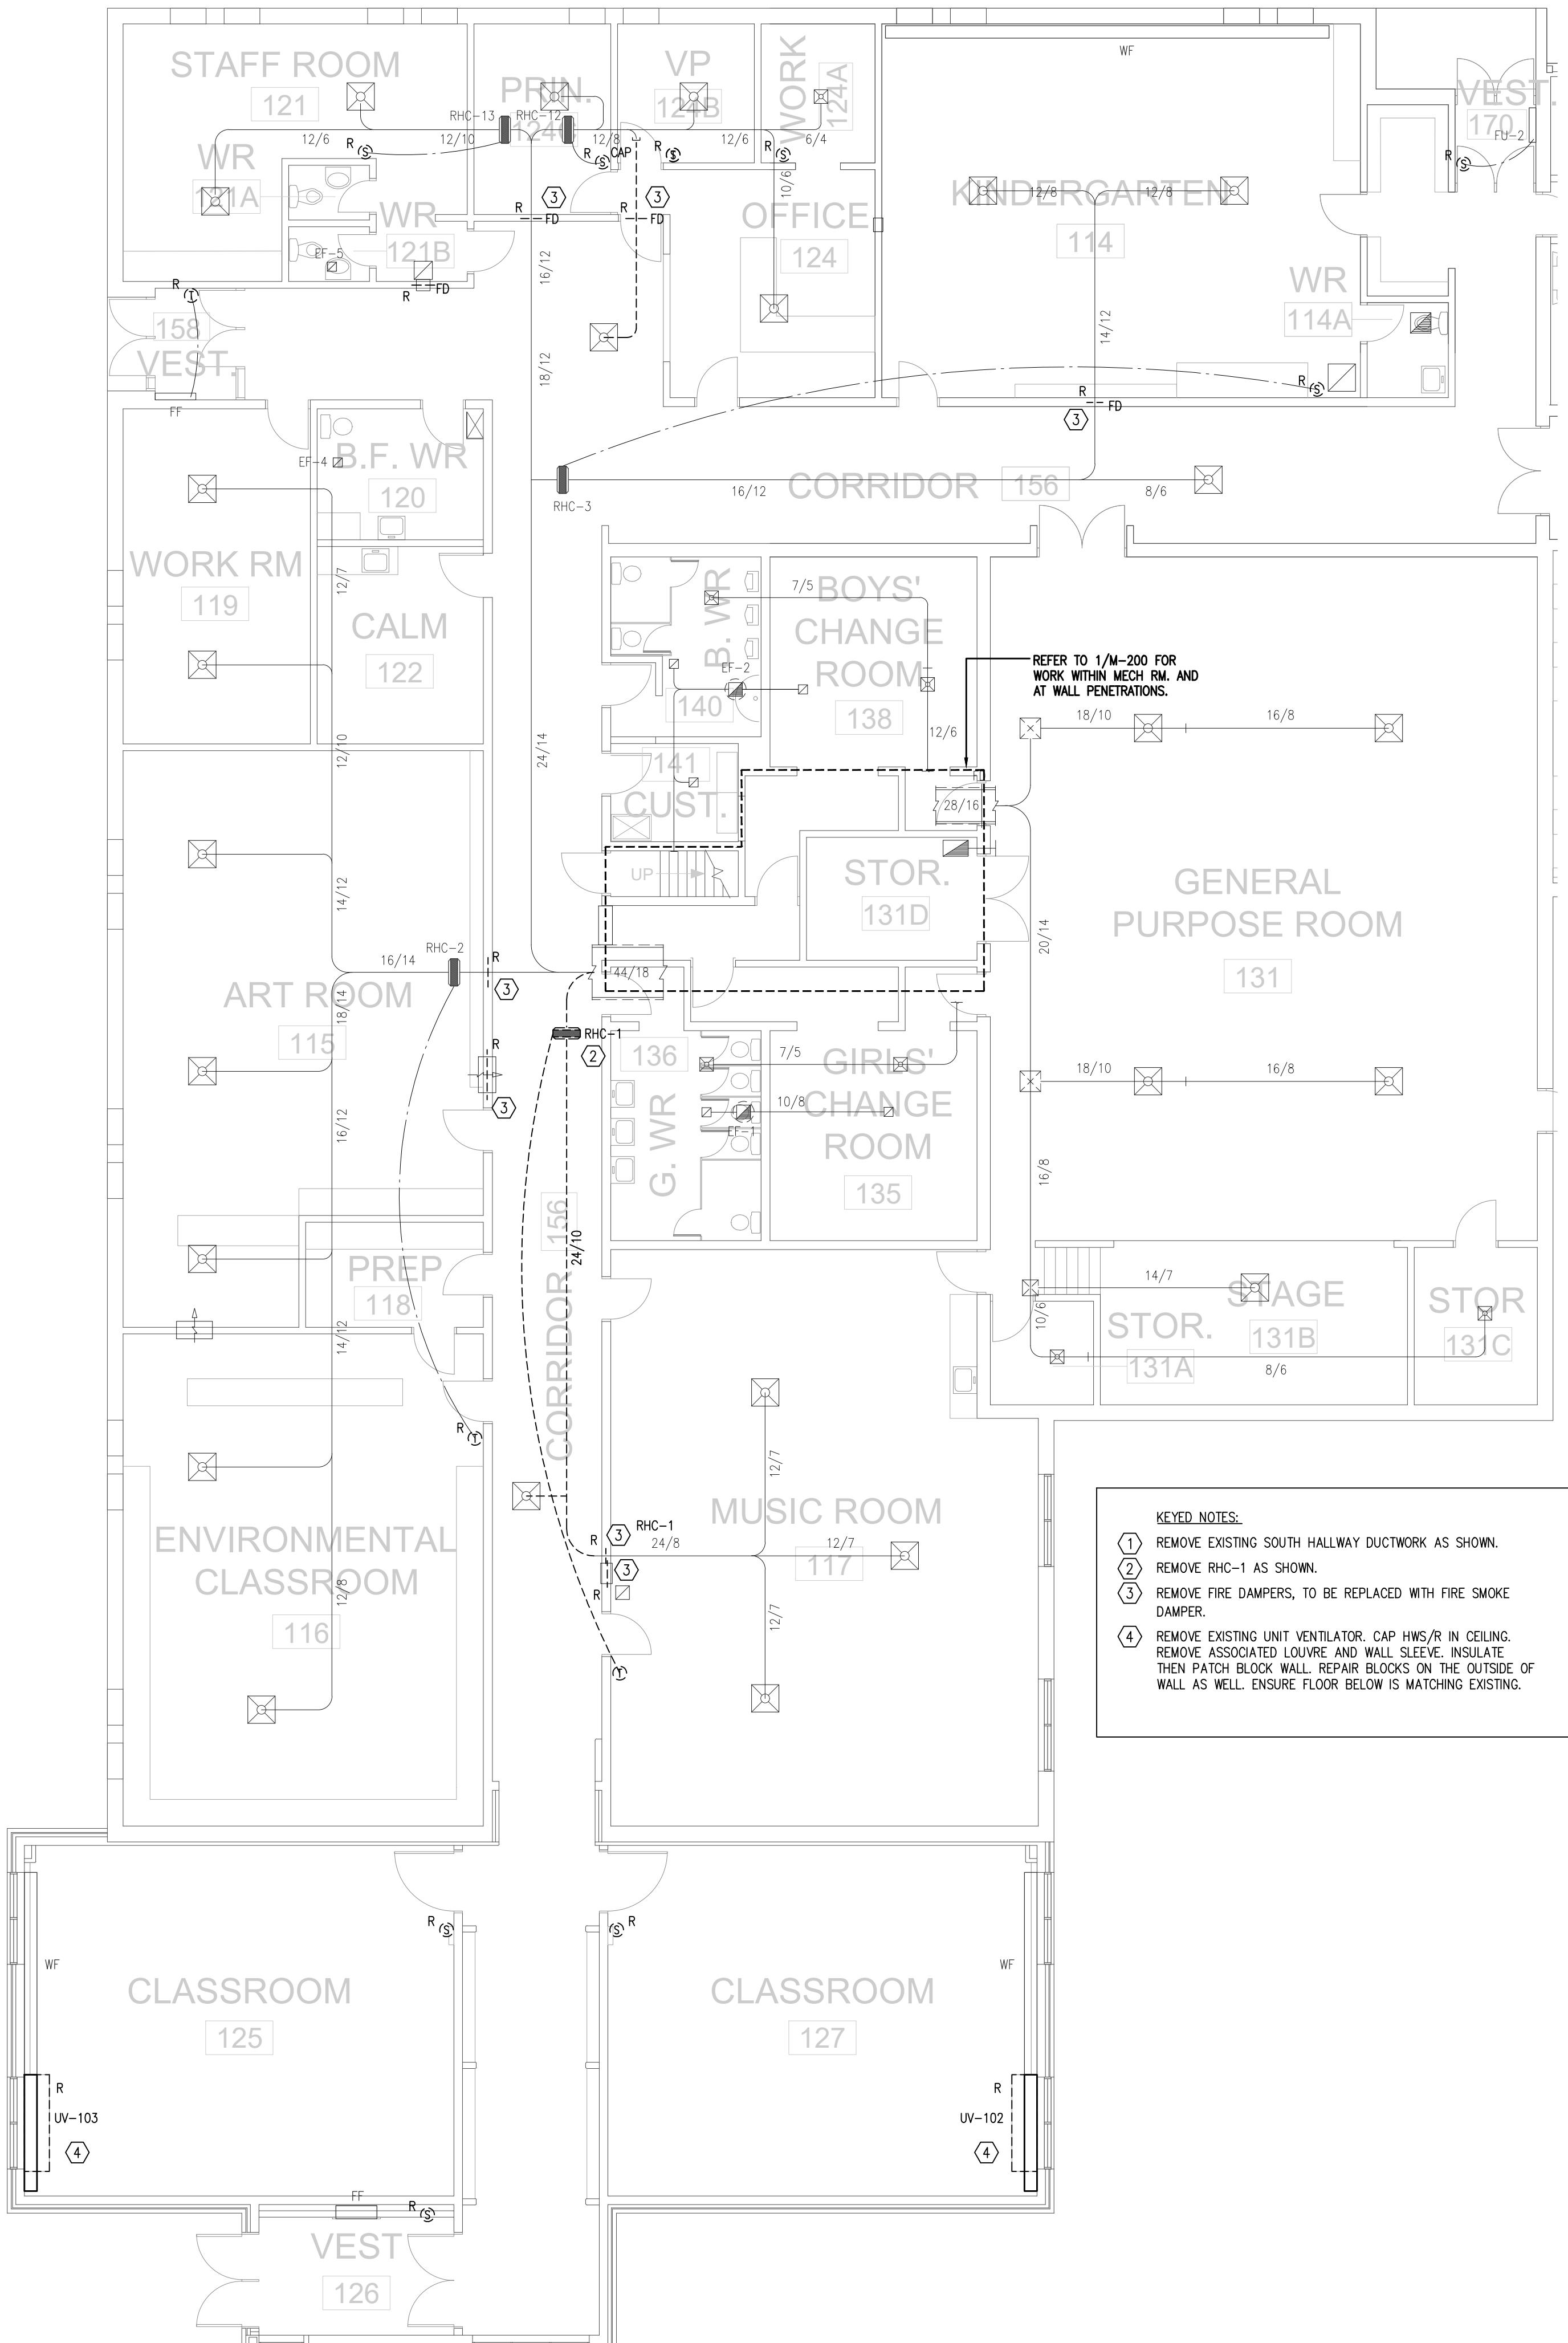

1
M-202 SOUTH CLASSROOMS - DEMO
SCALE: 1/8"=1'-0"

M-202 SCALE: 1/8 - 1 -0

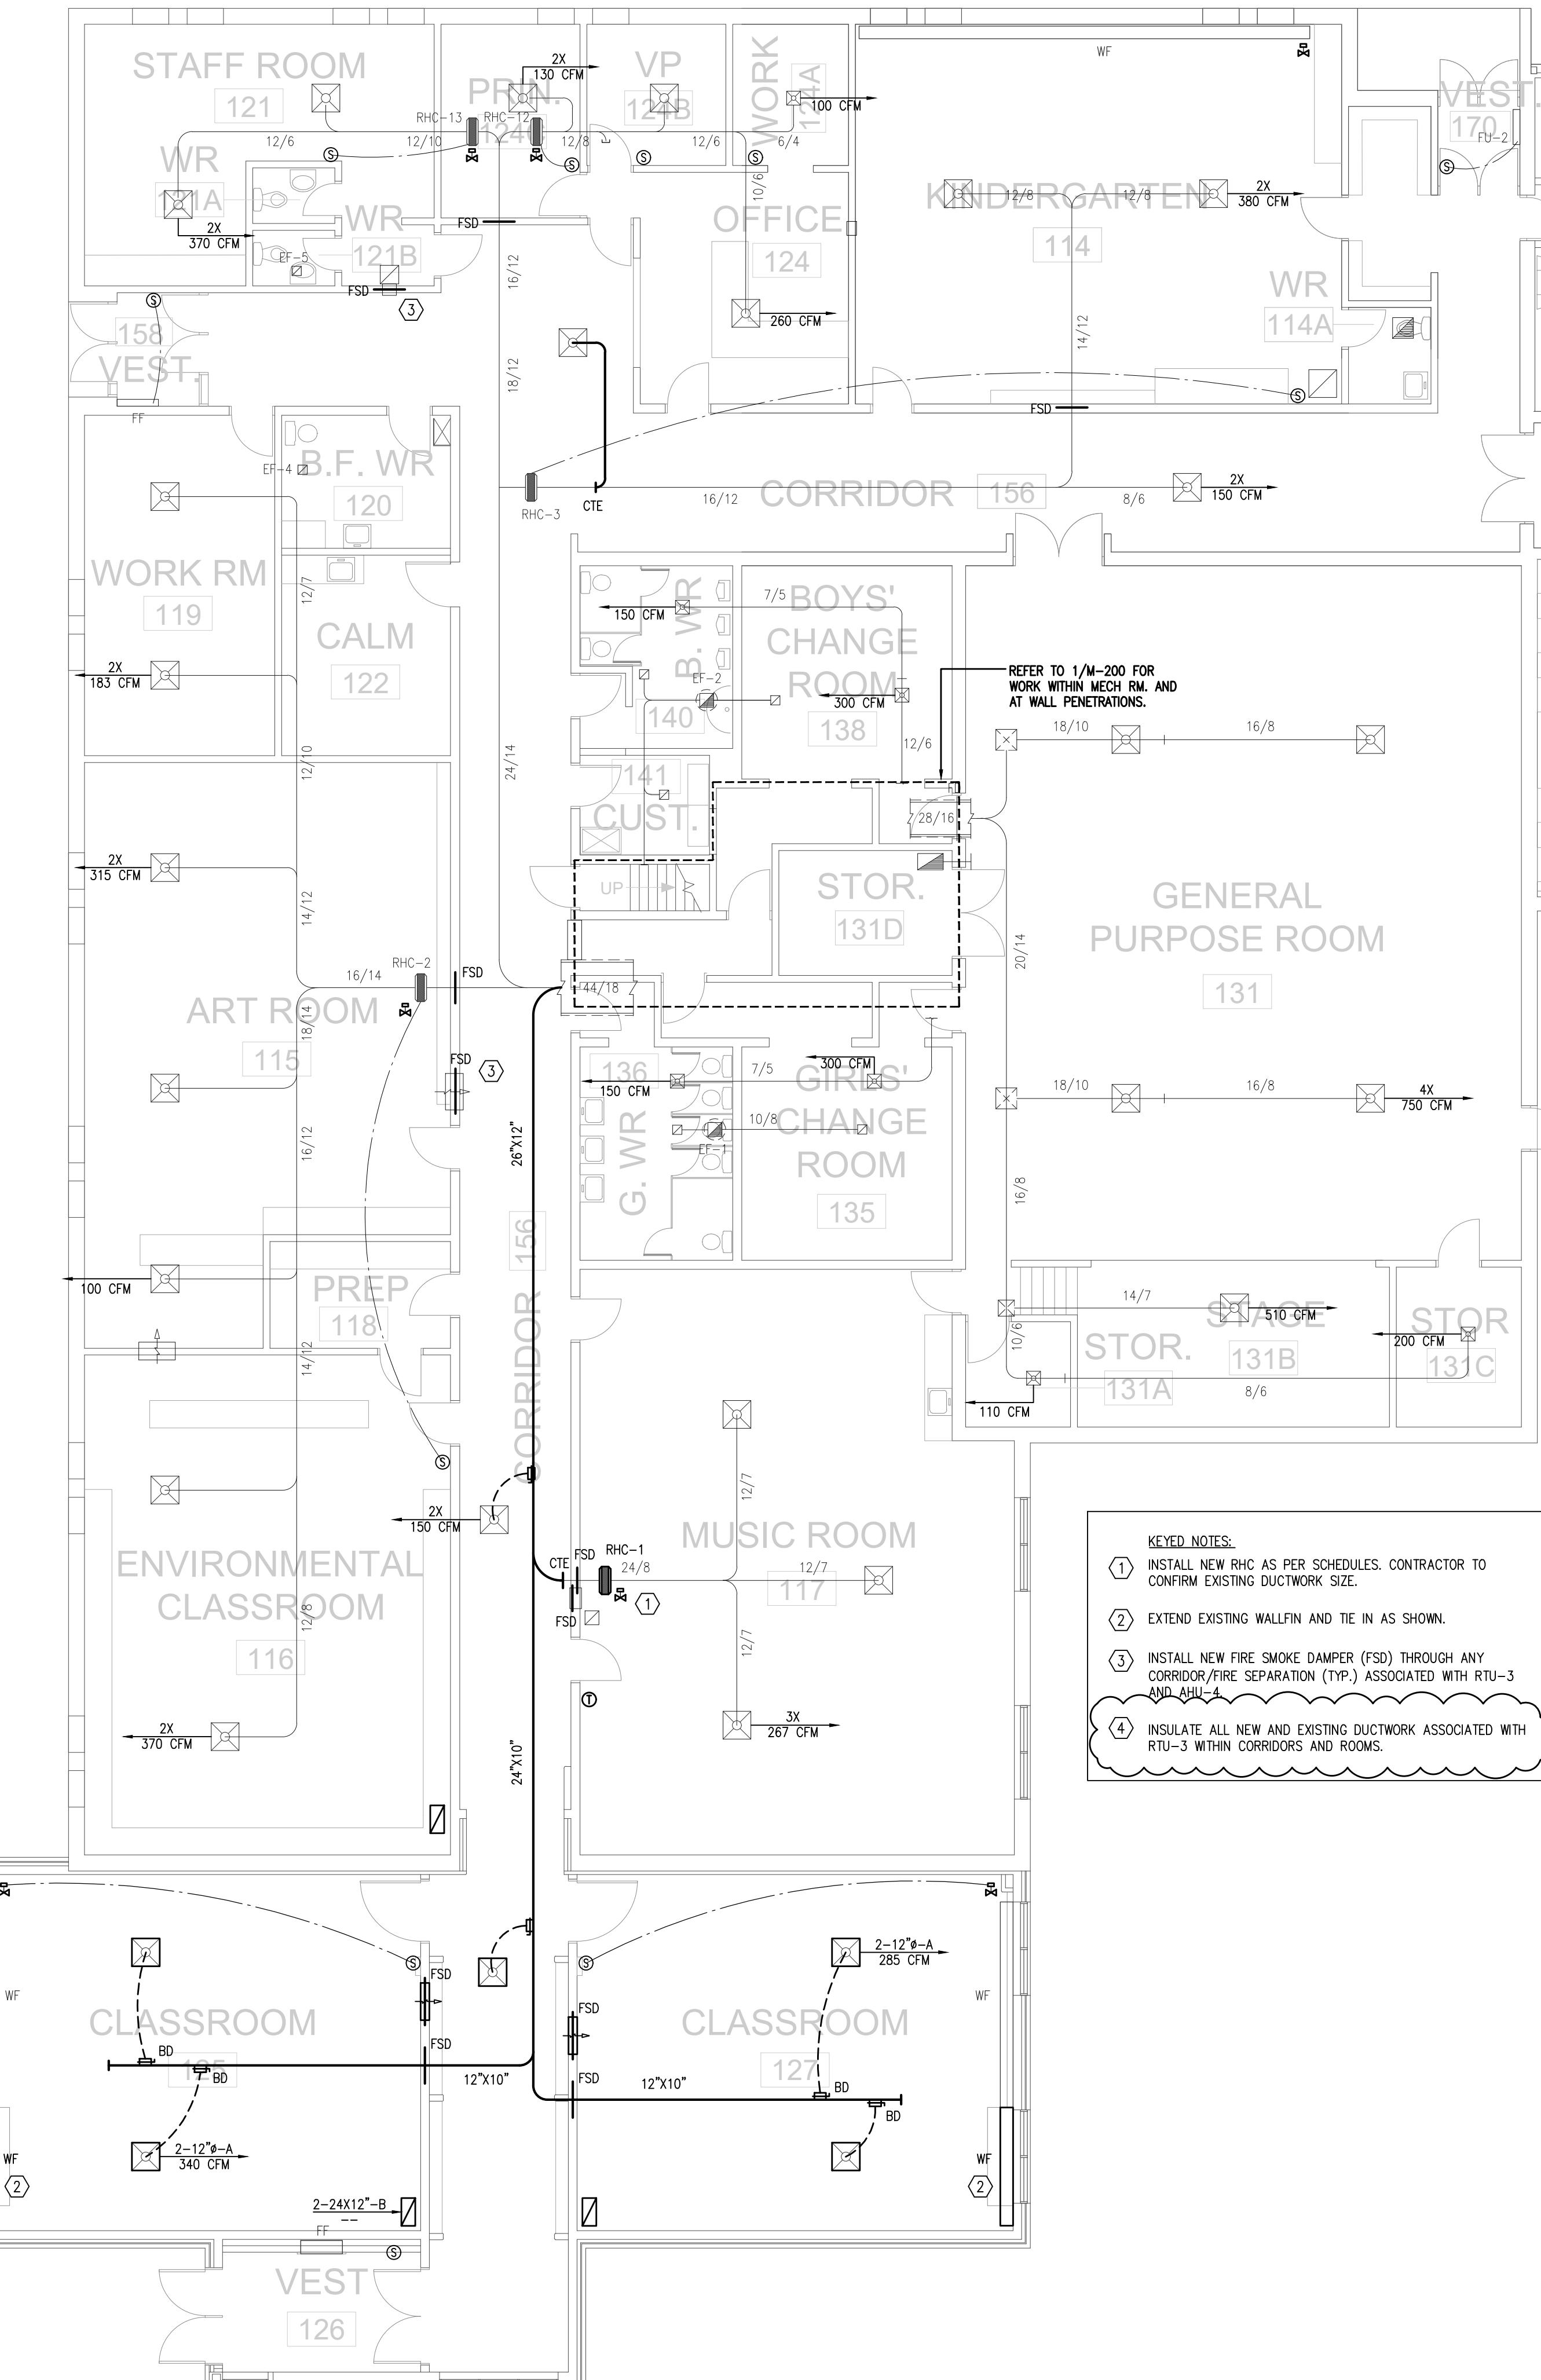

2 SOUTH CLASSROOMS - NE
M-202 SCALE: 1/8"=1'-0"

M-202 SCALE: 1/8 -1-0

| 2 | ISSUED FOR MECH ADD-001 | ME | 12/23/25 |
|--------------------|-------------------------|----|----------|
| 1 | ISSUED FOR TENDER | ME | 12/17/25 |
| No. | DESCRIPTION | BY | DATE |
| REVISIONS / STATUS | | | |

REVISIONS / STATUS

PROJECT: **VAUGHAN WILLARD P.S. AULI REPLACEMENT**

Project No: 35

Scale: AS NOTED

Drawn by: GPC

Checked by: ME



Address: 1911 Dixie Rd N, Pickering, ON L1V 1V4

TITLE:

SOUTH CLASSROOMS - DEMO/NEW



DDSB
Ignite Learning

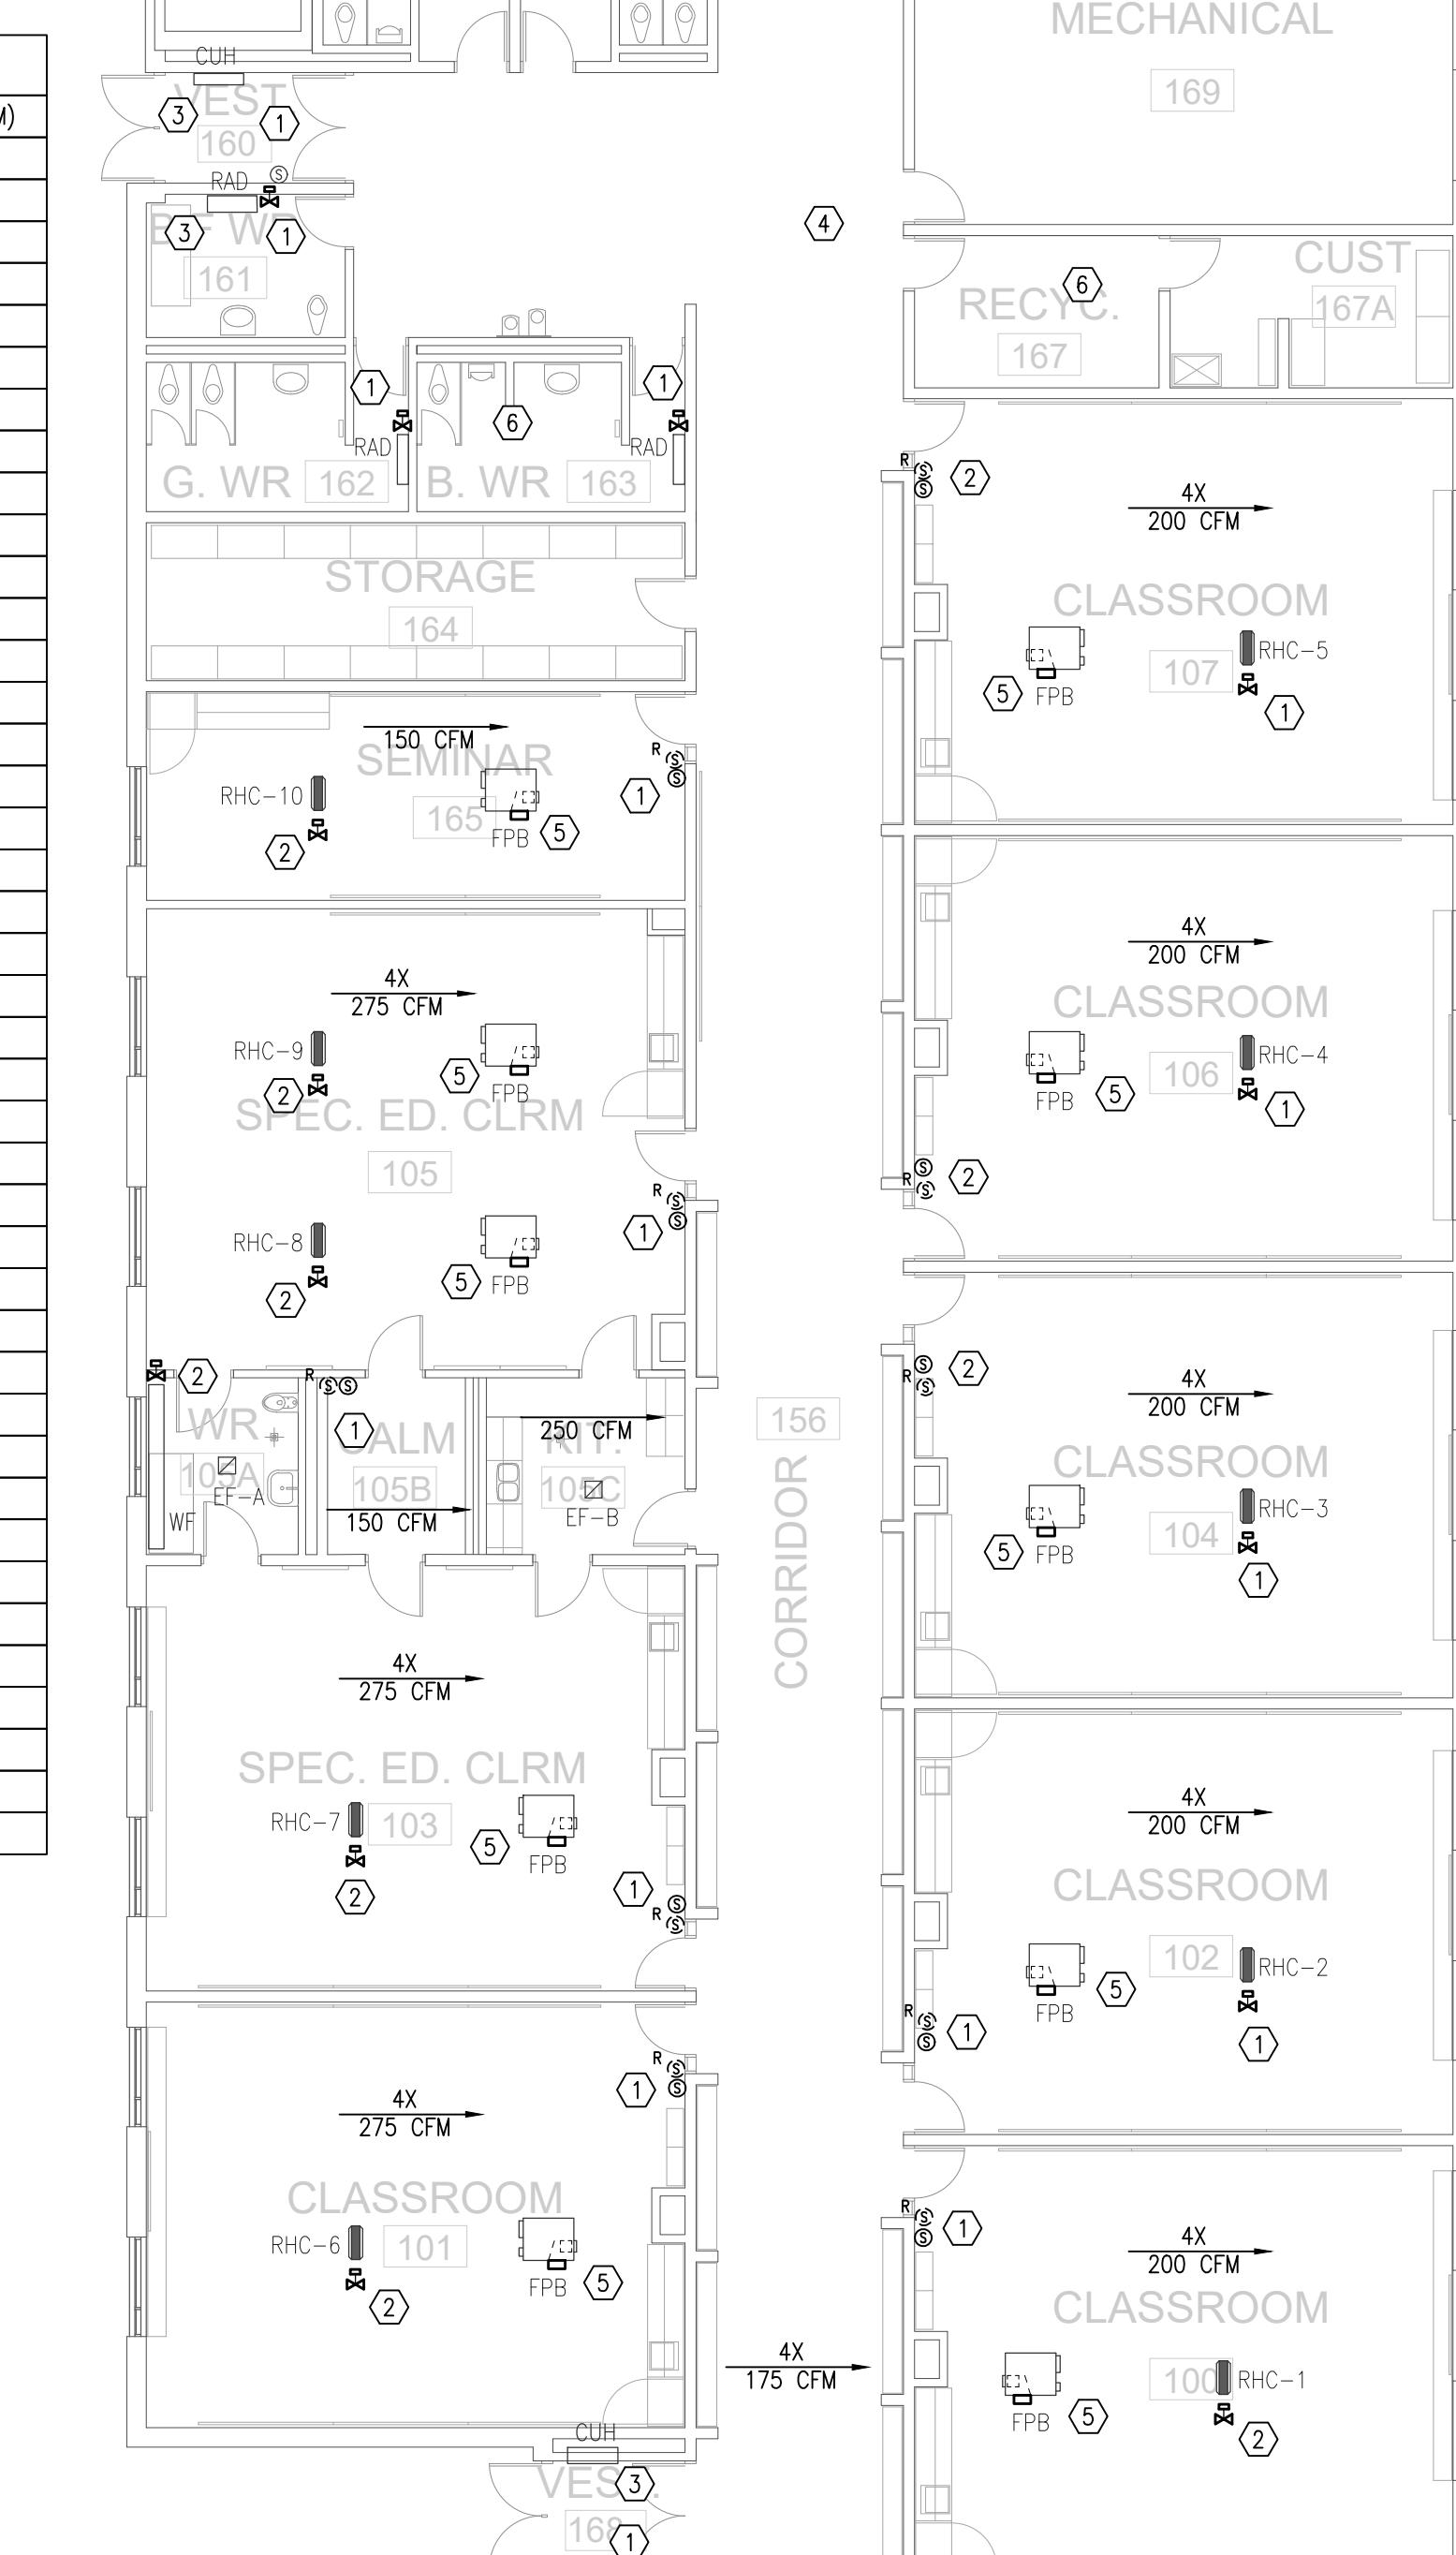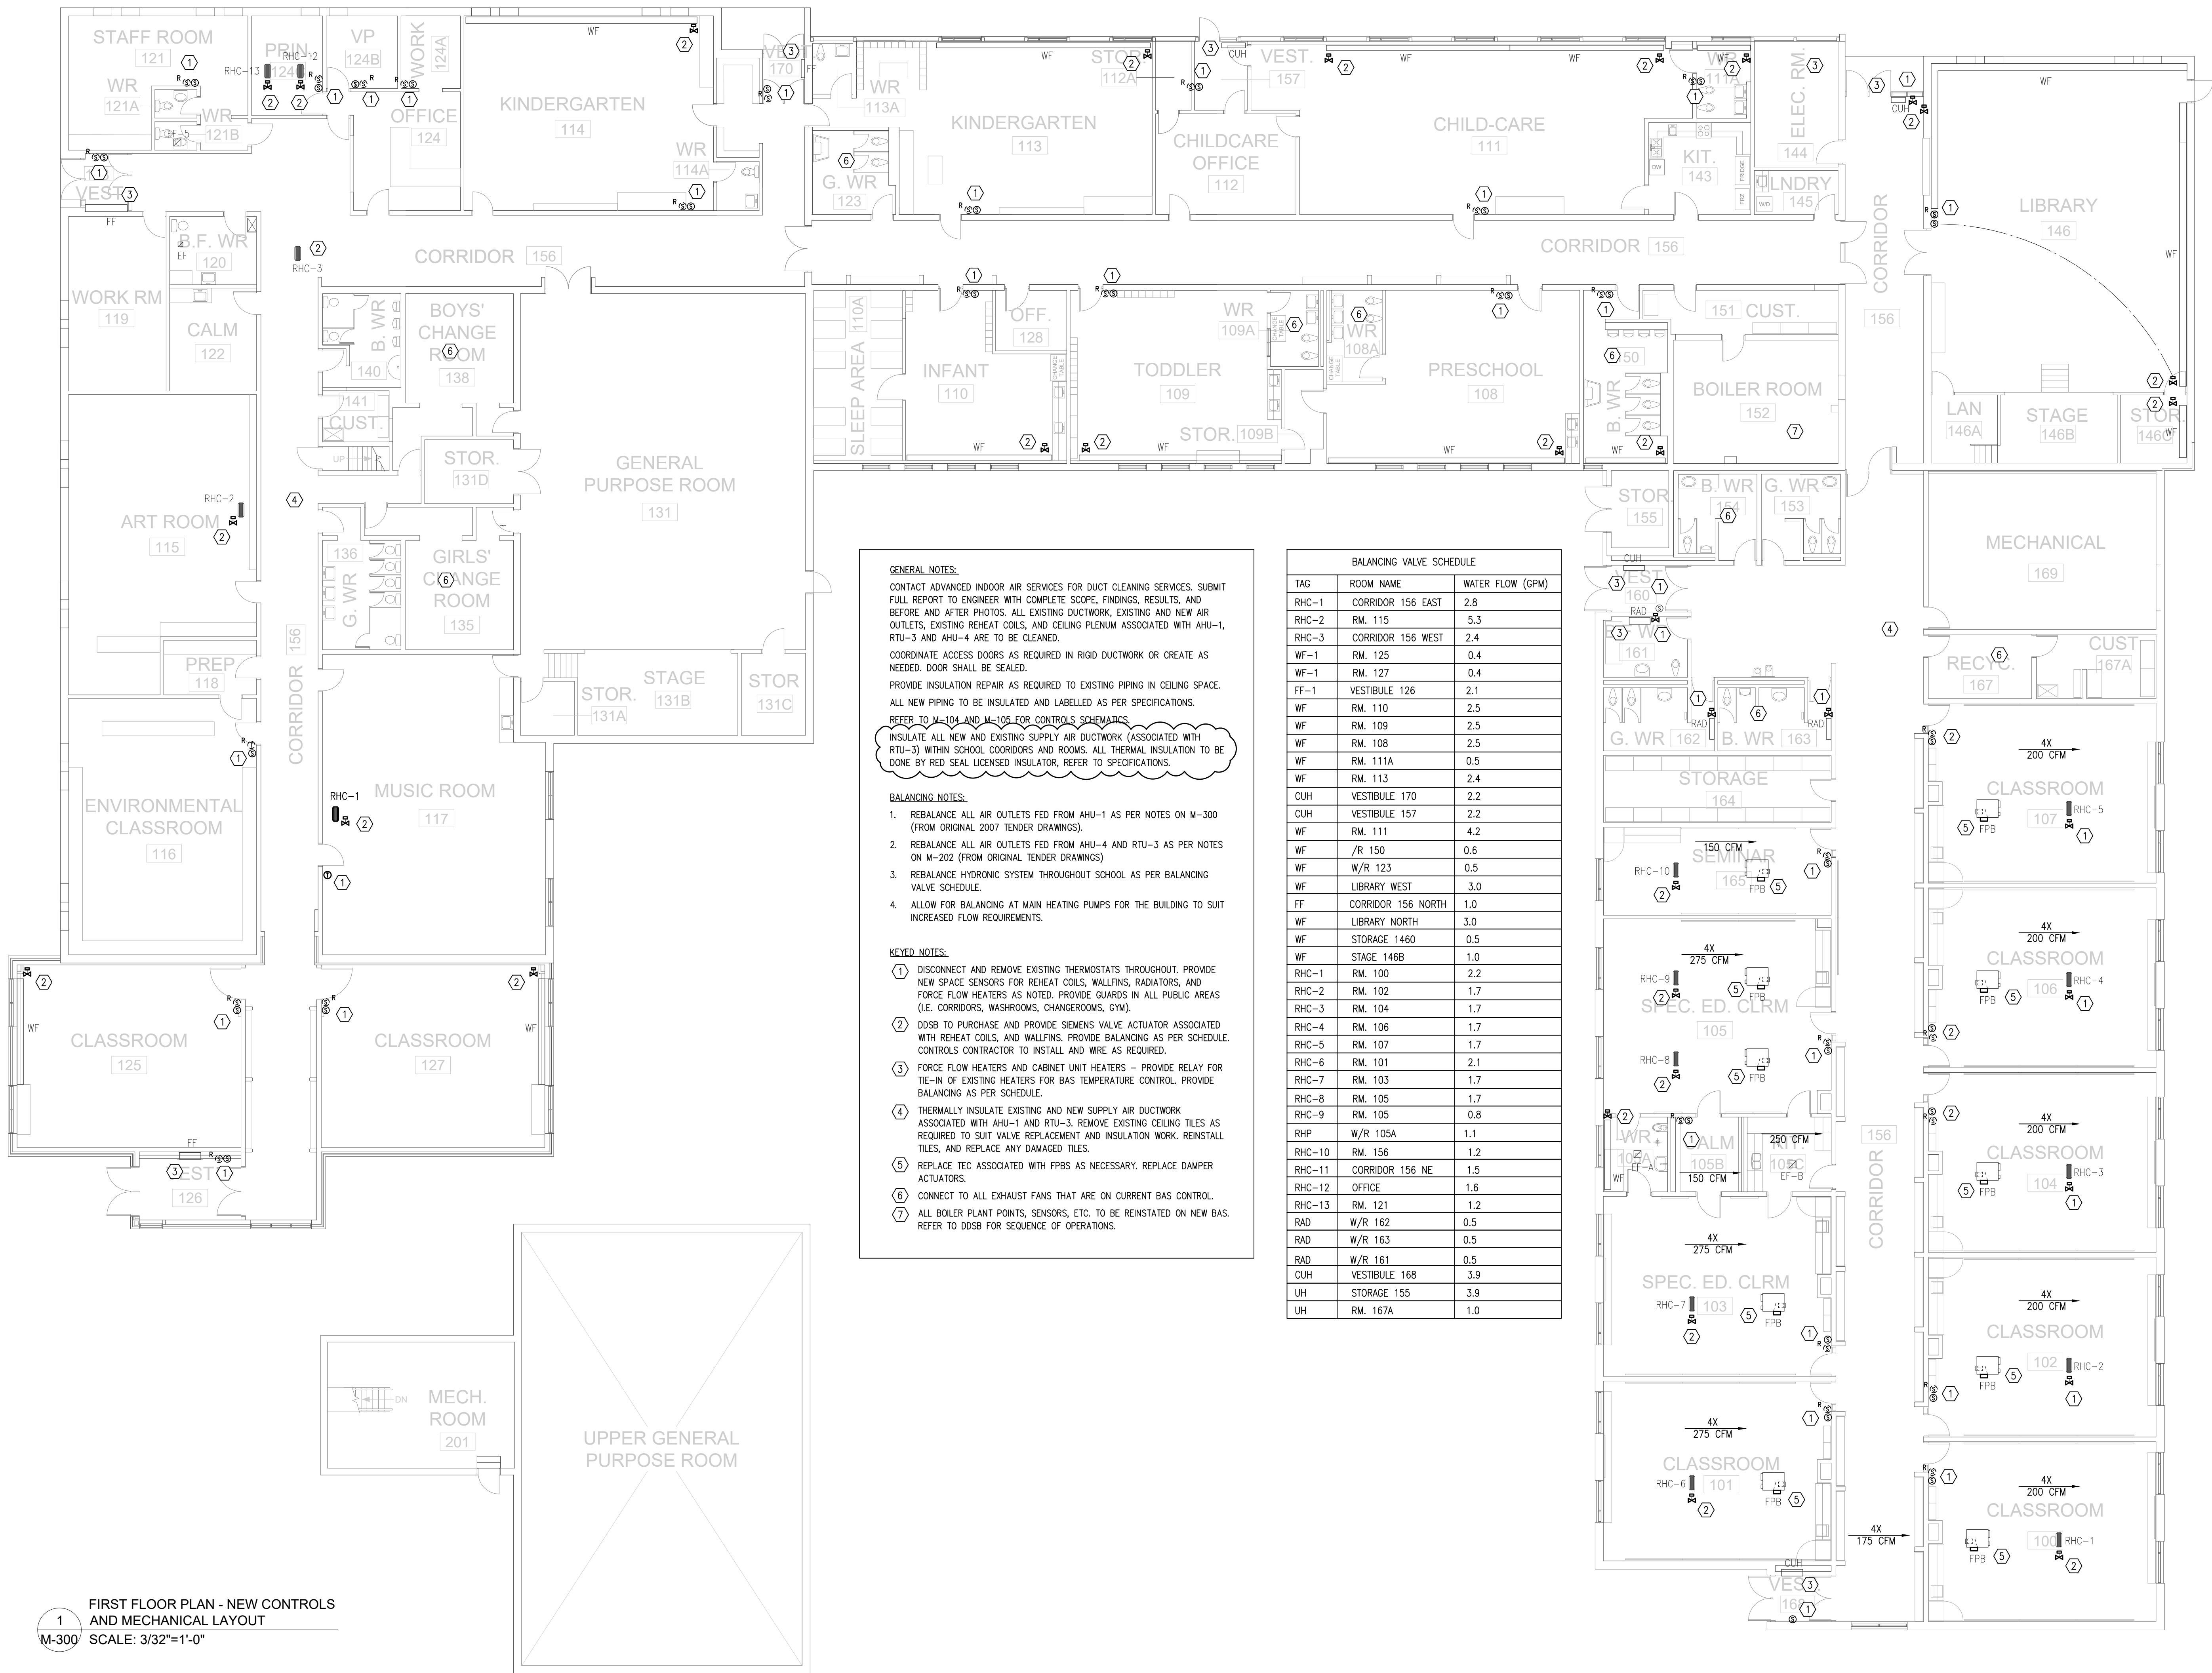

| No. | DESCRIPTION | BY | DATE |
|-----|-------------------------|----|----------|
| 02 | ISSUED FOR MECH ADD-001 | ME | 12/23/25 |
| 01 | ISSUED FOR TENDER | ME | 12/17/25 |

REVISIONS / STATUS


PROJECT:
VAUGHAN WILLARD P.S.
- AHU REPLACEMENT

Project No: 25-14


 Scale: AS NOTED
 Drawn by: GPC
 Checked by: ME
 Address: 1911 Dixie Rd N, Pickering, ON L1V 1V4

 TITLE:
FIRST FLOOR PLAN - NEW CONTROLS AND MECHANICAL LAYOUT

DRAWING No:

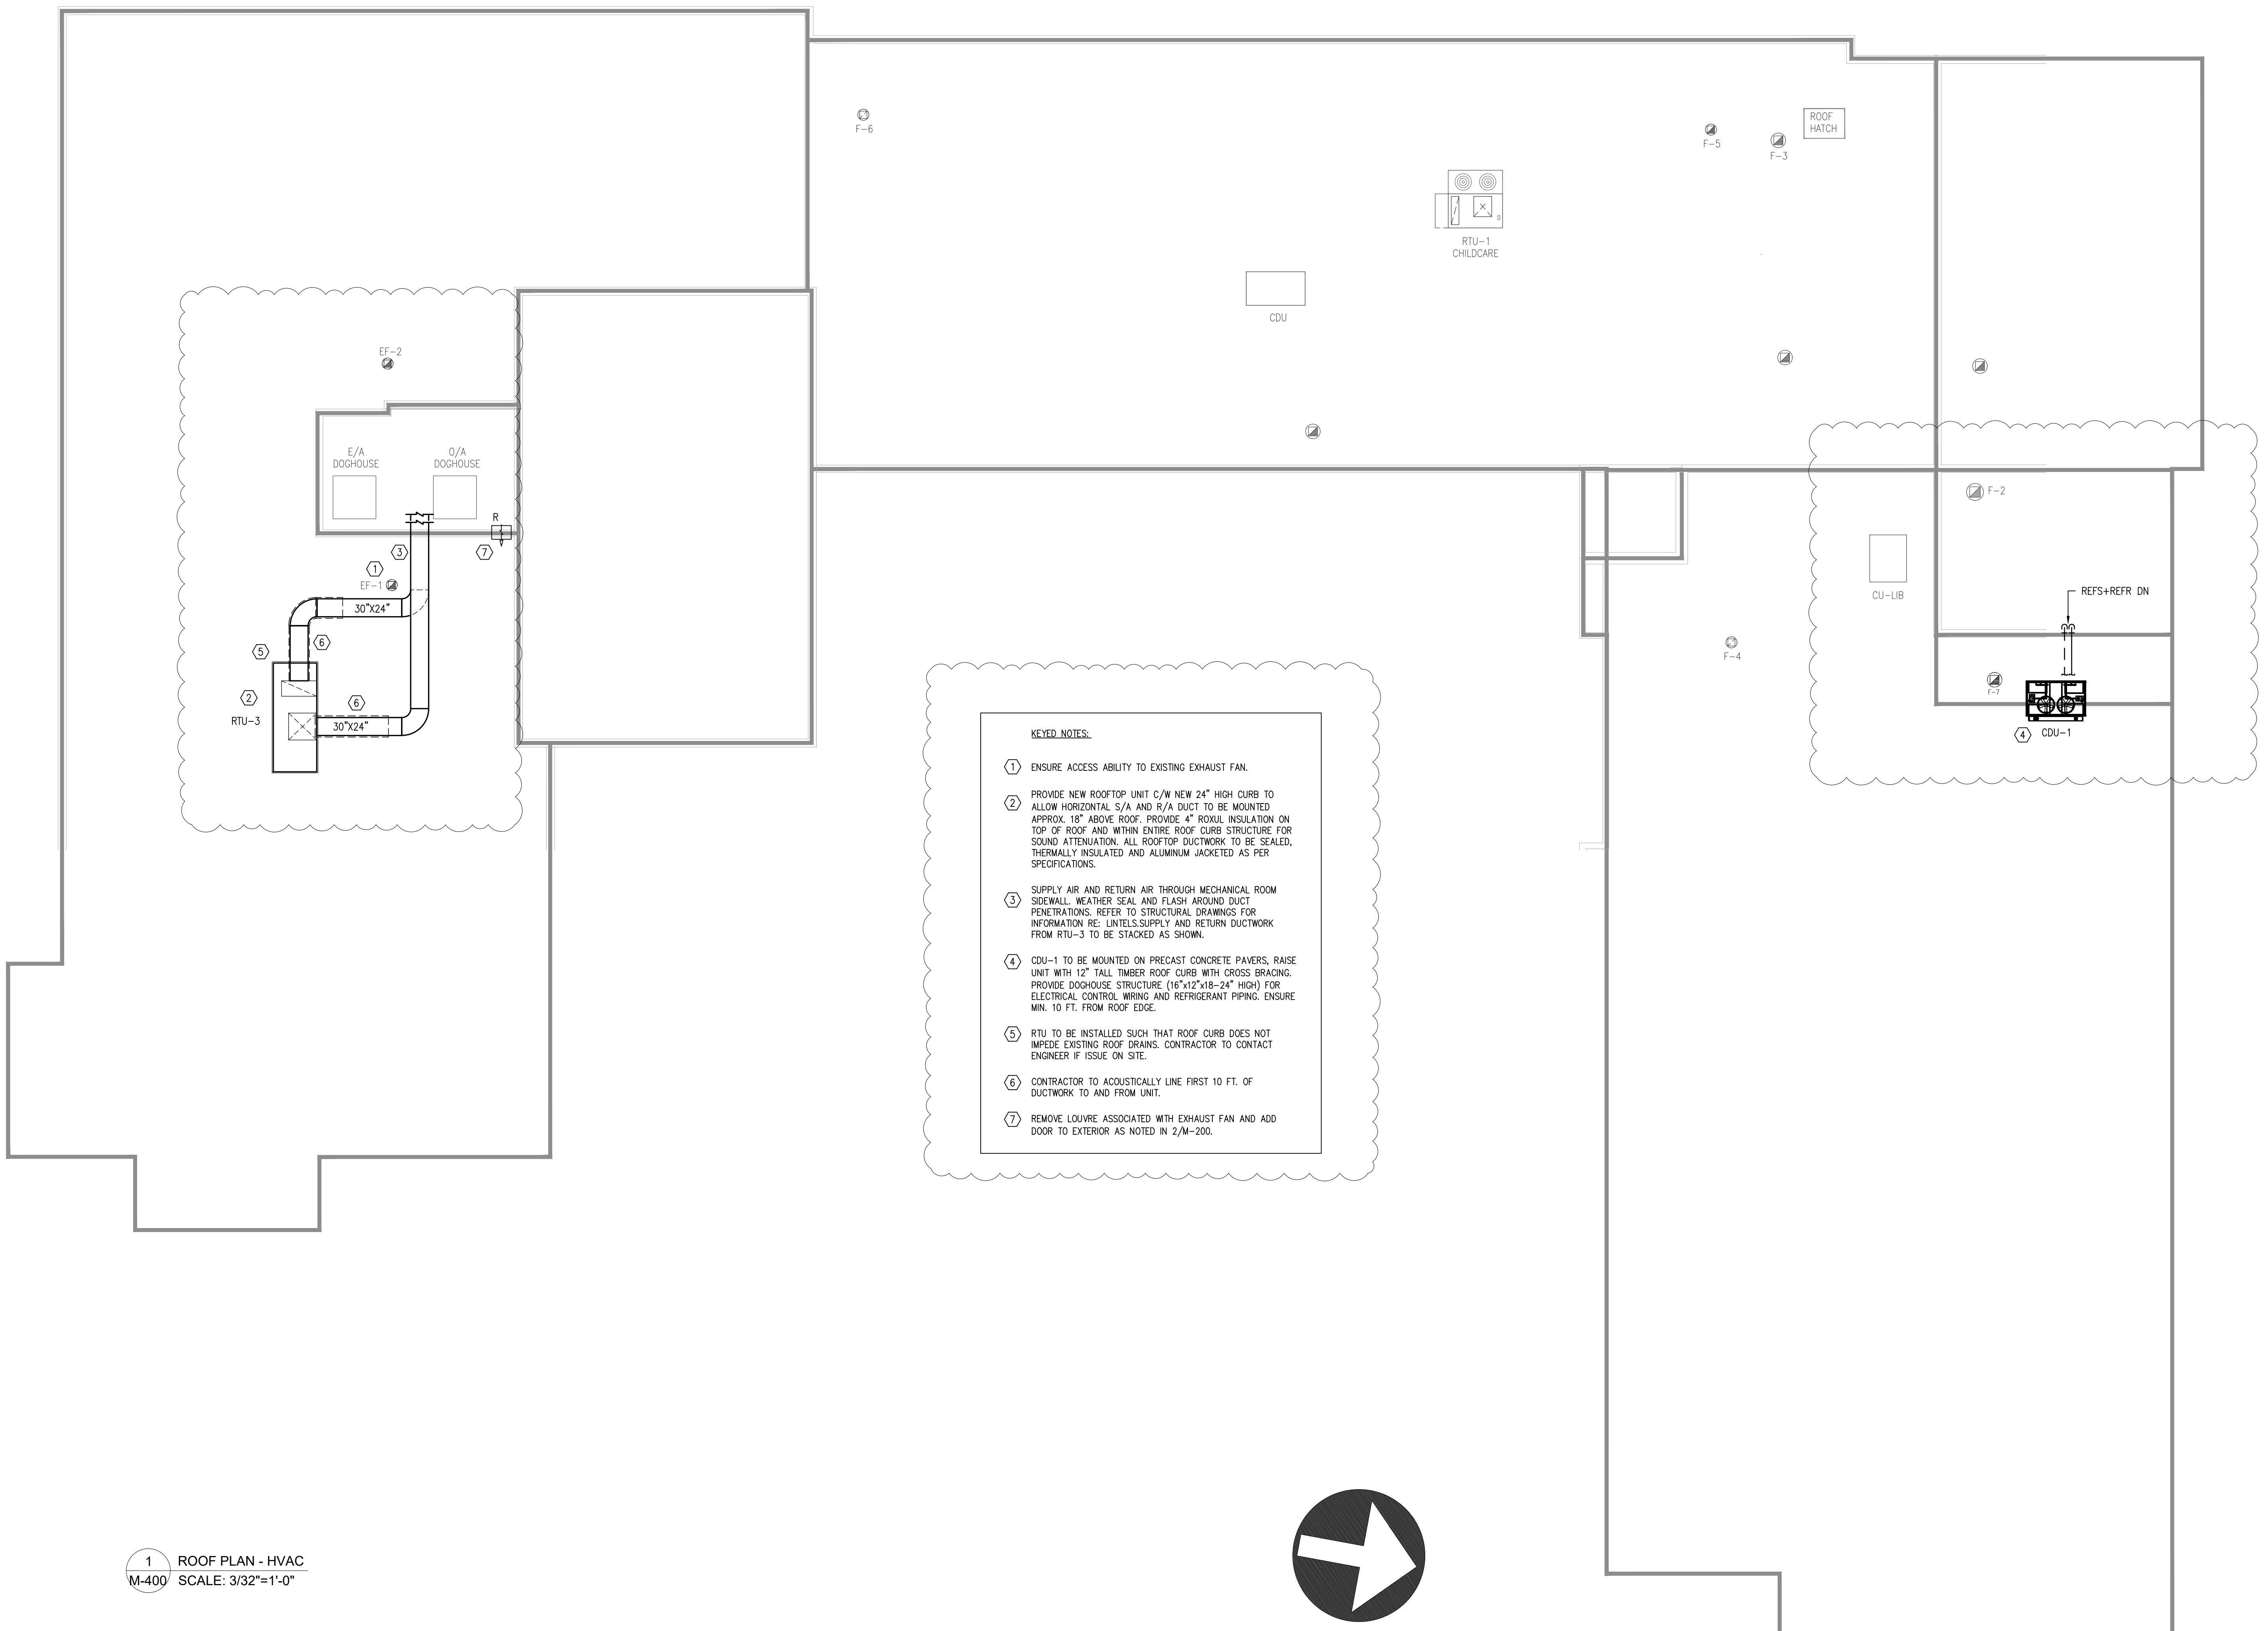

1
M-400
ROOF PLAN - HVAC
SCALE: 3/32"=1'-0"

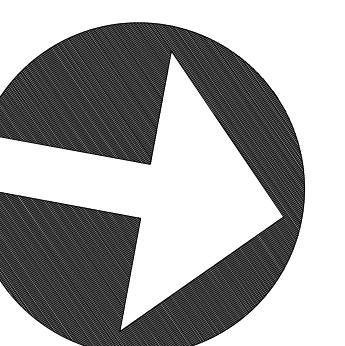

| | | | |
|-----|-------------------------|----|----------|
| 02 | ISSUED FOR MECH ADD-001 | ME | 12/23/25 |
| 01 | ISSUED FOR TENDER | ME | 12/17/25 |
| No. | DESCRIPTION | BY | DATE |

REVISIONS / STATUS


PROJECT:
VAUGHAN WILLARD P.S.
- AHU REPLACEMENT

Project No: 25-14

Scale: AS NOTED
Drawn by: GPC
Checked by: ME
Address: 1911 Dixie Rd N, Pickering, ON L1V 1V4

TITLE:
ROOF PLAN - HVAC

DRAWING No:

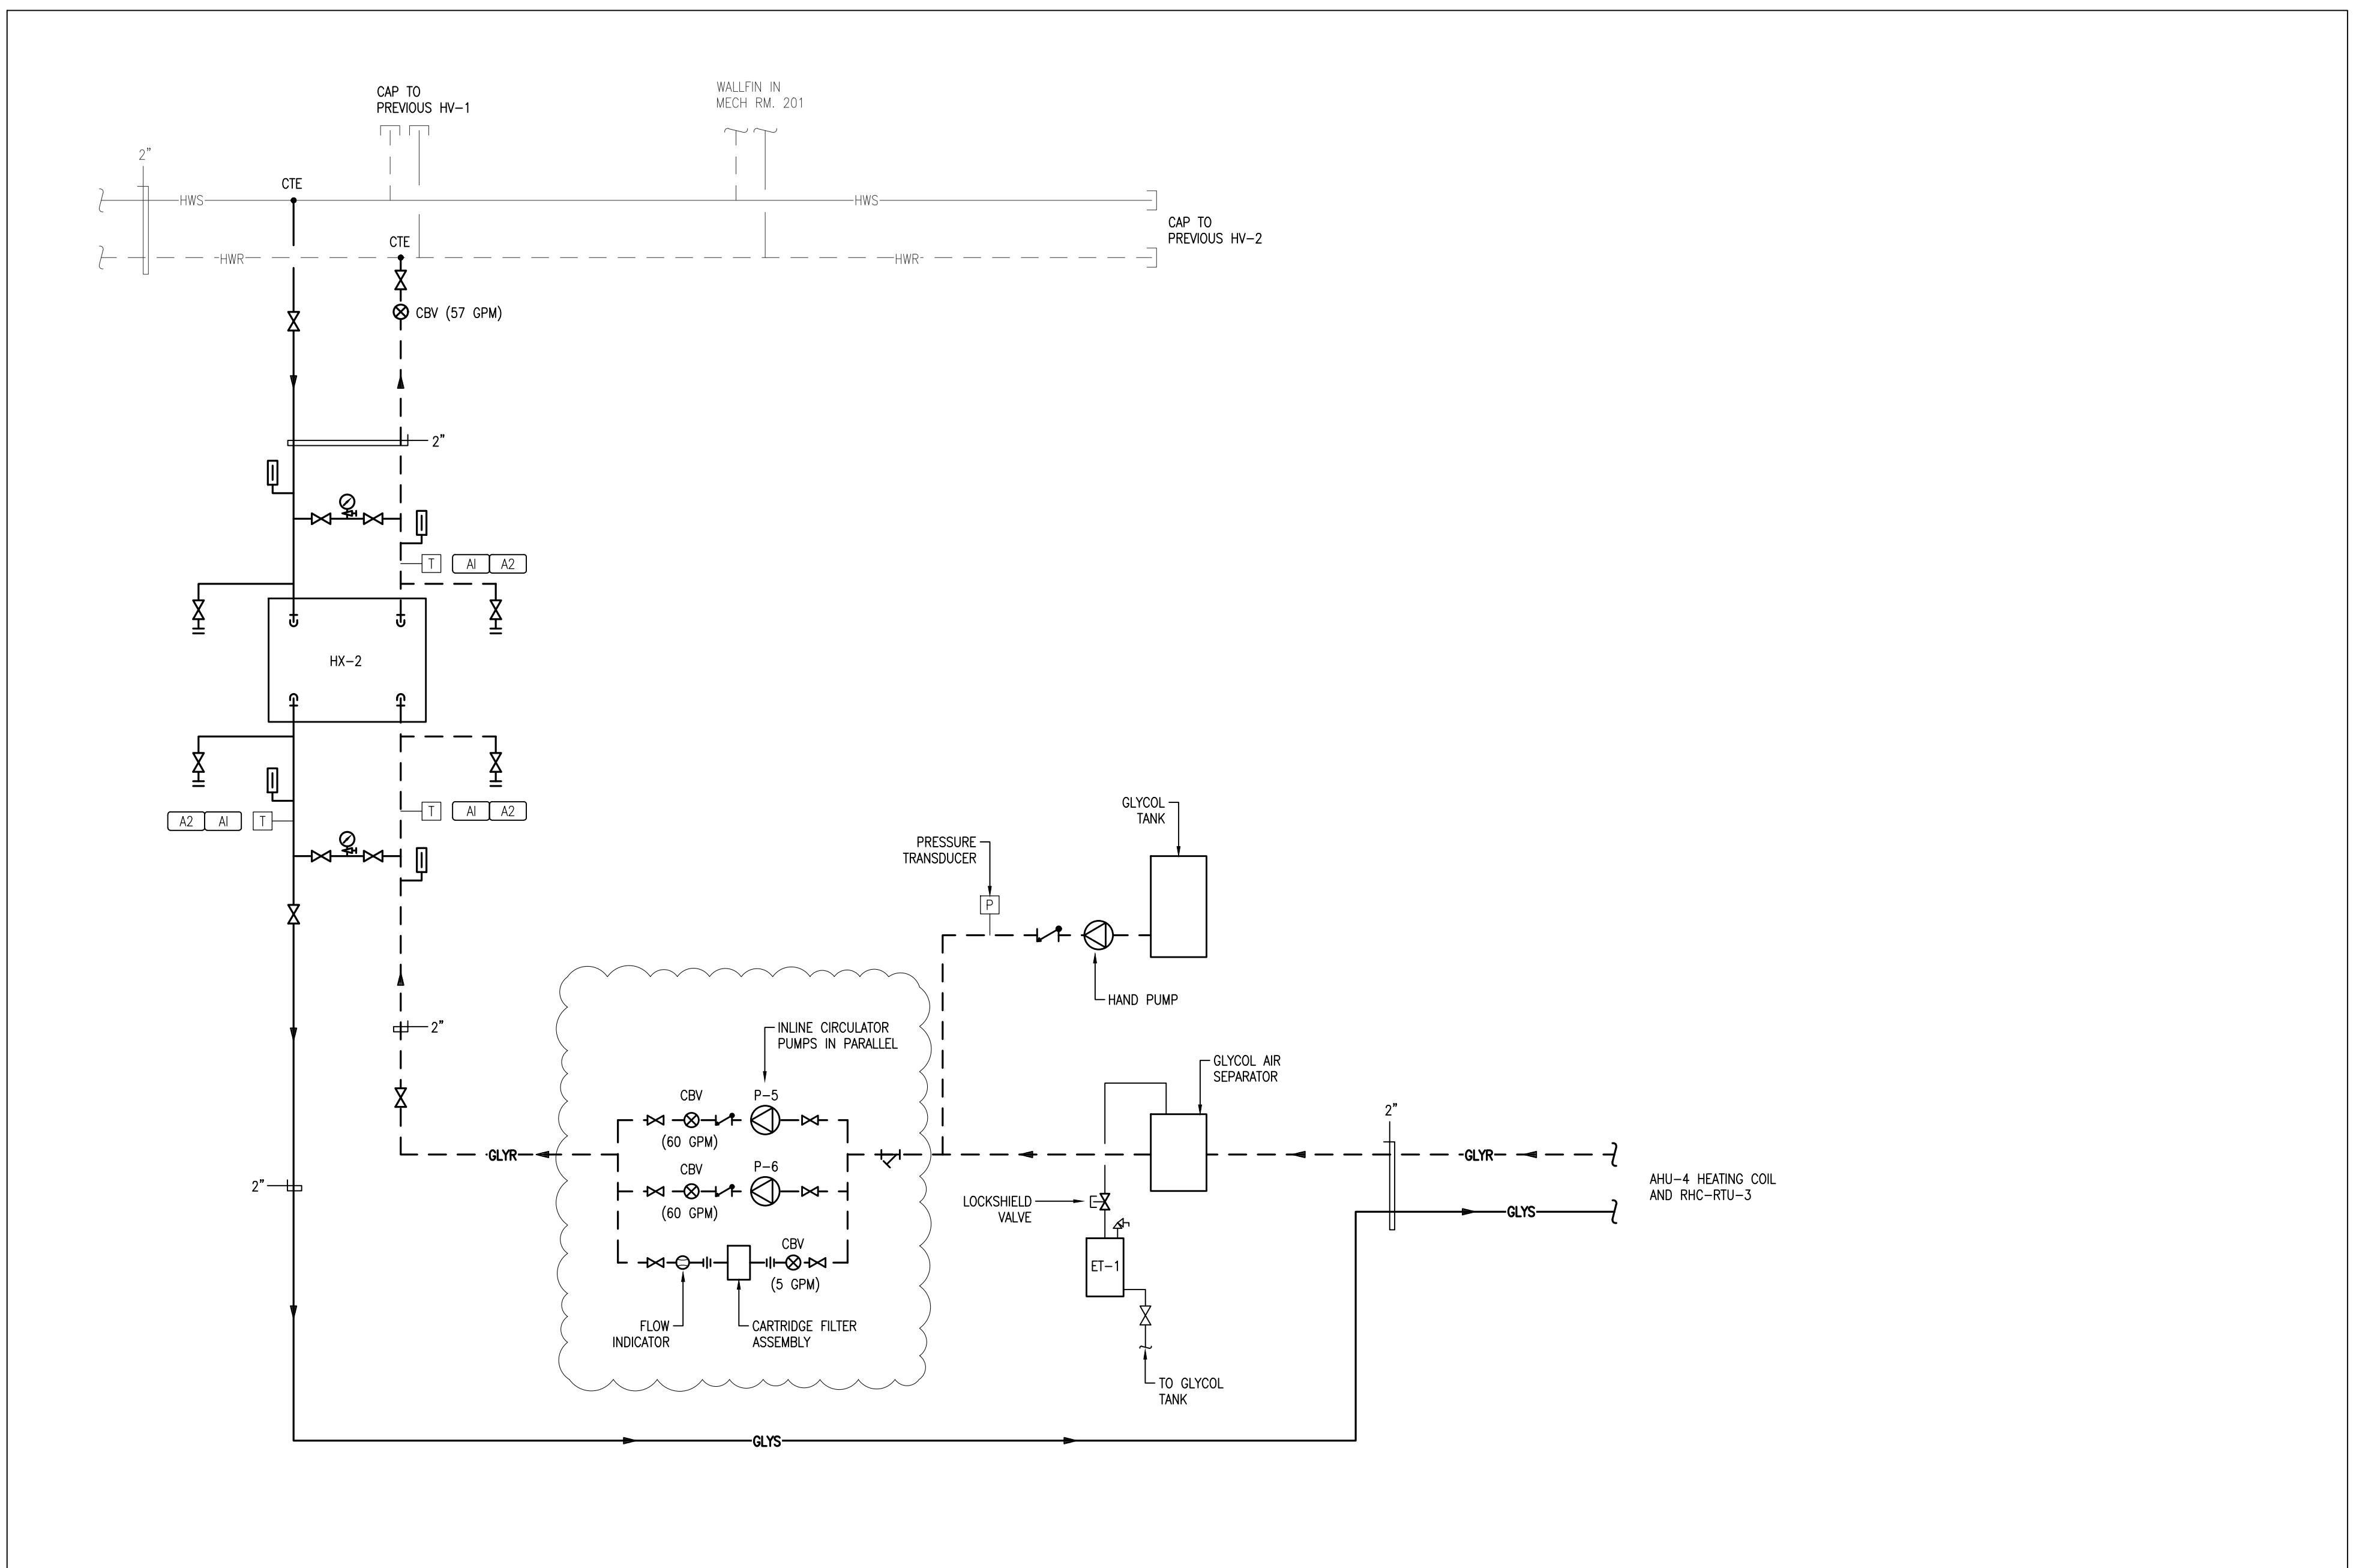

1 GLYCOL SCHEMATIC FLOW DIAGRAM — RM. 201
 M-500

| | | | |
|-------------------------|-------------------------|----|----------|
| 02 | ISSUED FOR MECH ADD-001 | ME | 12/23/25 |
| 01 | ISSUED FOR TENDER | ME | 12/17/25 |
| No. DESCRIPTION BY DATE | | | |

| |
|--------------------|
| REVISIONS / STATUS |
| |

| |
|--|
| |
| |

PROJECT:
VAUGHAN WILLARD P.S.
- AHU REPLACEMENT

Project No: 25-14

Scale: AS NOTED
 Drawn by: GPC
 Checked by: ME
 Address: 1911 Dixie Rd N, Pickering, ON L1V 1V4

TITLE:
SCHEMATICS

SPECIFICATION NOTES:

DRAWINGS ARE PERFORMANCE IN INTENT AND DIAGRAMMATIC IN NATURE.

PROVIDE ALL PRODUCTS AND LABOUR TO PERFORM COMPLETELY THE WORK AS SHOWN OR REQUIRED TO MEET THE DESIGN INTENT, AT NO EXTRA COST.

PERFORM ALL WORK IN CONFORMANCE TO BUILDING CODE, ELECTRICAL SAFETY CODE, LOCAL ELECTRICAL INSPECTOR'S REQUIREMENTS AND ALL MUNICIPAL BY-LAWS.

DO NOT REDUCE STANDARDS SET BY THESE DRAWINGS BY APPLYING CODES.

EXAMINE SITE FOR CONDITIONS AFFECTING WORK. NO EXTRA COST SHALL BE ALLOWED FOR CONSIDERATIONS OVERLOOKED.

APPLY FOR ALL PERMITS, SERVICES AND INSPECTIONS AND PAY ALL RELATED FEES.

SUBMIT SHOP DRAWINGS TO CONSULTANT FOR ALL ELECTRICAL EQUIPMENT FOR REVIEW AND COMMENTS.

CARRY OUT WORK IN CONFORMANCE TO BASE BUILDING STANDARDS.

MAKE ANY ADJUSTMENTS, REROUTINGS OR RELOCATIONS TO EXISTING ELECTRICAL PRODUCTS AS REQUIRED. PROVIDE SUCH ADJUSTMENTS AT NO EXTRA COST.

BECOME FULLY FAMILIAR WITH EXISTING BUILDING SYSTEMS & EQUIPMENT OPERATIONS. PROVIDE ALL REQUIRED PRODUCTS TO MAKE NEW WORK FULLY OPERATIONAL TO MEET DESIGN INTENT.

INCLUDE IN QUOTED PRICE FOR ALL ALTERATIONS TO EXISTING BUILDING SYSTEMS AND ANY INSTALLED PRODUCTS AFFECTED IN INTERFACING NEW WORK.

MAINTAIN ALL BUILDING SERVICE IN OPERATION. PROVIDE ALL TEMPORARY WIRING AND CONNECTIONS. SHUTDOWN SERVICES ONLY AS AUTHORIZED IN WRITING.

INCLUDE IN QUOTED PRICE FOR PREMIUM TIME WORK REQUIRED.

COORDINATE WORK WITH ALL OTHER TRADES PRIOR TO INSTALLATION. NOTIFY CONSULTANT OF ANY DISCREPANCIES.

TEST NEW AND EXISTING INTERFACED SYSTEMS TO ENSURE PROPER OPERATION. CORRECT ALL DEFICIENCIES.

REPAIR ANY SYSTEM DAMAGED DURING EXECUTION OF WORK.

PRODUCTS SHALL BE OF MANUFACTURE SPECIFIED. WHERE MANUFACTURE IS NOT SPECIFIED, PRODUCTS SHALL BE OF HIGH COMMERCIAL QUALITY AND SHALL BE CSA APPROVED FOR THE APPLICATION.

VERIFY LOADING OF EXISTING CIRCUITS TO BE REUSED. DO NOT EXCEED CODE REQUIREMENTS. VERIFY ON SITE EXISTING CIRCUITS USED, SPARE AND SPACES AVAILABLE WHERE EXISTING PANELS ARE TO BE REUSED. PROVIDE ADDITIONAL BREAKERS AND CIRCUITS AS NECESSARY.

ADJUST PANEL SCHEDULES TO REFLECT ANY CHANGES PERFORMED TO THE CIRCUITS.

ALL NEW BREAKERS SHALL BE BOLT-ON TYPE, 'SWD' RATED TO MATCH EXISTING.

ALL NEW DISCONNECT SWITCHES SHALL BE HEAVY DUTY QUICK-MAKE, QUICK BREAK ENCLOSED SAFETY SWITCHES.

PACK AND SEAL ALL PENETRATIONS THROUGH FLOORS AND FIRE RATED WALLS WITH APPROVED MATERIAL TO RETAIN FIRE RATING.

PROVIDE ALL CUTTING AND PATCHING REQUIRED TO EFFECT WORK WITH THE PRIOR APPROVAL AND INSTRUCTION OF THE OWNER'S REPRESENTATIVE.

WIRE NEW POWER OUTLETS IN EMT CONDUIT.

DO ALL REQUIRED WORK RELATED TO LIFE SAFETY SYSTEMS AT NO EXTRA COST. RETAIN THE SYSTEM MANUFACTURER'S FORCES TO PERFORM FINAL CONNECTIONS, MODIFICATIONS AND PROVISION OF NEW INTERFACING DEVICES IN THE SYSTEM PANELS.

ENSURE FULL COMPATIBILITY OF ALL NEW DEVICES WITH EXISTING LIFE SAFETY SYSTEMS.

HAVE SYSTEM MANUFACTURER TEST AND CERTIFY LIFE SAFETY SYSTEMS FOR PROPER OPERATION AT COMPLETION OF WORK. PROVIDE COMPLETE SYSTEM VERIFICATION TO SUIT LOCAL AUTHORITIES.

DO NOT SCALE DRAWINGS. FOR EXACT LOCATIONS REFER TO ARCHITECTURAL DRAWINGS AND VERIFY ON SITE ALL DIMENSIONS PRIOR TO INSTALLING PRODUCTS.

ADJUST LOCATION OF PRODUCTS UP TO 3m (10 FT) IN ANY DIRECTION AS DIRECTED AT NO EXTRA COST, PROVIDED THE CHANGES ARE REQUESTED PRIOR TO INSTALLATION.

INCLUDE FOR ANY ADDITIONAL COSTS INCURRED BY OTHER TRADES RESULT-ING FROM SUBSTITUTING ANY ALTERNATIVE EQUIPMENT.

PROVIDE RECORD DRAWINGS OF THE AS-CONSTRUCTED WORK. OBTAIN AND PAY FOR ONE (1) SET OF MYLAR SEPIAS. SUBMIT SEPIAS AND ONE (1) SET OF PRINTS FOR APPROVAL.

PROVIDE A FULLY ITEMIZED BREAKDOWN OF LABOUR AND MATERIAL FOR EXTRA OR DELETED WORK.

ARRANGE FOR INSPECTION OF WORK BY INSPECTION AUTHORITY. PROVIDE A FINAL UNCONDITIONAL CERTIFICATE OF APPROVAL.

PROVIDE A WRITTEN GUARANTEE FOR ONE (1) YEAR COVERING MATERIAL AND WORKMANSHIP. RECTIFY ANY DEFECTS PROMPTLY.

REFER TO DIVISION 15 DOCUMENTS AND PROVIDE ALL POWER WIRING AND DISCONNECT SWITCHES REQUIRED.

ENSURE RECEPTACLES ARE INSTALLED WHICH MATCH EQUIPMENT PLUG CON-FIGURATION. MAKE CHANGES TO SUIT AT NO EXTRA COST. TEST EACH RECEPTACLE FOR PROPER POLARITY AND GROUND.

SUPPORT ALL NEW CONDUIT INSTALLATION FROM STRUCTURE. SECURE ALL PRODUCTS IN APPROVED MANNER.


CIRCUIT NUMBERS INDICATED ON DRAWINGS ARE FOR LOAD GROUPING PURPOSES ONLY. BALANCE LOADS ON PANELS TO WITHIN 10% ACROSS PHASES.

PROVIDE ALL WIRING DEVICES AS SPECIFICATION GRADE UNLESS NOTED OTHERWISE.

ALL EQUIPMENT PROVIDED WITH LAMICOID PLATES WITH 7mm (1/4") HIGH ED LETTERS.

PROVIDE ALL WIRING AS COPPER T90 FOR OVERHEAD INSTALLATION AND RWJ90 FOR UNDER GROUND INSTALLATION. ALL WIRING SHALL BE DONE IN CONDUIT. UNLESS OTHERWISE NOTED, BX CABLE MAY BE USED IN PARTITION WALLS AND CEILING SPACE FOR RUNS NOT EXCEEDING 10 FT. HORIZONTALLY.

MINIMUM WIRE SIZE IS #12 AWG. INCREASE SIZE AS REQUIRED TO LIMIT BRANCH CIRCUIT VOLTAGE DROP TO 3% AND FEEDER VOLTAGE DROPS TO 2% AT FULL LOAD AS PER OESC AND OBC SB-10 REQUIREMENTS. USE SOLID CONDUCTORS FOR SIZES #10 AWG AND SMALLER AND STRANDED CONDUCTORS FOR SIZES # 8 AWG AND LARGER.

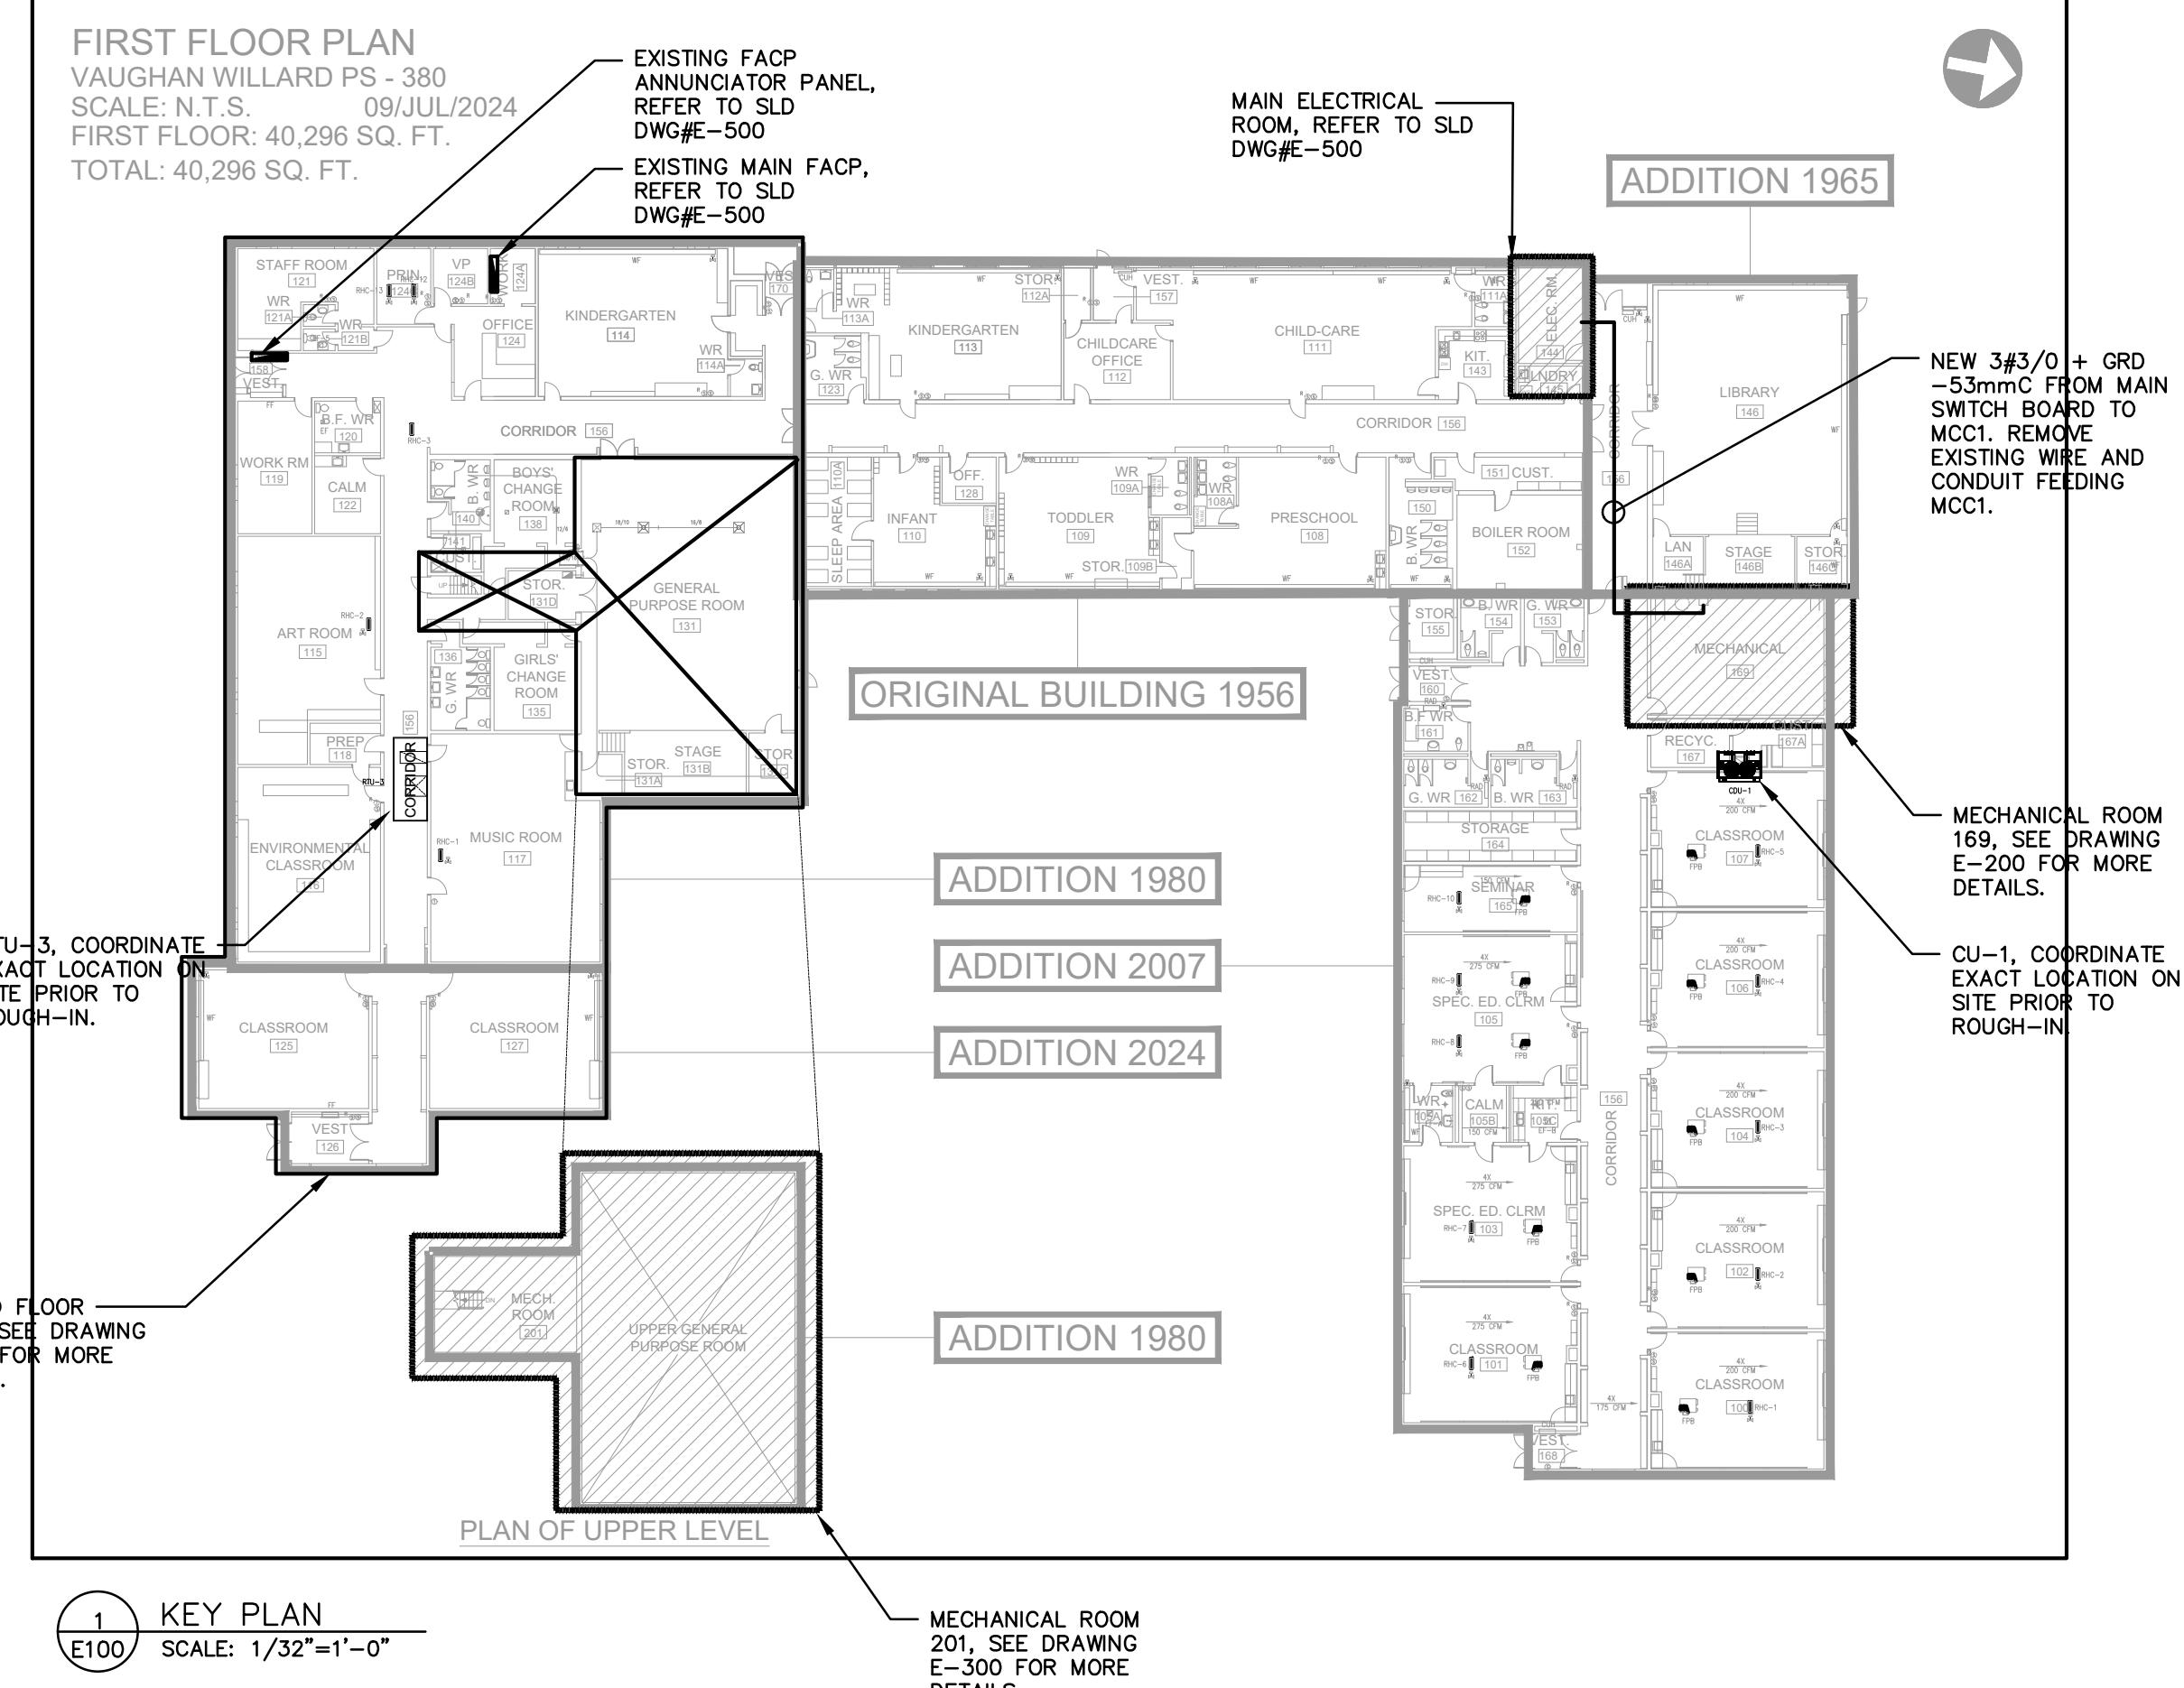

LEGEND OF SYMBOLS

- LIGHT FIXTURES AS DESCRIBED ON DRAWINGS.
- SELF-CONTAINED COMBINATION 'RUNNING MAN' PICTOGRAM LED EXIT LIGHT C/W EMERGENCY LED HEADS EMERGILITE 'ESC SERIES'. SEE FLOOR PLAN.
- SELF-CONTAINED CEILING OR WALL MOUNTED 'RUNNING MAN' PICTOGRAM LED SERIES EXIT LIGHT. SHADeD AREA DENOTES REQUIRED FACE. BEGHELLI 'VE2 COMBORM'.
- EMERGENCY BATTERY UNIT AS NOTED ON DRAWINGS C/W 7W LED LAMPHEADS, UNLESS NOTED OTHERWISE. BEGHELLI 'NOVA' SERIES C/W 1/2 HOUR WATTAGE CAPACITY AS NOTED ON DRAWINGS. CONTRACTOR MUST NOT EXCEED 5% VOLTAGE DROP.
- SINGLE OR DOUBLE REMOTE EMERGENCY LED LAMPHEADS WALL MOUNTED C/W 6W LED 12V DC LAMPS, UNLESS NOTED OTHERWISE BEGHELLI 'SR' SERIES.
- \$ 20A 120V SINGLE POLE LIGHT SWITCH, TOGGLE TYPE SPECIFICATION GRADE, WHITE IN COLOR. PROVIDE SINGLE GANG UTILITY BOX C/W GALVANIZED STEEL COVER PLATE.
- 20A 120V DUPLEX U-GROUND RECEPTACLE (5-20R) SPECIFICATION GRADE WHITE IN COLOR, C/W GALVANIZED STEEL COVERPLATE. MH 12" AFF UNLESS OTHERWISE NOTED.
- CONNECTION TO 120V MOTOR OR POWER OUTLET AS INDICATED ON DRAWINGS.
- MD 15A 120V CONNECTION TO MOTORIZED DAMPER
- CONNECTION TO 208V 1 PHASE MOTOR OR POWER OUTLET AS INDICATED ON DRAWINGS.
- CONNECTION TO 208V 3 PHASE MOTOR OR POWER OUTLET AS INDICATED ON DRAWINGS.
- DISCONNECT SWITCH SIZE AS INDICATED ON DRAWINGS OR TO SUIT.
- MOTOR STARTER, AS NOTED ON DRAWINGS SUPPLIED, INSTALLED AND WIRED BY THE ELECTRICAL CONTRACTOR.
- COMBINATION MOTOR STARTER SUPPLIED, INSTALLED AND WIRED BY THIS ELECTRICAL CONTRACTOR.
- EPO EMERGENCY POWER OFF PUSHBUTTON.
- JUNCTION BOX, CEILING OR WALL MOUNTED C/W CIRCUIT AS NOTED
- FIRE ALARM MANUAL PULL STATION.
- SURFACE WALL MOUNTED FIRE ALARM HORN
- COMBINATION FIRE ALARM HORN AND STROBE LIGHT.
- FIRE ALARM HEAT DETECTOR
- WP DENOTES WEATHER PROOF
- GFI DENOTES GROUND FAULT INTERRUPTER TYPE.
- ER DENOTES EXISTING TO BE RELOCATED. EXTEND WIRING, RECONNECT & MAKE GOOD.
- RL DENOTES RELOCATED POSITION
- EX DENOTES EXISTING TO REMAIN
- N DENOTES NEW TO MATCH EXISTING
- R DENOTES EXISTING TO BE REMOVED.

MAGNETIC COMBINATION STARTERS

INTEGRAL FUSED QUICK-MAKE QUICK-BREAK SWITCHING MECHANISM. (FUSED SIZE AS INDICATED)

INTEGRAL 120V SINGLE PHASE CONTROL TRANSFORMER WITH FUSED SECONDARY SIZE FOR THE CONTROL CIRCUIT REQUIREMENTS & 25% SPARE CAPACITY.

EEMAC 1 ENCLOSURE.

CONTACTOR SOLENOID OPERATED, RAPID ACTION TYPE, EEMAC STANDARD SIZES ONLY.

MOTOR OVERLOAD PROTECTIVE DEVICE IN EACH PHASE, MANUALLY RESET FROM OUTSIDE ENCLOSURE. OVERLOAD HEATERS SHALL MATCH NAMEPLATE CURRENT. OVERLOADS MUST NOT EXCEED 125% OF NAMEPLATE CURRENT. FULLY PROTECT THE MOTOR FOR ALL STARTING & LOCKED ROTOR CONDITIONS WITH THE ROTOR CONDITIONS WITH THE OVERLOADS REMAINING ACTIVE AT ALL TIMES.

POWER & CONTROL TERMINALS (SEPARATE TERMINALS FOR EACH REMOTE CONNECTION TO ALLOW FOR TESTING ISOLATION OF INTERLOCK OR DEVICE)

WIRING & SCHEMATIC DIAGRAM INSIDE STARTER ENCLOSURE IN VISIBLE LOCATION.

HAND-OFF AUTO & SPEED SELECTOR SWITCHES.

LOW VOLTAGE PILOT LIGHTS.

AUXILIARY CONTACTS. (NORMALLY OPEN & NORMALLY CLOSED)

AUXILIARY & TIME DELAY RELAYS.

MAGNETIC STARTERS

1. SIMILAR TO MAGNETIC COMBINATION STARTER NOTED ABOVE EXCEPT WITHOUT INTEGRAL FUSED SWITCH.

2. DO NOT SCALE DRAWINGS.

3. REPORT ALL DISCOVERIES OF ERRORS, OMISSIONS OR DISCREPANCIES TO THE ELECTRICAL CONTRACTOR. THIS DOCUMENT IS FOR ENGINEER'S USE ONLY.

4. USE ONLY LATEST REVISED DRAWINGS OR THOSE THAT ARE MARKED "ISSUED FOR CONSTRUCTION" AND SIGNED BY THE ENGINEER.

5. THIS DOCUMENT SHALL REMAIN THE PROPERTY OF MJA ENGINEERING LTD. THE CLIENT SHALL BE PERMITTED TO RETAIN COPIES FOR INFORMATION AND REFERENCE ONLY. THIS DOCUMENT CANNOT BE MODIFIED AND/OR REPRODUCED BY OTHERS WITHOUT WRITTEN CONSENT OF MJA ENGINEERING LTD.

MECHANICAL CONSULTANT:

RoMar
ENGINEERING

MECHANICAL BUILDING SERVICES

PROJECT/LOCATION

VAUGHAN WILLARD P.S. - AHU REPLACEMENT


1911 Dixie Rd N, Pickering, ON L1V 1V4

DRAWING NAME

ELECTRICAL LEGEND, SPECIFICATION AND DETAILS

| DRAWN M.A. | SCALE N.T.S. | DRAWING NO. |
|--------------|----------------|-------------|
| CHECKED M.A. | DATE DEC. 2025 | |
| PROJECT NO. | 2025-189 | |

| DRAWING LIST | | |
|--|--|--|
| E-100 - ELECTRICAL LEGEND, SPECIFICATION AND DETAILS | | |
| E-200 - MECH. ROOM 201 DEMO AND NEW WORK - POWER | | |
| E-300 - MECH. ROOM 169 DEMO AND NEW WORK - POWER | | |
| E-400 - GROUND FLOOR LAYOUT - POWER | | |
| E-500 - SLD AND PANEL LOAD SCHEDULES | | |

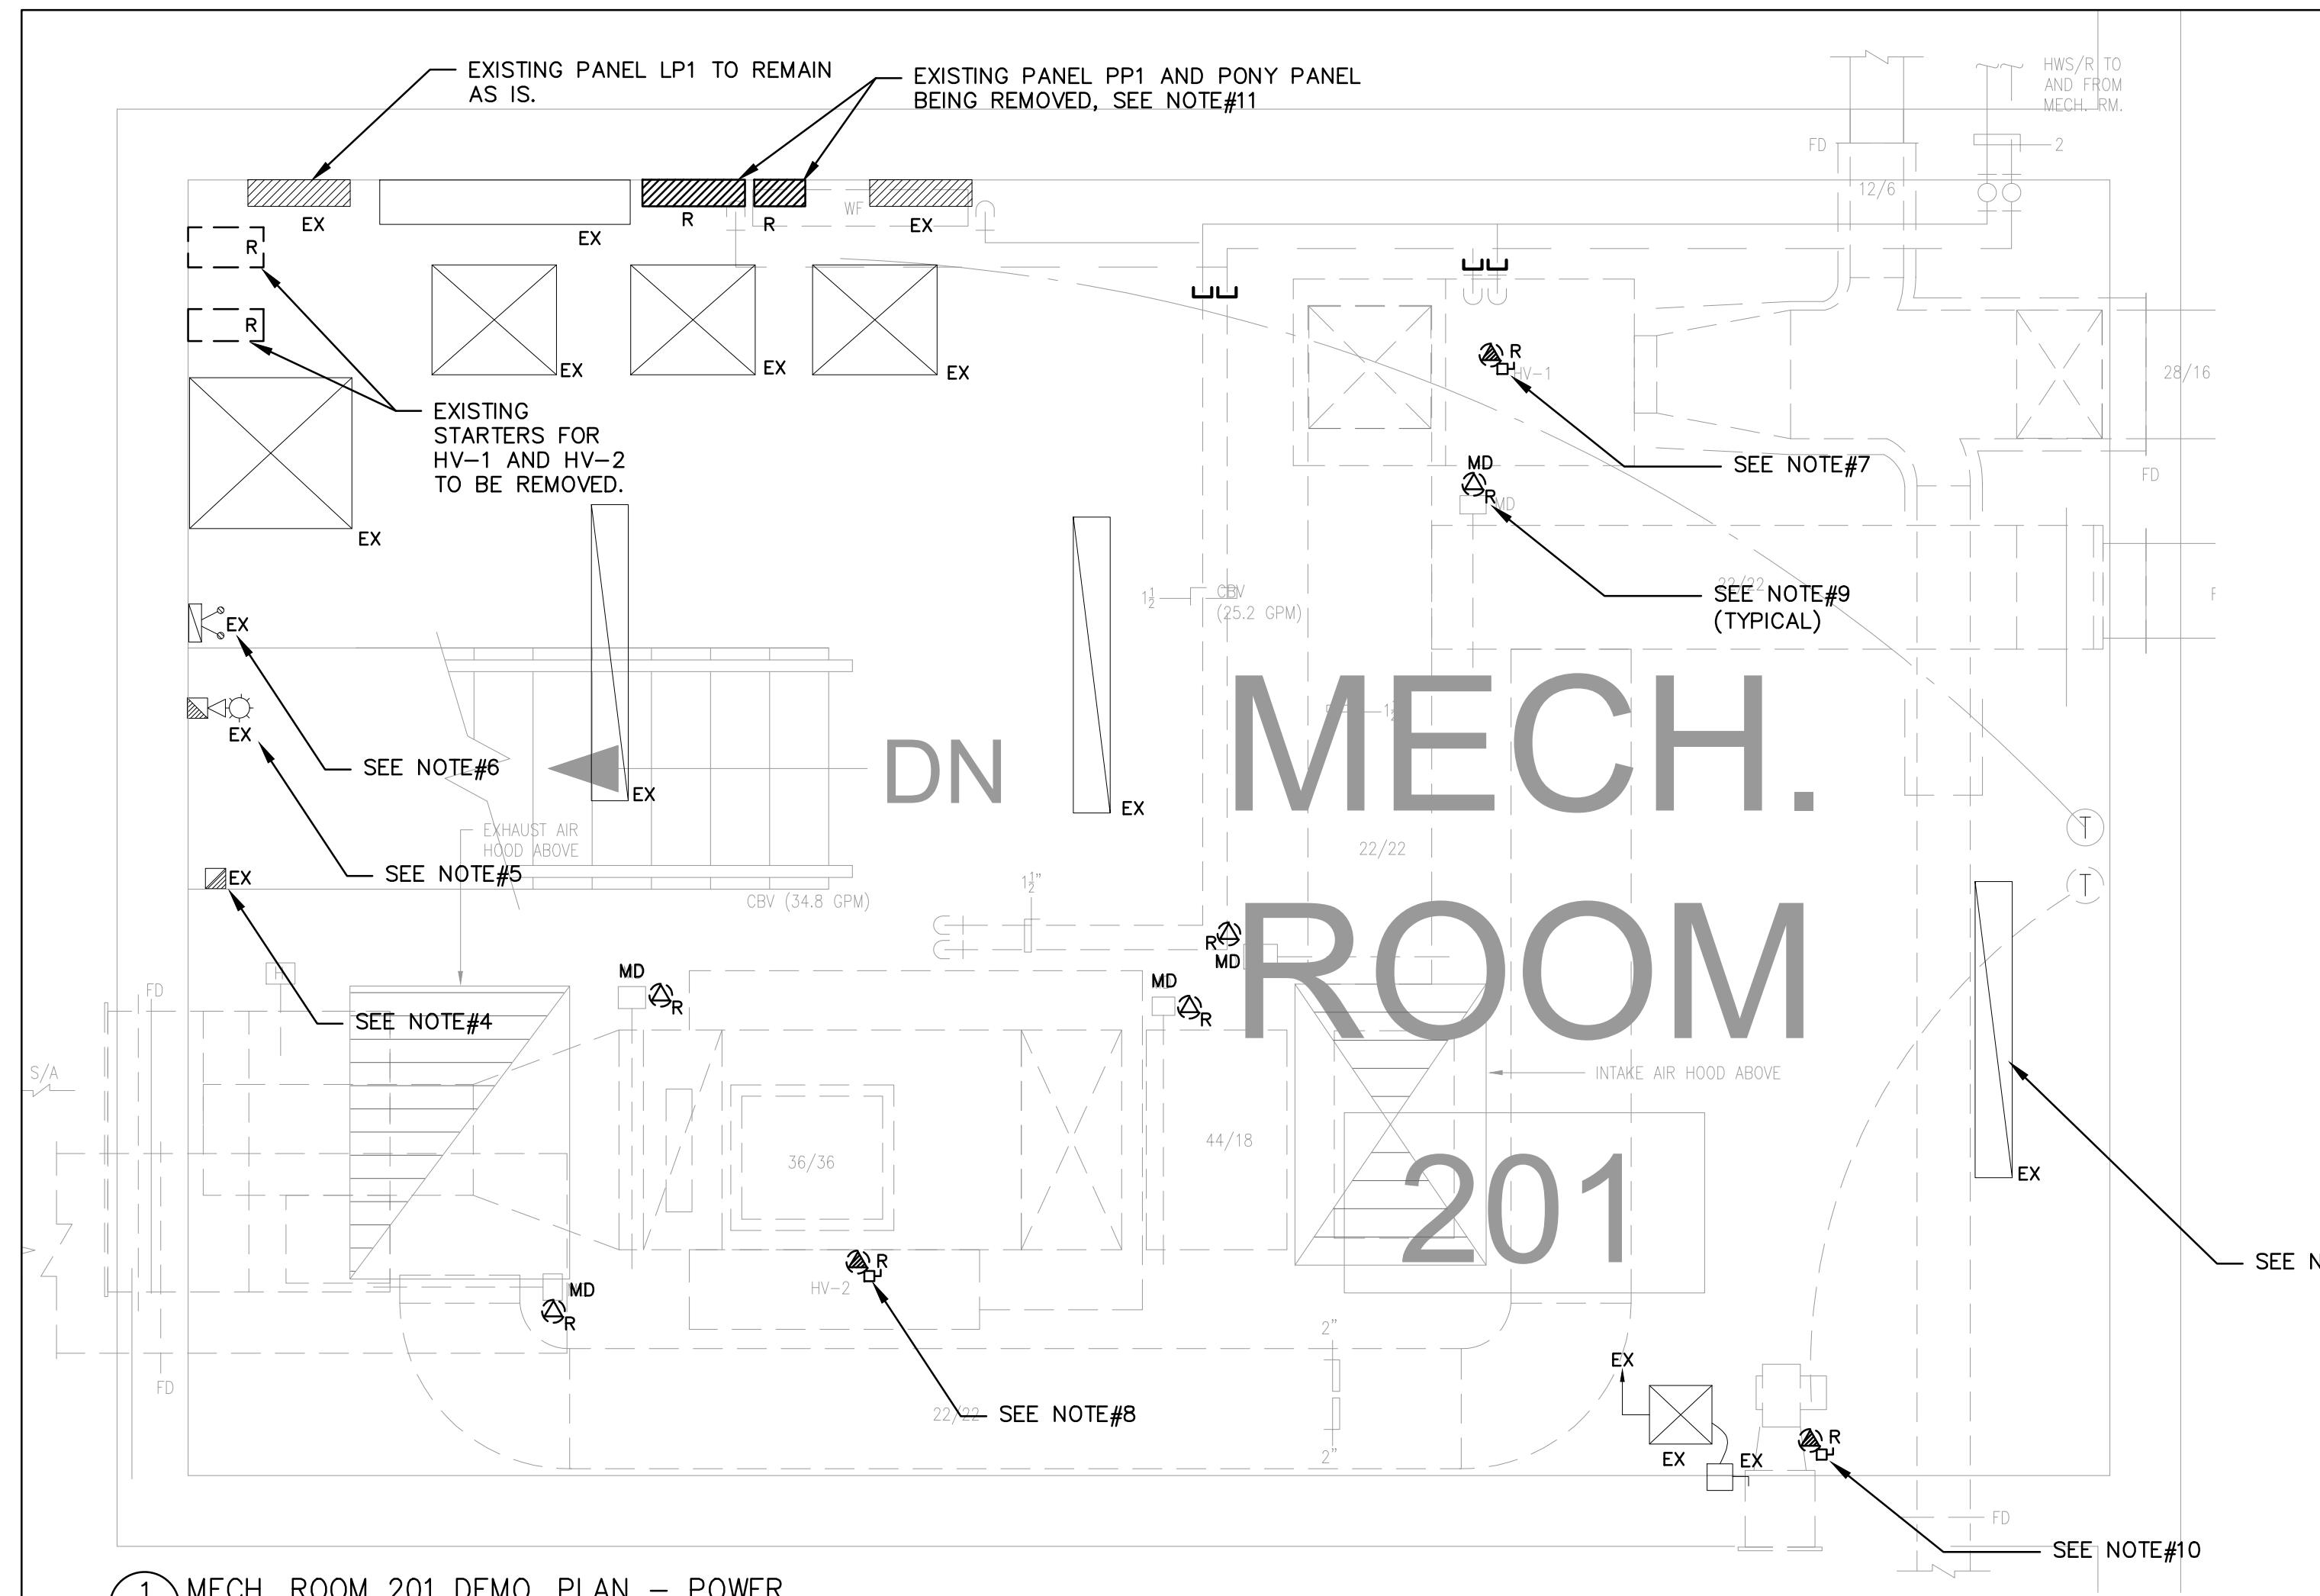

1 MECH. ROOM 201 DEMO. PLAN - POWER
E200 SCALE: 1/2" = 1'-0"

Architectural drawing showing a room layout with the following dimensions:

- Width: 12' 0" (144")
- Length: 12' 0" (144")
- Depth: 12' 0" (144")

The drawing includes a north arrow pointing upwards and a circled 'R' with 'MD' below it, likely indicating a rough opening for a door. The text "MECH ROOM" is prominently displayed at the top of the drawing.


A large, bold, grey number '20' is centered in the frame. The '2' is on the left and the '0' is on the right. The background features a light grey grid of intersecting lines forming a triangular frame around the numbers. The lines are thin and light grey, creating a clean, modern look.

— SFF NOTE #

DEMOLITION NOTE

DEMOLITION NOTES

1. UNLESS OTHERWISE NOTED ALL ELECTRICAL EQUIPMENT SHOWN SHALL BE REMOVED AND DISPOSED OF OFF SITE IN AN APPROVED MANNER.
2. ELECTRICAL CONTRACTOR SHALL ALSO REMOVE ALL ASSOCIATED CONDUIT AND FOR REMOVED EQUIPMENT UNLESS OTHERWISE NOTED.
3. EXISTING LIGHT TO REMAIN.
4. EXISTING MANUAL PULL STATION TO REMAIN.
5. EXISTING HORN/STROBE TO REMAIN.
6. EXISTING EMERGENCY BATTERY TO REMAIN.
7. EXISTING 600V CONNECTION TO HV-1 TO BE REMOVED TO FEEDING SOURCE (P
LP1) REMOVE ASSOCIATED CONDUIT AND WIRE TO FEEDING SOURCE.
8. EXISTING 600V CONNECTION TO HV-2 TO BE REMOVED TO FEEDING SOURCE (P
LP1) REMOVE ASSOCIATED CONDUIT AND WIRE TO FEEDING SOURCE.
9. 15A, 120V CONNECTION TO MOTORIZED DAMPER BEING REMOVED.
10. EXISTING CONNECTION TO FLOOR MOUNTED EXHAUST FAN TO BE REMOVED, REMOVE ASSOCIATED CONDUIT AND WIRE TO FEEDING SOURCE.
11. EXISTING PANEL PP1 AND PONY PANEL BEING REMOVED TO ALLOW FOR NEW PANEL PP1A INSTALLATION. ADD EXISTING CIRCUITS TO NEW PANEL AND ADJUST ACCORDINGLY.

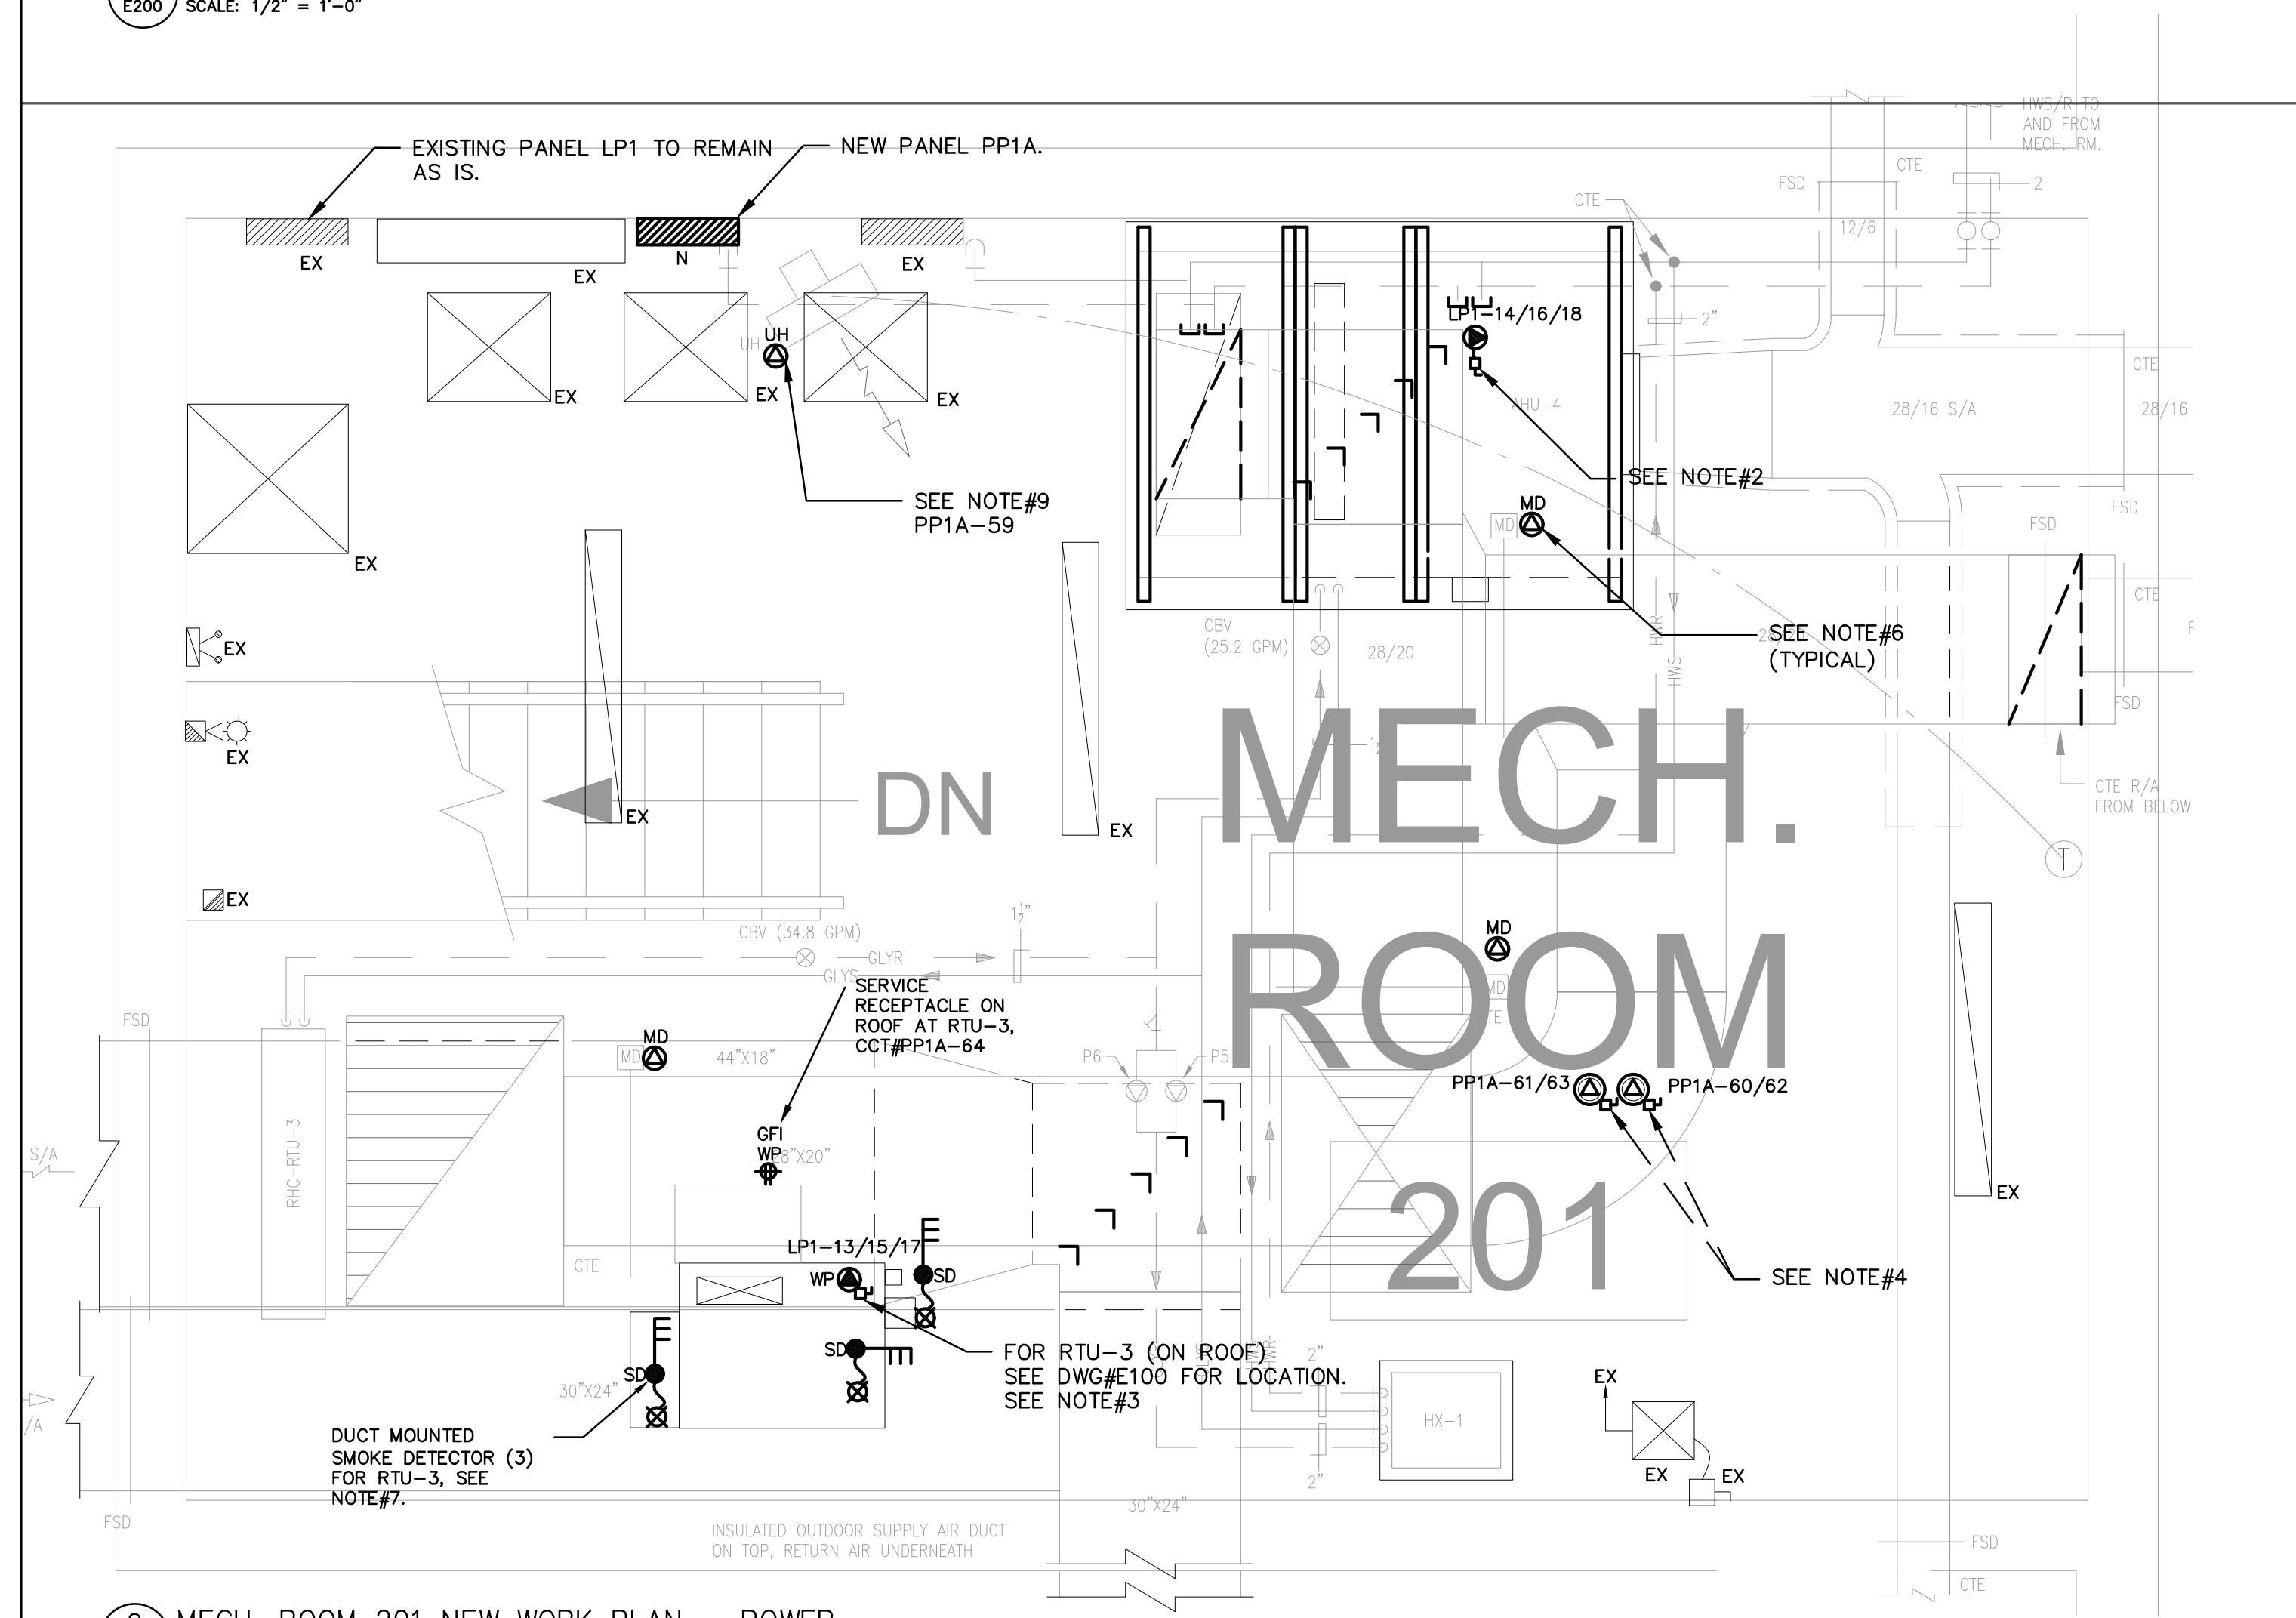

2 MECH. ROOM 201 NEW WORK PLAN - POWER
E200 SCALE: 1/2" = 1'-0"

This image is an architectural floor plan showing a room labeled 'MECH ROOM'. The room is defined by a rectangular boundary. Inside the room, there is a circular area with the text 'MD' and a circled 'A' symbol. To the left of the room, there is a smaller area with the text 'P5' and a circled 'A' symbol. The room is adjacent to a larger area labeled 'PP1A-61/63' and 'PP1A-60/6'. The overall style is technical and precise, typical of a professional architectural or engineering drawing.

20

NEW WORK NOT

1. UNLESS OTHERWISE INDICATED/ OR NOTED ALL EQUIPMENT SHOWN IS NEW TO BE PROVIDED BY THIS ELECTRICAL CONTRACTOR.
2. 15A, 600V 3Ø CONNECTION TO FEED AHU-4, RUN WIRES AND CONDUIT FROM PANEL TO AHU-4 DISCONNECT SWITCH.
3. 60A, 600V 3Ø CONNECTION TO FEED RTU-3 ON THE ROOF, RUN WIRES AND CONDUIT FROM PANEL LP1 TO RTU-3 WEATHER PROOF DISCONNECT SWITCH.
4. 10A, 208V 1Ø CONNECTIONS TO PUMPS P1&P2 FED FROM PANEL PP1A.
5. CIRCUIT SHOWN ARE FOR GROUPING PURPOSES ONLY, PLEASE VISIT THE SITE PRIOR TENDER AND ADD FOR ANY ADDITIONAL REQUIREMENTS AND ACCESSORIES TO COMPLETE THE WORK.
6. NEW 15A, 120V CONNECTION TO MOTORIZED DAMPER. RE-USE EXISTING CIRCUITS MAKE SPARE BY THIS RENOVATION.
7. PROVIDE SEPARATE ZONE FOR DUCT MOUNTED SMOKE DETECTORS, CO-ORDINATE INSTALLATION WITH MECHANICAL CONTRACTOR.
8. 15A, 120V CONNECTION TO NEW UNIT HEATER.

ELECTRICAL CONSULTANT:

MJA ENGINEERING LTD.
ELECTRICAL ENGINEERS

556 EDWARD AVENUE, UNIT 82
RICHMOND HILL, ONTARIO
L4C 9Y5, CANADA

PHONE: (905) 780-8590 FAX: (905) 780-8591

EMAIL: engineering@mjaeng.com

WEB SITE: www.mjaeng.com

© COPYRIGHT NOTES


DISCLAIMER :

1. VERIFY ALL DIMENSIONS PRIOR TO CONSTRUCTION.
2. DO NOT SCALE DRAWINGS.
3. REPORT ALL DISCOVERIES OF ERRORS, OMISSIONS OR DISCREPANCIES TO THE ARCHITECT OR DESIGN ENGINEER AS APPLICABLE.
4. USE ONLY LATEST REVISED DRAWINGS OR THOSE THAT ARE MARKED "ISSUED FOR CONSTRUCTION" AND SIGNED BY THE ENGINEER.
5. THIS DOCUMENT SHALL REMAIN THE PROPERTY OF MJA ENGINEERING LTD. THE CLIENT SHALL BE PERMITTED TO RETAIN COPIES FOR INFORMATION AND REFERENCE ONLY. THIS DOCUMENT CANNOT BE MODIFIED AND/OR REPRODUCED BY OTHERS WITHOUT WRITTEN CONSENT OF MJA ENGINEERING LTD.

MECHANICAL CONSULTANT:

RoMar
ENGINEERING
MECHANICAL BUILDING SERVICES

The logo features a stylized graphic on the left consisting of three arrows pointing in different directions: a red arrow pointing up, a black arrow pointing left, and a black arrow pointing down. To the right of the graphic, the word "RoMar" is written in large, bold, black letters. Below "RoMar", the word "ENGINEERING" is written in large, bold, red letters. At the bottom, the text "MECHANICAL BUILDING SERVICES" is written in a smaller, black, sans-serif font.

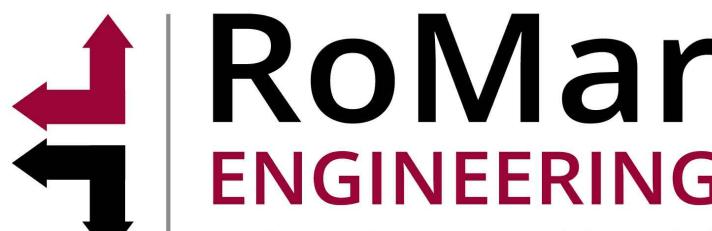


PROJECT/LOCATION

VAUGHAN WILLARD P.S - AHU REPLACEMENT

1911 Dixie Rd N, Pickering, ON L1V 1V4

MECH. ROOM 201 DEMO AND NEW WORK – POWER


| | | |
|-------------------------|-------------------|-------------|
| DRAWN M.A | SCALE AS SHOWN | DRAWING NO. |
| CHECKED M.A | DATE DEC. 2025 | |
| PROJECT NO. 2025-189 | | E-200 |

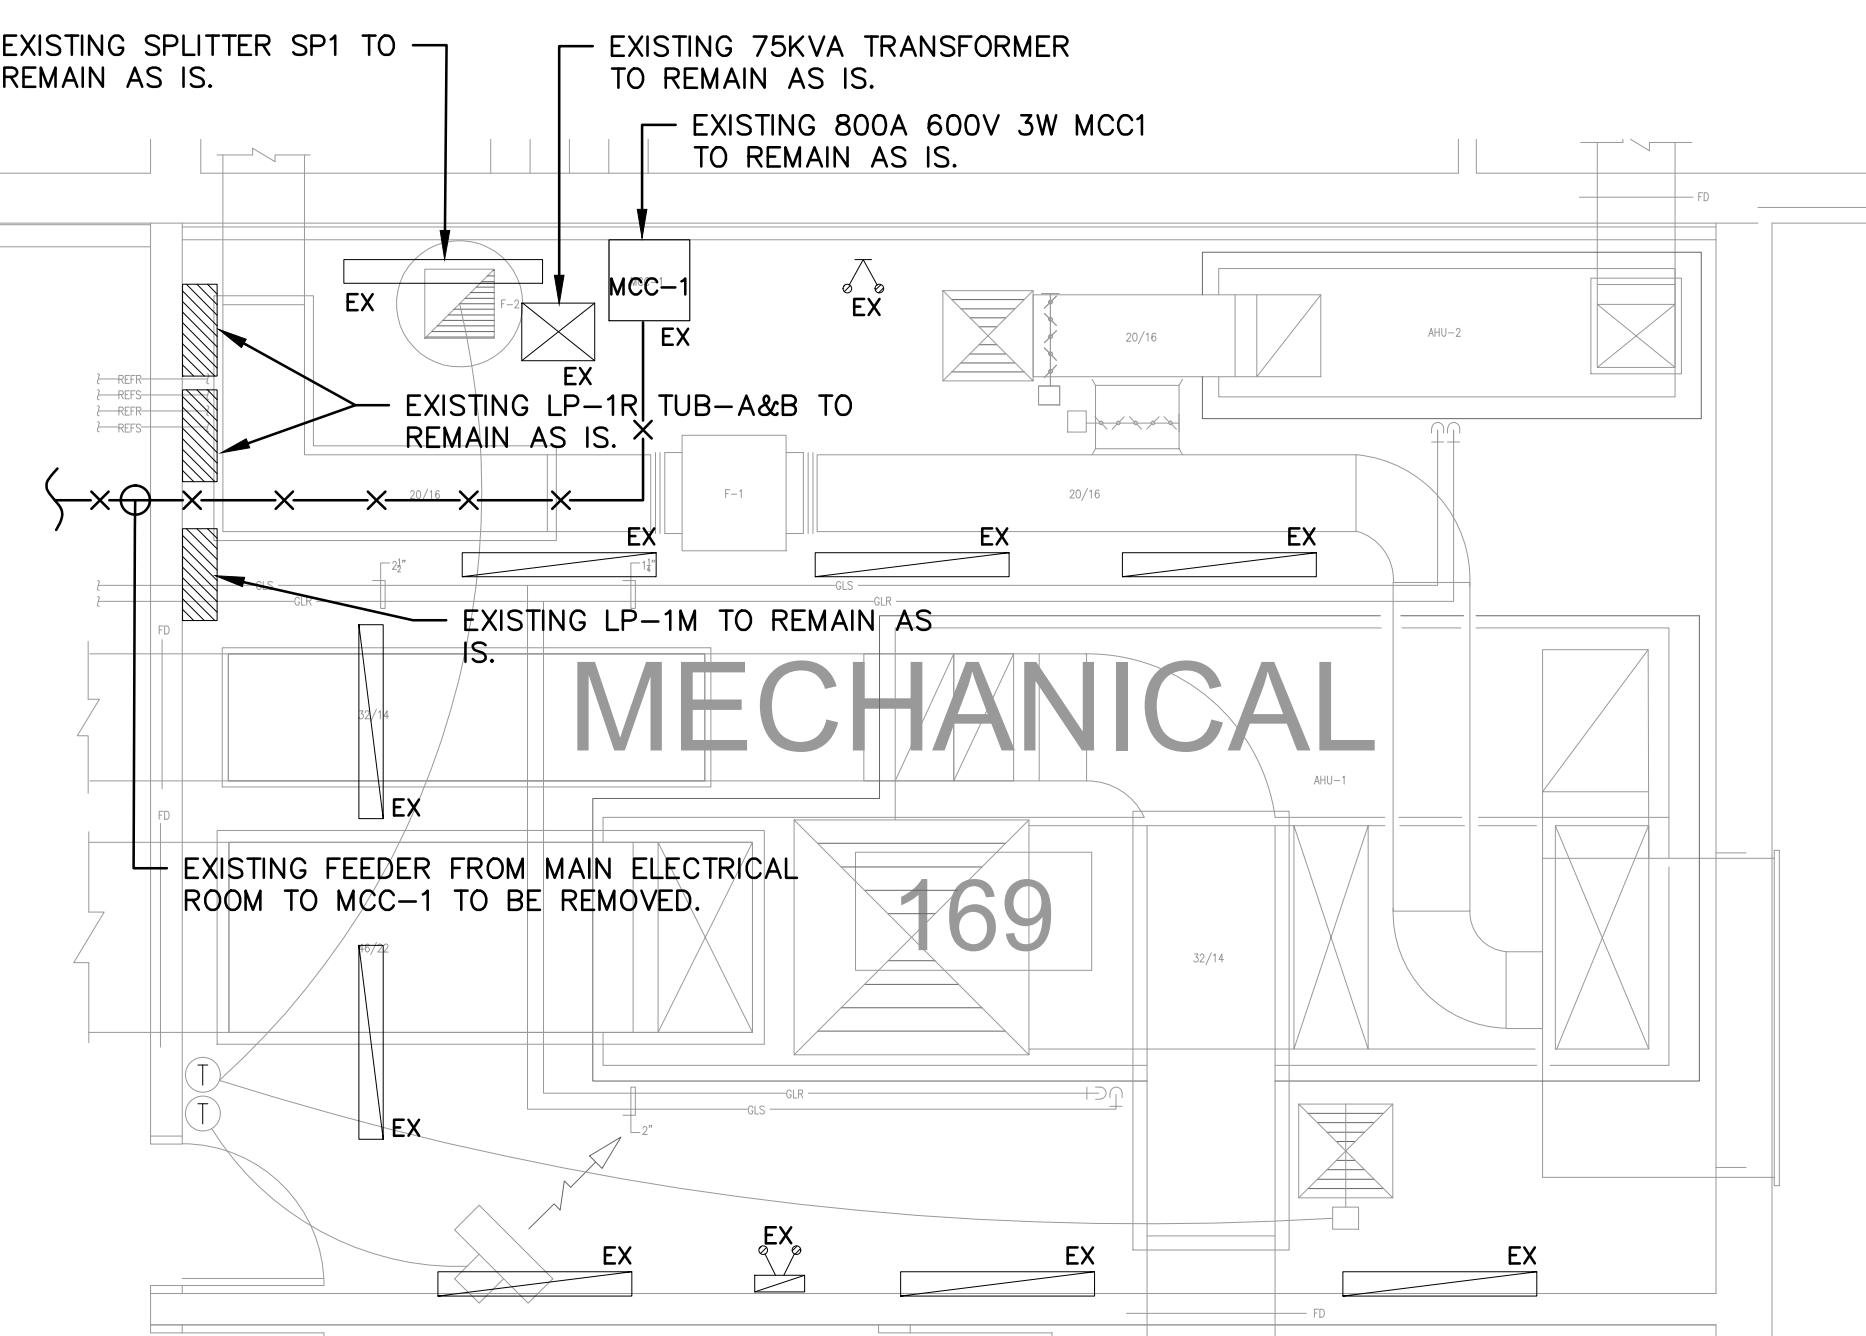

1 MECH. ROOM 169 DEMO - POWER
E300 SCALE: 1/4" = 1'-0"

DEMOLITION NOTES

1. UNLESS OTHERWISE NOTED ALL ELECTRICAL EQUIPMENT SHOWN SHALL BE REMOVED AND DISPOSED OF OFF SITE IN AN APPROVED MANNER.
2. ELECTRICAL CONTRACTOR SHALL ALSO REMOVE ALL ASSOCIATED CONDUIT AND WIRE FOR REMOVED EQUIPMENT UNLESS OTHERWISE NOTED.
3. EXISTING LIGHT TO REMAIN.
4. EXISTING MANUAL PULL STATION TO REMAIN.
5. EXISTING HORN/STROBE TO REMAIN.
6. EXISTING EMERGENCY BATTERY TO REMAIN.
7. EXISTING 600V CONNECTION TO HV-1 TO BE REMOVED TO FEEDING SOURCE (PANEL LP1) REMOVE ASSOCIATED CONDUIT AND WIRE TO FEEDING SOURCE.
8. EXISTING 600V CONNECTION TO HV-2 TO BE REMOVED TO FEEDING SOURCE (PANEL LP1) REMOVE ASSOCIATED CONDUIT AND WIRE TO FEEDING SOURCE.

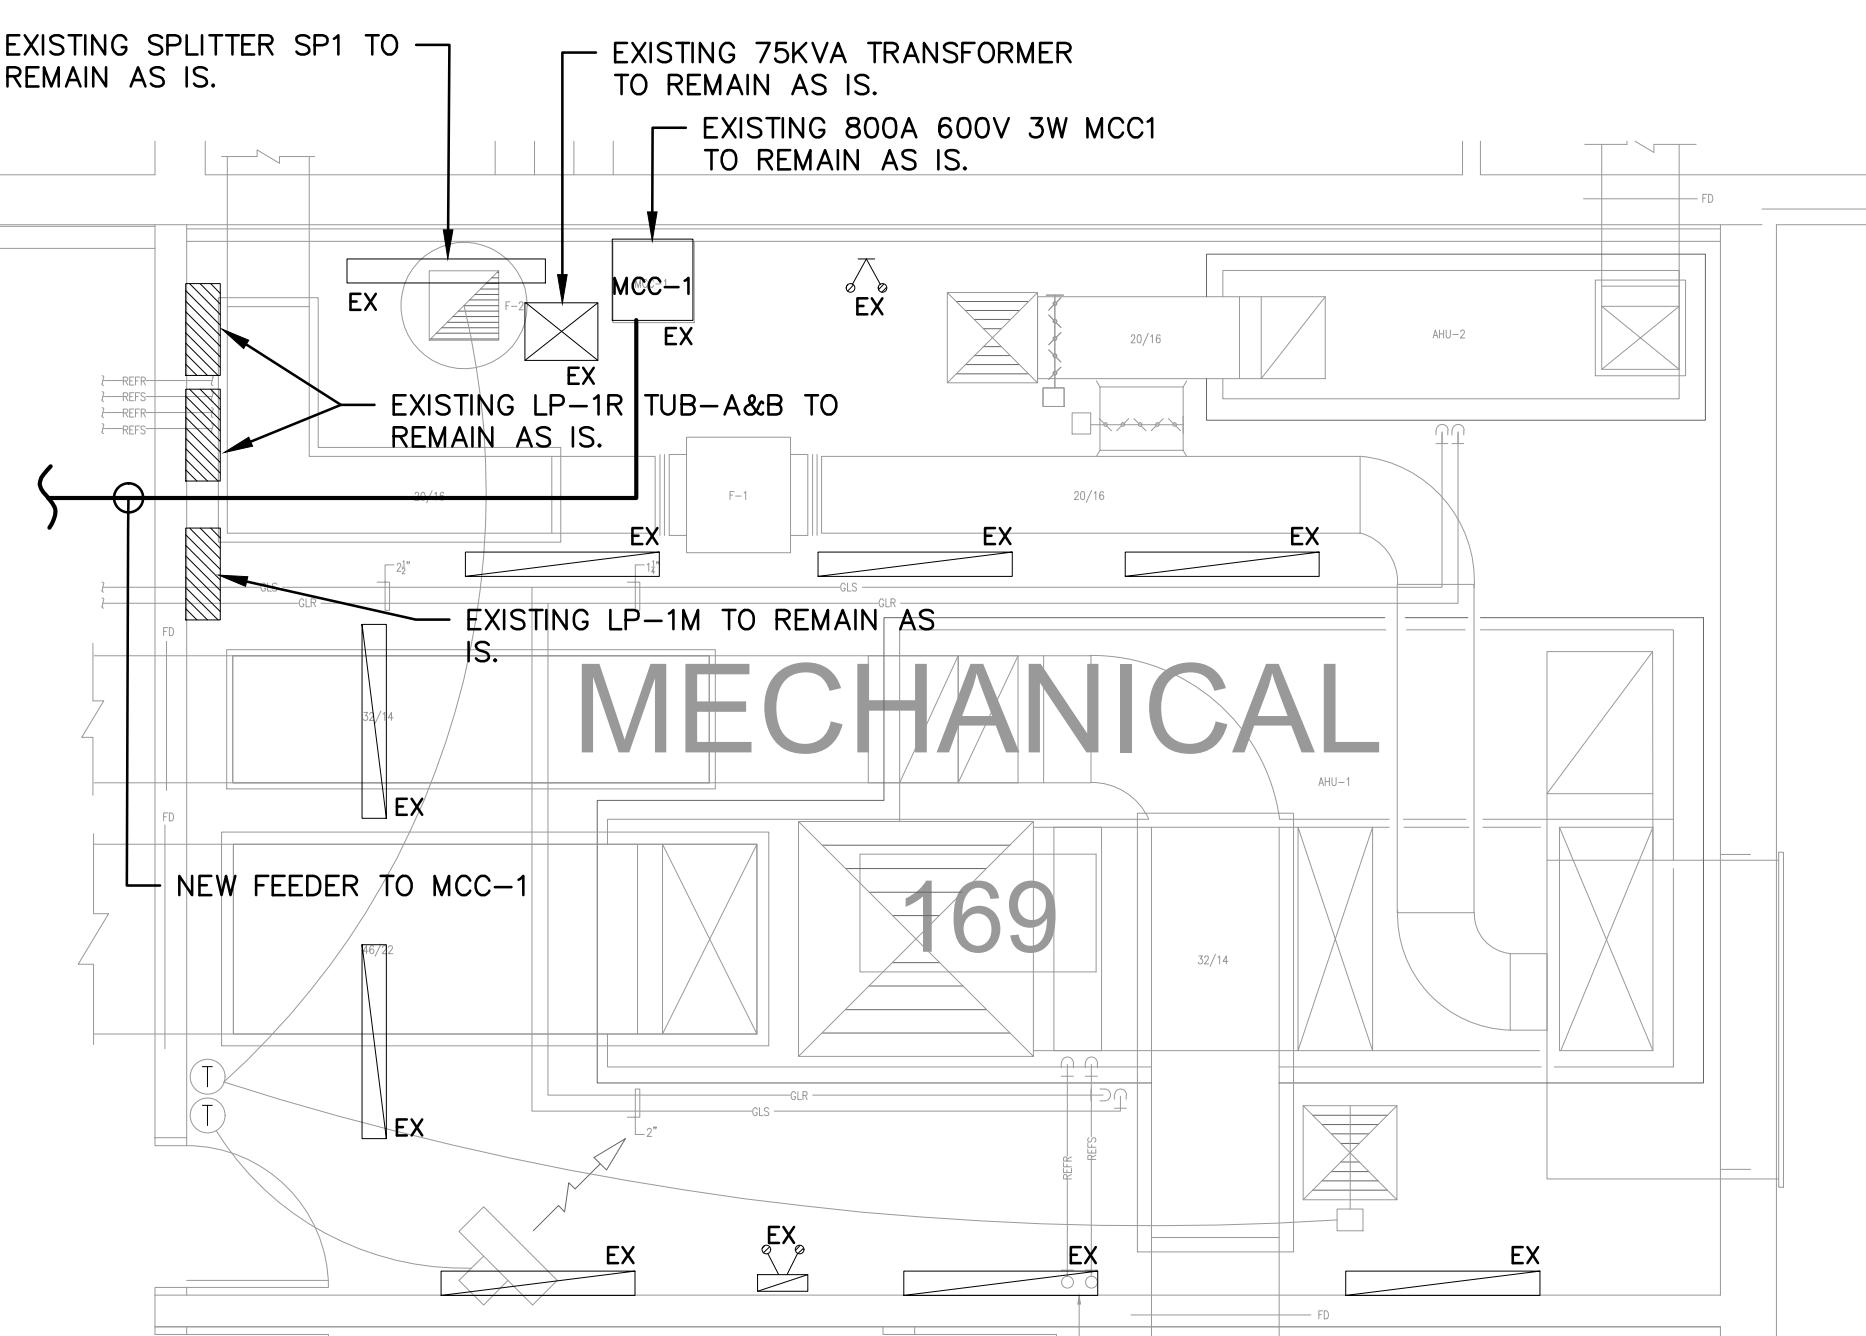

2 MECH. ROOM 169 NEW WORK PLAN - POWER

E300 SCALE: $1/4"$ = $1'-0"$

NEW WORK NOTES

1. UNLESS OTHERWISE INDICATED/ OR NOTED ALL EQUIPMENT SHOWN IS NEW TO BE PROVIDED BY THIS ELECTRICAL CONTRACTOR.
2. 45A, 600V 3Ø CONNECTION TO CONDENSING UNIT -1, COORDINATE EXACT TERMINATION POINT ON SITE AND ADJUST ACCORDINGLY. SEE DWG#E500 FOR MORE DETAILS.


1
P
WP

SERVICE
RECEPTACLE ON
ROOF AT RTU-3,
CCT#LP1M-46

FOR CU-1 (ON ROOF) FED FROM M
SEE DWG#E100 FOR LOCATION, SEE
NOTE#2



ELECTRICAL CONSULTANT:

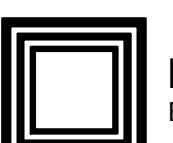

MJA ENGINEERING LTD.

ELECTRICAL ENGINEERS


556 EDWARD AVENUE, UNIT 82
RICHMOND HILL, ONTARIO
L4C 9Y5, CANADA
PHONE: (905) 780-8590 FAX: (905) 780-8591
EMAIL: engineering@mjaeng.com
WEB SITE: www.mjaeng.com

© COPYRIGHT NOTES:

DISCLAIMER :

1. VERIFY ALL DIMENSIONS PRIOR TO CONSTRUCTION.
2. DO NOT SCALE DRAWINGS.
3. REPORT ALL DISCOVERIES OF ERRORS, OMISSIONS OR DISCREPANCIES TO THE ARCHITECT OR DESIGN ENGINEER AS APPLICABLE.
4. USE ONLY LATEST REVISED DRAWINGS OR THOSE THAT ARE MARKED "ISSUED FOR CONSTRUCTION" AND SIGNED BY THE ENGINEER.
5. THIS DOCUMENT SHALL REMAIN THE PROPERTY OF MJA ENGINEERING LTD. THE CLIENT SHALL BE PERMITTED TO RETAIN COPIES FOR INFORMATION AND REFERENCE ONLY. THIS DOCUMENT CANNOT BE MODIFIED AND/OR REPRODUCED BY OTHERS WITHOUT WRITTEN CONSENT OF MJA ENGINEERING LTD.

MECHANICAL CONSULTANT:

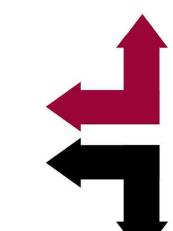

RoMar ENGINEERING


PROJECT / LOCATION

VAUGHAN WILLARD P.S. - AHU REPLACEMENT


1911 Dixie Rd N, Pickering, ON L1V 1V4

DRAWING NAME
MEC. ROOM 169 - DEMO AND NEW

| | | |
|----------------|-------------------|-------------|
| DRAWN M.A | SCALE AS SHOWN | DRAWING NO. |
| CHECKED M.A | DATE DEC. 2025 | |
| PROJECT NO. | 2025-189 | E-300 |

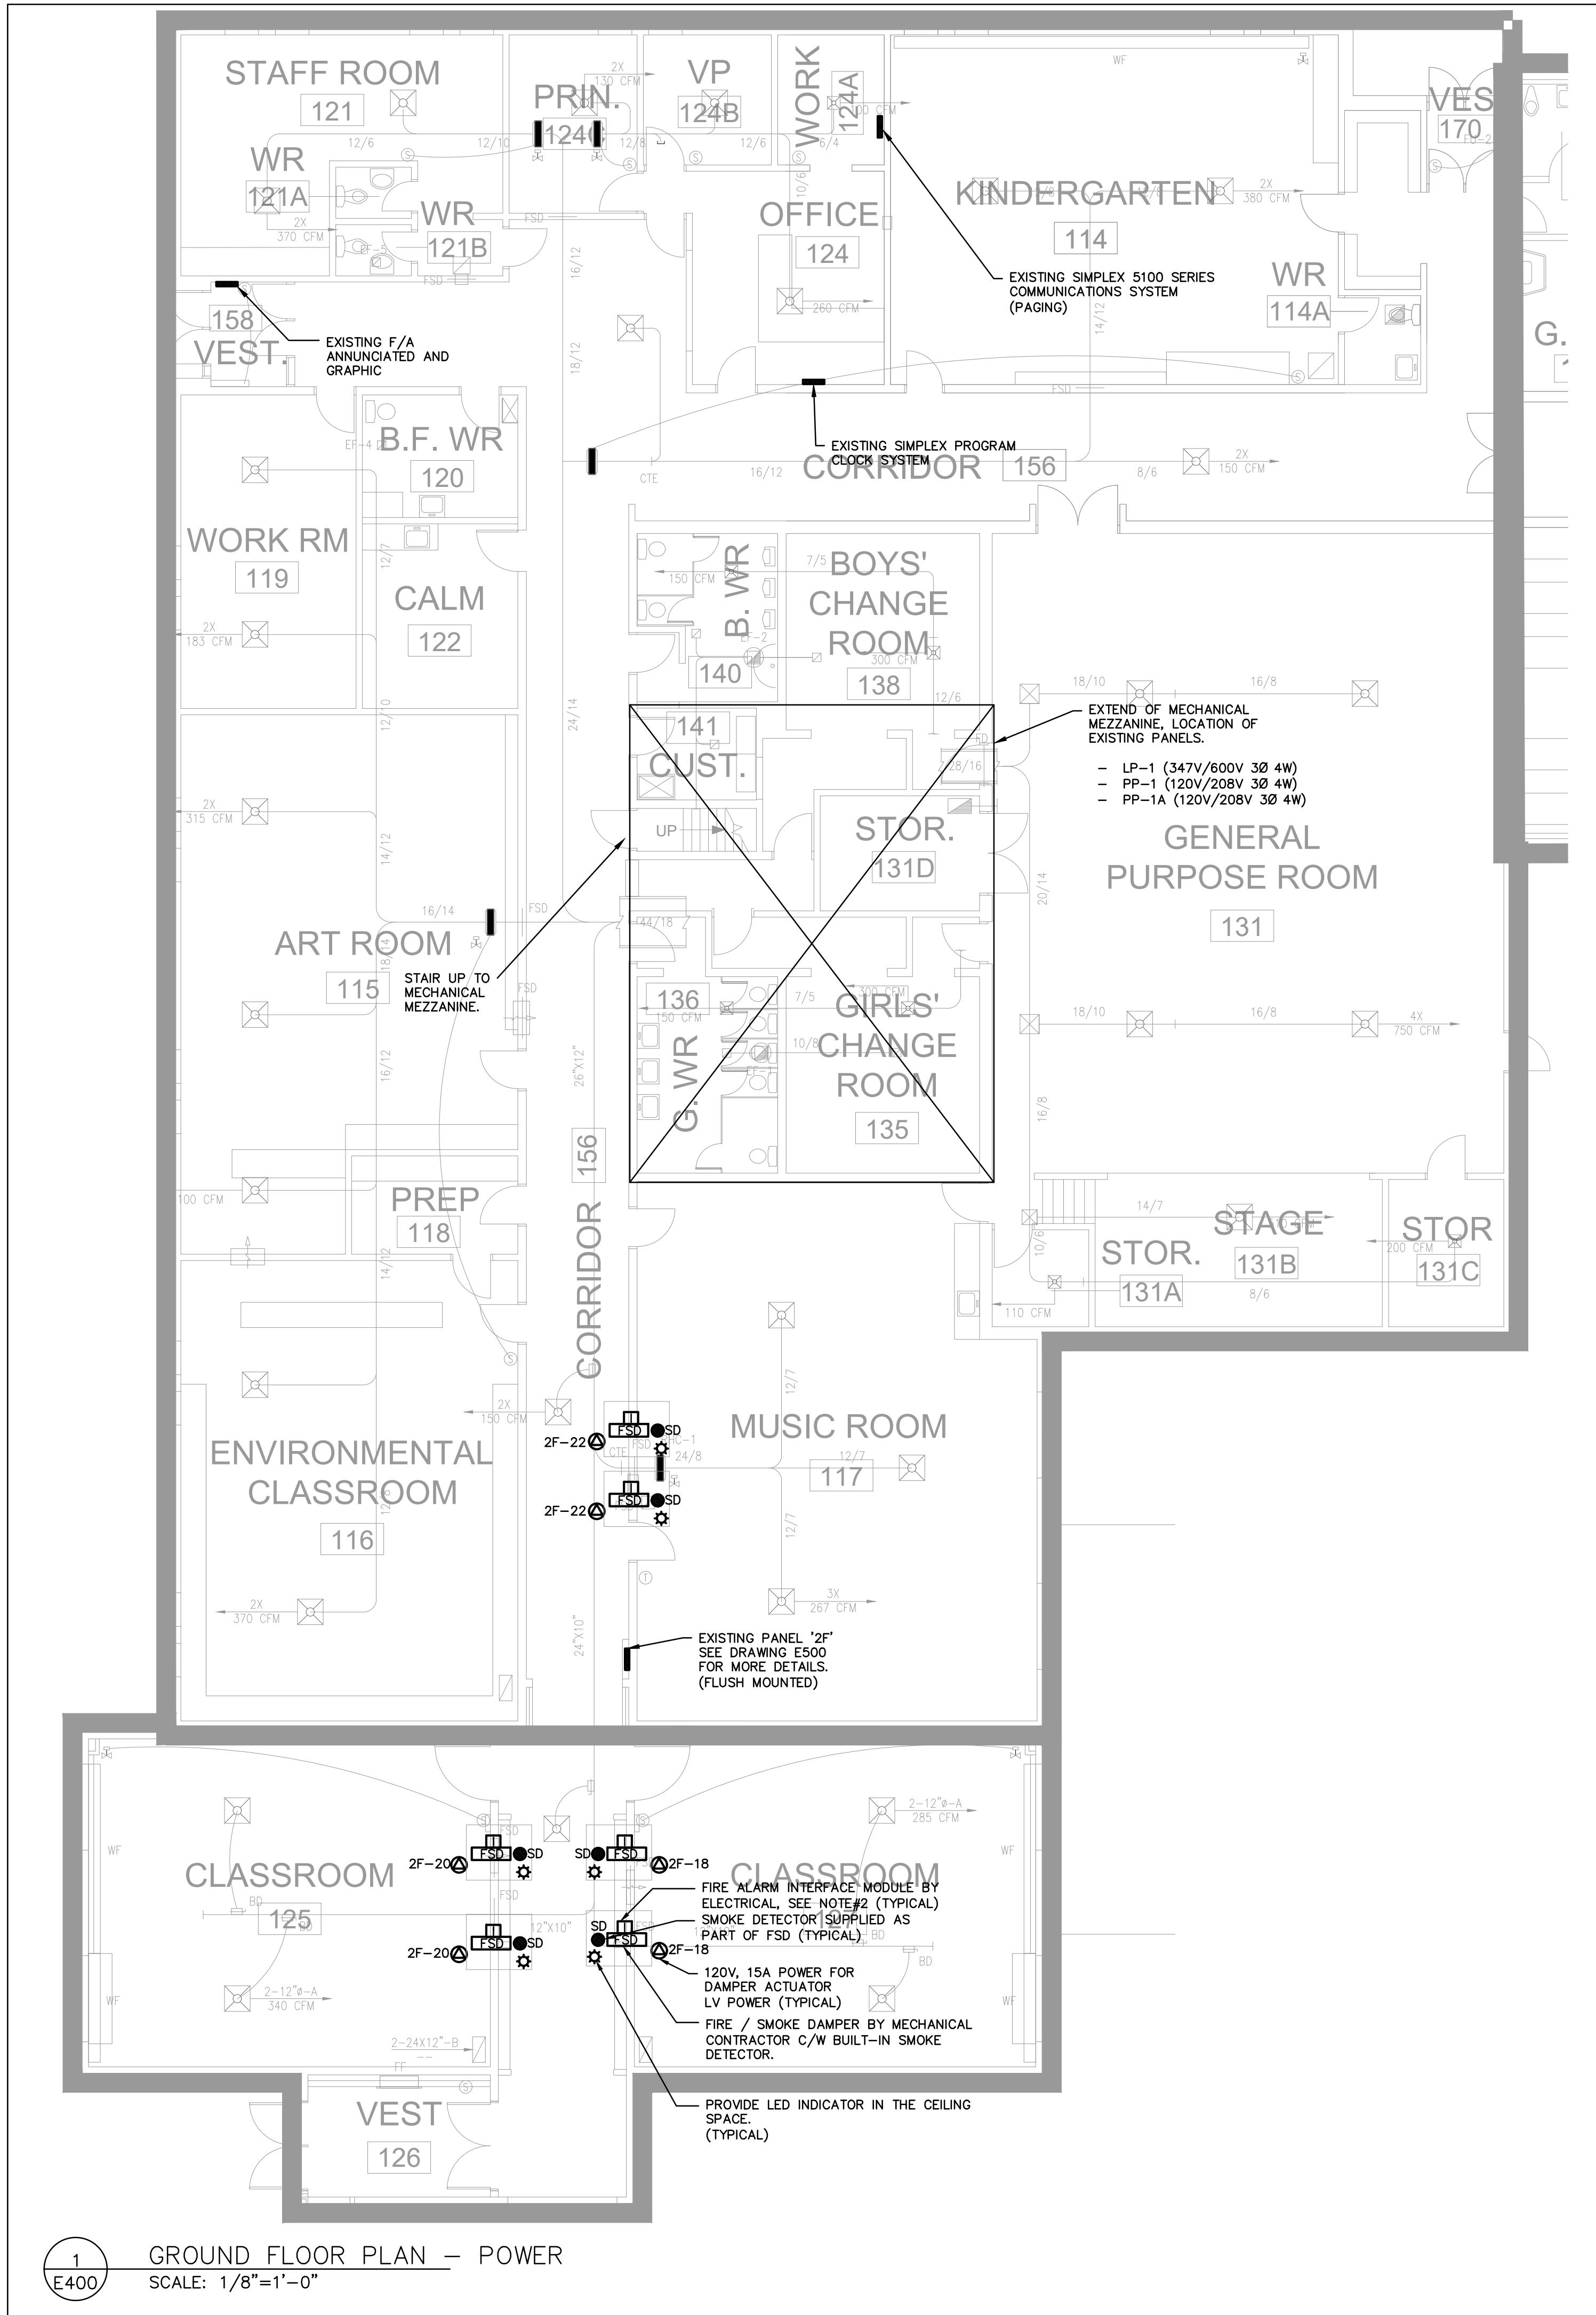

| NO. | DATE | REVISION | BY |
|-----|-----------|-------------------|----|
| 1 | DEC 24/25 | ISSUED FOR TENDER | MA |

 

ELECTRICAL CONSULTANT:
MJA ENGINEERING LTD.
 ELECTRICAL ENGINEERS

556 EDWARD AVENUE, UNIT B2
 RICHMOND HILL, ONTARIO
 L4B 3T5, CANADA
 PHONE: (905) 780-8590 FAX: (905) 780-8591
 EMAIL: engineering@mjaeng.com
 WEB SITE: www.mjaeng.com

© COPYRIGHT NOTES:


DISCLAIMER :
 1. VERIFY ALL DIMENSIONS PRIOR TO CONSTRUCTION.
 2. DO NOT SCALE DRAWINGS.
 3. REPORT ALL DISCOVERIES OF ERRORS, OMISSIONS OR DISCREPANCIES TO THE CONTRACTOR OR ENGINEER AS APPLICABLE.
 4. USE ONLY LATEST REVISED DRAWINGS OR THOSE THAT ARE MARKED "ISSUED FOR CONSTRUCTION" AND SIGNED BY THE ENGINEER.
 5. THIS DOCUMENT SHALL REMAIN THE PROPERTY OF MJA ENGINEERING LTD. THE CLIENT SHALL BE PERMITTED TO RETAIN COPIES FOR INFORMATION AND REFERENCE ONLY. THIS DOCUMENT CANNOT BE MODIFIED AND/OR REPRODUCED BY OTHERS WITHOUT WRITTEN CONSENT OF MJA ENGINEERING LTD.

MECHANICAL CONSULTANT:
RoMar ENGINEERING
 MECHANICAL BUILDING SERVICES

PROJECT/LOCATION
VAUGHAN WILLARD P.S. - AHU REPLACEMENT
 1911 Dixie Rd N, Pickering, ON L1V 1V4

DRAWING NAME
GROUND FLOOR LAYOUT - POWER.

| DRAWN M.A. | SCALE AS SHOWN | DRAWING NO. |
|----------------------|-------------------|-------------|
| CHECKED M.A. | DATE DEC. 2025 | |
| PROJECT NO. E-400 | 2025-189 | |

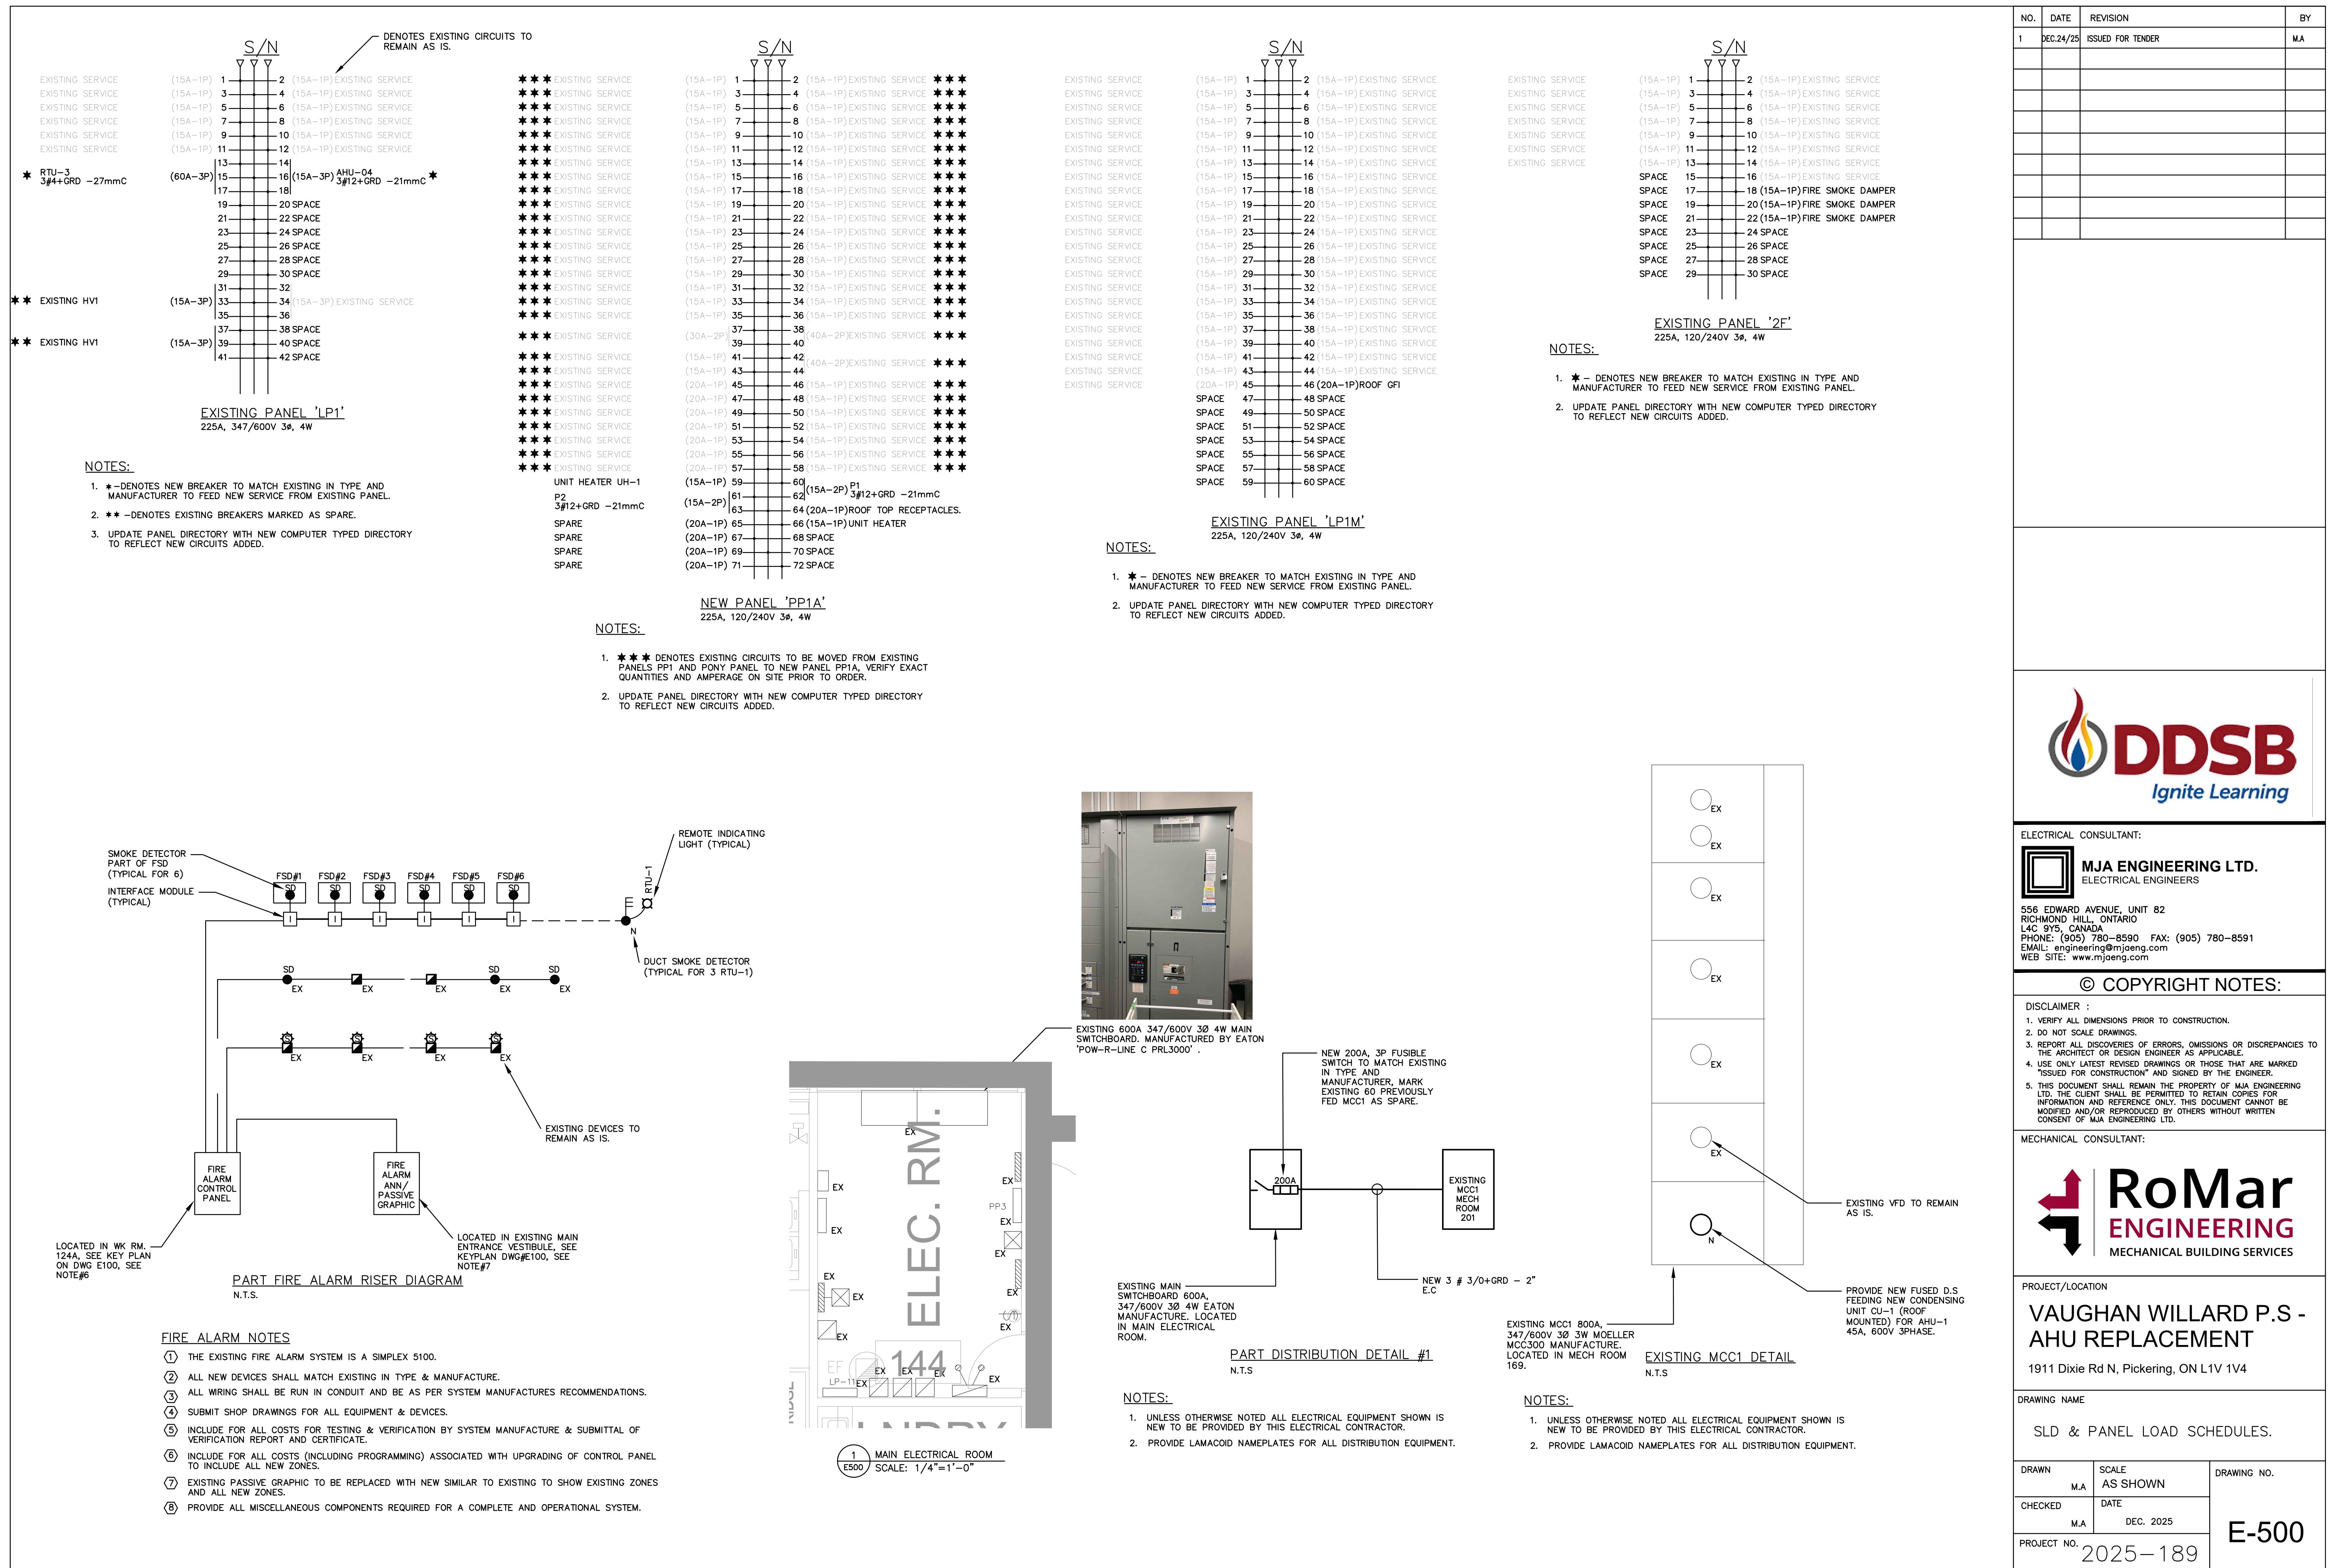

GENERAL NOTES

A. GENERAL INFORMATION

- READ STRUCTURAL DOCUMENTS IN CONJUNCTION WITH CONTRACT DOCUMENTS, WHICH INCLUDE, BUT ARE NOT LIMITED TO, ARCHITECTURAL, MECHANICAL, AND ELECTRICAL DOCUMENTS.
- CONTRACTOR TO BE RESPONSIBLE FOR CHECKING SITE CONDITIONS AGAINST DOCUMENTS BEFORE PROCEEDING WITH THE WORK, AND REPORT DISCREPANCIES TO THE CONSULTANT.
- CONTRACTOR TO PROVIDE LABOUR, MATERIALS, AND EQUIPMENT TO COMPLETE ALL STRUCTURAL WORK INDICATED.
- CARRY OUT CONSTRUCTION OPERATIONS, INCLUDING THE INSTALLATION OF TEMPORARY GUYING AND SHORING REQUIRED, ENSURING THAT THE EXISTING STRUCTURE OR MEMBERS ALREADY ERECTED ARE NOT LOADED IN EXCESS OF THEIR SAFE LOAD CARRYING CAPACITY.
- STRUCTURAL DOCUMENTS DO NOT NECESSARILY SHOW ALL OPENINGS AND SLAB VARIATIONS REQUIRED. THE CONTRACTOR SHALL REFER TO ARCHITECTURAL, MECHANICAL, AND ELECTRICAL DRAWINGS FOR THE EXACT LOCATION, NUMBER, AND SIZE OF OPENINGS, TRENCHES, PITS, SUMPS, SLEEVES, AND DEPRESSIONS. PROVIDE STRUCTURAL FRAMING AT THESE LOCATIONS IN ACCORDANCE WITH THE APPLICABLE TYPICAL DETAIL.

B. REFERENCE STANDARDS / CODES AND ACTS

- THIS STRUCTURE HAS BEEN DESIGNED IN ACCORDANCE WITH AND SHALL BE CONSTRUCTED TO CONFORM WITH THE 2024 ONTARIO BUILDING CODE, ONTARIO REGULATION 203/24 (REFERRED TO AS "THE BUILDING CODE"), ANY APPLICABLE ACTS OF ANY AUTHORITY HAVING JURISDICTION, AND THE FOLLOWING:

TABLE B.1: REFERENCE STANDARDS

| REF | CODE | TITLE |
|-----|-----------------------|--|
| a) | CAN/CSA A23.1 | CONCRETE MATERIALS AND METHODS OF CONCRETE CONSTRUCTION |
| b) | CAN/CSA A23.2 | METHODS OF TEST FOR CONCRETE |
| c) | CAN/CSA A23.3 | DESIGN OF CONCRETE STRUCTURES |
| d) | CAN/CSA-S16 | LIMIT STATES DESIGN OF STEEL STRUCTURES |
| e) | CAN/CSA G40.20/G40.21 | STRUCTURAL QUALITY STEEL |
| f) | RSIC | REINFORCING STEEL INSTITUTE OF CANADA, MANUAL OF STANDARD PRACTICE |
| g) | CAN/CSA-A370 | CONNECTORS FOR MASONRY |
| h) | CSA-A371 | MASONRY CONSTRUCTION FOR BUILDINGS |
| i) | S304.1 | DESIGN OF MASONRY STRUCTURES |
| j) | CSA G30.18 | CARBON STEEL BARS FOR CONCRETE REINFORCING |

- ALL STANDARDS AND PUBLICATIONS REFERENCED BY THE STANDARDS NOTED ABOVE ARE TO APPLY.
- WHERE THERE ARE DIFFERENCES BETWEEN THE DOCUMENTS AND THE STANDARDS, CODES AND ACTS, THE MOST STRINGENT SHALL GOVERN.

C. SUBMITTALS

- SUBMIT FOR REVIEW BY THE VARIOUS CONSULTANTS, DETAILED INFORMATION FOR ALL TEMPORARY AND PERMANENT STRUCTURAL WORK. THIS INCLUDES, BUT IS NOT LIMITED TO:

TABLE C.1: REQUIRED SUBMITTALS

| ITEM | SUBMISSION TO BE SEALED BY PROFESSIONAL ENGINEER | COMMENTS |
|--------------------------------|--|----------|
| CONCRETE MIX DESIGN | NO | |
| STRUCTURAL STEEL SHOP DRAWINGS | YES | |

- CONTRACTOR SHALL ALLOW FOR A TURN AROUND TIME OF FIVE WORKING DAYS FOR THE REVIEW OF THESE SUBMISSIONS.
- OUR REVIEW OF THE SHOP DRAWINGS IS ONLY FOR GENERAL CONFORMITY WITH STRUCTURAL CONTRACT DOCUMENTS AND SPECIFICATIONS. COMMENTS MADE ON THE SHOP DRAWINGS DURING THIS REVIEW DO NOT RELIEVE THE CONTRACTOR FROM COMPLIANCE WITH THE REQUIREMENTS OF THE STRUCTURAL CONTRACT DOCUMENTS AND SPECIFICATIONS. NOR DO THEY AUTHORIZE ANY CHANGES TO THE CONTRACT. REVIEW OF A SPECIFIC ITEM SHALL NOT INCLUDE REVIEW OF AN ASSEMBLY OF WHICH THE ITEM IS A COMPONENT. THE CONTRACTOR'S RESPONSIBILITIES INCLUDE ALL QUANTITIES, DETAIL DIMENSIONS, FIELD MEASUREMENTS, FABRICATION PROCESS, MEANS, METHODS, SEQUENCES, AND PROCEDURES OF CONSTRUCTION, COORDINATION OF WORK WITH ALL TRADES, AND PERFORMING ALL WORK IN A SAFE AND SATISFACTORY MANNER. THE REVIEW OF SHOP DRAWINGS DOES NOT IMPLY ANY CHANGE IN ANY OTHER CONSULTANT'S OR PROFESSIONAL'S RESPONSIBILITY RELATED TO DESIGN OF SPECIFIC ITEMS AS OUTLINED BY THE SPECIFICATIONS (SUCH AS STRUCTURAL STEEL CONNECTIONS, STEEL JOISTS, PRECAST ELEMENTS, ETC.). AFTER REVIEW, THE DRAWINGS WILL BE STAMPED AND RETURNED TO SHOW ONE OF THE FOLLOWING:

NOT REVIEWED SHOWS WORK WHICH IS NOT WITHIN THE SCOPE OF STRUCTURAL CONSULTING SERVICES.

REVIEWED NO DEVIATIONS FROM THE CONTRACT DOCUMENTS NOTED.

NOTED WE HAVE MADE COMMENTS TO BE REVIEWED / INCORPORATED. SUBMIT RECORD PRINT.

RESUBMIT REVISE AND RE-SUBMIT FOR REVIEW.

D. MATERIALS

- PROVIDE ONLY NEW STRUCTURAL MATERIALS IN ACCORDANCE WITH THE REFERENCE STANDARDS AND THE FOLLOWING, UNLESS OTHERWISE NOTED.

1.1. CONCRETE:

- 1.1.1. CONCRETE STRENGTHS FOR STRUCTURAL ELEMENTS SHALL BE AS PER TABLE BELOW, UNLESS NOTED OTHERWISE ON PLANS, SCHEDULES, AND/OR SECTIONS.

TABLE D.1: CONCRETE STRENGTHS

| STRUCTURAL ELEMENT | CONCRETE STRENGTH (f'c) @ 28 DAYS, MPa | EXPOSURE CLASS | AIR CONTENT | COMMENTS |
|--------------------|--|----------------|-------------|----------|
| HOUSEKEEPING PADS | 20 | N | | |

NOTES

1. CONCRETE STRENGTHS FOR STRUCTURAL ELEMENTS SHALL BE AS PER THIS TABLE UNLESS OTHERWISE NOTED ON PLANS, SCHEDULES, OR SECTIONS.
2. CONTRACTOR SHALL REVIEW PROPOSED CONCRETE SLUMP BY THE CONCRETE MIX DESIGNER, REINFORCEMENT CONGESTION, AND WORKABILITY PRIOR TO AND DURING POUR TO AVOID HONEYCOMBING OR VOIDS.
3. NOTIFY ENGLINK IN WRITING IF CONDITIONS MAY PREVENT PROPER CONSOLIDATION. CORRECTIVE WORK DUE TO INADEQUATE PLACEMENT SHALL BE AT CONTRACTOR'S COST.

- 1.2. REINFORCING STEEL: CONFORM TO CSA G30 SERIES, GRADE 400.

- 1.3. WELDED WIRE FABRIC: CONFORM TO CSA G30 SERIES, GRADE 386, IN FLAT SHEETS.
- 1.4. STRUCTURAL STEEL:
 - 1.4.1. STRUCTURAL WIDE FLANGE (W) AND WELDED WIDE FLANGE SHAPES (WWF) TO CONFORM TO CAN/CSA G40.20/G40.21 GRADE 350W.
 - 1.4.2. ANGLES (L), CHANNELS (C), AND PLATES TO CONFORM TO CAN/CSA-G40.20/G40.21 GRADE 300W.
- 1.5. PRIME PAINT: CONFORM TO CISC/CPMA STANDARD 2-75.
- 1.6. HOT DIP GALVANIZING: CONFORM TO CSA-G164, MINIMUM ZINC COATING OF 600 g/m².
- 1.7. STRUCTURAL BOLTS, NUTS, AND WASHERS: CONFORM TO ASTM A325M.
- 1.8. ANCHOR RODS: CONFORM TO THE REQUIREMENTS OF ASTM F1554 GRADE 36.
- 1.9. NON-SHRINK GROUT: COMPRESSIVE STRENGTH OF 35 MPa AT 24 HOURS.
- 1.10. BLOCK: CONFORM TO CAN3-A165 SERIES, MINIMUM COMPRESSIVE STRENGTH, f_m = 15 MPa BASED ON NET AREA.
- 1.11. MORTAR: CONFORM TO CSA A179 TYPE S FOR LOAD-BEARING WALLS UNLESS NOTED.
- 1.12. MASONRY GROUT: CONFORM TO CSA A179, 12.5 MPa MINIMUM COMPRESSIVE STRENGTH AT 28 DAYS, 250 mm (10") SLUMP, MAXIMUM AGGREGATE SIZE 10 mm (3/8").
- 1.13. POST-INSTALLED ANCHORS: PROVIDED BY HILTI (CANADA) CORPORATION. CONTACT HILTI AT (800) 363-4458 FOR PRODUCT RELATED QUESTIONS.

F. QUALITY CONTROL

1. GENERAL
 - 1.1. IMPLEMENT A SYSTEM OF QUALITY CONTROL TO ENSURE THAT THE MINIMUM STANDARDS SPECIFIED HEREIN ARE ATTAINED.
 - 1.2. BRING TO THE ATTENTION OF THE CONSULTANT ANY DEFECTS IN THE WORK OR DEPARTURES FROM THE CONTRACT DOCUMENTS, WHICH MAY OCCUR DURING CONSTRUCTION. THE CONSULTANT WILL DECIDE UPON CORRECTIVE ACTION AND GIVE RECOMMENDATIONS IN WRITING.
 - 1.3. THE CONSULTANT'S GENERAL REVIEW DURING CONSTRUCTION AND INSPECTION AND TESTING BY INDEPENDENT INSPECTION AND TESTING AGENCIES REPORTING TO THE CONSULTANT ARE BOTH UNDERTAKEN TO INFORM THE OWNER / CLIENT OF THE CONTRACTOR'S PERFORMANCE AND SHALL IN NO WAY AUGMENT THE CONTRACTOR'S QUALITY CONTROL OR RELIEVE THE CONTRACTOR OF CONTRACTUAL RESPONSIBILITY.

G. EXECUTION

1. STRUCTURAL STEEL
 - 1.1. PAINT ALL STRUCTURAL STEEL TO REQUIREMENTS OF CISC/CPMA 2-75. TOUCH UP ALL FIELD WELDS.
 - 1.2. ALL STRUCTURAL STEEL EXPOSED TO WEATHER SHALL BE GALVANIZED IN ACCORDANCE WITH CSA G164.
 - 1.3. ALL WELDS SHALL CONFORM TO CSA STANDARD W59.
 - 1.4. ALL WELDS EXPOSED TO VIEW SHALL BE GROUND SMOOTH.
 - 1.5. ANY ORGANIZATION UNDERTAKING TO WELD UNDER THIS CONTRACT SHALL BE CERTIFIED BY THE CANADIAN WELDING BUREAU UNDER REQUIREMENTS OF DIVISION 1 OR DIVISION 2.1 OF W47.1.
 - 1.6. UNLESS A REINFORCED MASONRY OR CONCRETE LINTEL IS SHOWN IN MASONRY WALLS OR MASONRY PARTITIONS, PROVIDE LOOSE STEEL LINTELS IN ACCORDANCE WITH REQUIREMENTS OF DOCUMENTS OVER ALL DOORWAYS, OTHER OPENINGS, AND RECESSES, INCLUDING THOSE FOR MECHANICAL OR ELECTRICAL SERVICES. IT IS THE RESPONSIBILITY OF THE CONTRACTOR TO COORDINATE THE LOCATION, SIZE, AND NUMBER OF OPENINGS REQUIRED BY THE MECHANICAL AND ELECTRICAL CONSULTANT.
 - 1.7. DO NOT SPLICER STRUCTURAL STEEL SECTIONS WITHOUT PRIOR APPROVAL OF THE CONSULTANT. ALL SPLICES SHALL DEVELOP THE FULL CAPACITY OF THE SECTION AND ARE TO BE TESTED BY NON DESTRUCTIVE METHODS, BY AN INDEPENDENT INSPECTION AND TESTING COMPANY, AT THE CONTRACTOR'S EXPENSE.
2. MASONRY
 - 2.1. PROVIDE A MINIMUM LENGTH OF 200 mm (8") OF 100% SOLID MASONRY UNITS FOR BEARING OF STEEL, CONCRETE OR REINFORCED MASONRY LINTELS.
 - 2.2. SUPPLY AND PLACE REINFORCEMENT AND CONCRETE FOR REINFORCED MASONRY LINTELS IN ACCORDANCE WITH TYPICAL DETAILS SHOWN.
3. POST-INSTALLED ANCHORS
 - 3.1. MATERIALS
 - 3.1.1. EXCEPT WHERE INDICATED ON THE DRAWINGS, POST-INSTALLED ANCHORS SHALL CONSIST OF THE FOLLOWING ANCHOR TYPES AS PROVIDED BY HILTI (CANADA) CORPORATION. CONTACT HILTI AT (800) 363-4458 FOR PRODUCT RELATED QUESTIONS.
 - 3.1.2. ALL POST-INSTALLED ANCHORS SHALL ONLY BE INSTALLED IN A DRY CONDITION FOR INTERIOR EXPOSURE, AND A DRY OR WATER-SATURATED CONDITION FOR EXTERIOR EXPOSURE. WATER-FILLED INSTALLATION IS NOT PERMITTED UNLESS APPROVED BY THE CONSULTANT.
 - 3.1.3. ALL ANCHORS EXPOSED TO WEATHER SHALL BE GALVANIZED IN ACCORDANCE WITH CSA G164.
 - 3.2. QUALITY ASSURANCE
 - 3.2.1. POST-INSTALLED ANCHORS SHALL ONLY BE EXECUTED BY TRAINED PERSONNEL. INSTALLATION OF ALL POST-INSTALLED ANCHORS SHALL BE PER THE MANUFACTURER'S PRINTED INSTALLATION INSTRUCTIONS (MPII) AND THE CONTRACT DOCUMENTS. THE CONTRACTOR SHALL ARRANGE AN ANCHOR MANUFACTURER'S REPRESENTATIVE TO PROVIDE ON-SITE INSTALLATION TRAINING FOR ALL OF THEIR ANCHORING PRODUCTS SPECIFIED. A RECORD OF TRAINING SHALL BE KEPT ON SITE AND MADE AVAILABLE TO THE STRUCTURAL CONSULTANT OR THE INDEPENDENT TESTING AND INSPECTION COMPANY UPON REQUEST.
 - 3.3. DESIGN
 - 3.3.1. ALTERNATE PRODUCTS MUST BE APPROVED IN WRITING BY THE STRUCTURAL ENGINEER OF RECORD PRIOR TO USE. CONTRACTOR SHALL PROVIDE CALCULATIONS THAT HAVE BEEN SEALED BY ANOTHER LICENSED ENGINEER DEMONSTRATING THAT THE SUBSTITUTED PRODUCT IS CAPABLE OF MEETING THE PERFORMANCE OF THE SPECIFIED PRODUCT. SUBSTITUTIONS WILL BE EVALUATED BY THEM HAVING AN ICC-ESR SHOWING COMPLIANCE WITH THE RELEVANT BUILDING CODE FOR SEISMIC USES, LOAD RESISTANCE, INSTALLATION CATEGORY, AND AVAILABILITY OF COMPREHENSIVE INSTALLATION INSTRUCTIONS. ADHESIVE ANCHOR EVALUATION WILL ALSO CONSIDER CREEP, IN-SERVICE TEMPERATURE, INSTALLATION TEMPERATURE, MOISTURE CONDITION OF CONCRETE, AND DRILLING METHODS.
 - 3.3.2. ANCHOR CAPACITY IS DEPENDANT UPON SPACING BETWEEN ADJACENT ANCHORS AND PROXIMITY OF ANCHORS TO EDGE OF CONCRETE. INSTALL ANCHORS IN ACCORDANCE WITH SPACING AND EDGE CLEARANCES INDICATED ON THE DRAWINGS.
4. ALTERATIONS AND/OR CONNECTIONS TO EXISTING STRUCTURE
 - 4.1. INSPECT THE EXISTING BUILDING AND BECOME THOROUGHLY FAMILIAR WITH THE EXISTING CONDITIONS.
 - 4.2. PRIOR TO FABRICATION OF STRUCTURAL STEEL, OPEN UP ALL AREAS WHERE CONNECTIONS ARE TO BE MADE TO EXISTING WORK AND TAKE FIELD MEASUREMENTS. MODIFY METHODS FOR CONNECTING TO SUIT SITE CONDITIONS FOUND AND TO THE APPROVAL OF THE CONSULTANT. CARRY OUT LOCAL REPAIRS TO THE EXISTING WORK AS NECESSARY AND AS DIRECTED BY THE CONSULTANT.
 - 4.3. SHORE EXISTING WORK AS REQUIRED UNTIL ALL NEW WORK HAS BEEN COMPLETED AND REVIEWED BY THE CONSULTANT.
 - 4.4. SHORE FLOORS AS REQUIRED TO SUPPORT CRANES, HOISTS AND OTHER CONSTRUCTION EQUIPMENT.
 - 4.5. DO NOT CUT CONCRETE REINFORCEMENT UNLESS REVIEWED AND APPROVED BY THE CONSULTANT.
 - 4.6. WHERE REQUIRED TO AVOID CUTTING EXISTING REINFORCEMENT, MODIFY THE LAYOUT OF NEW THROUGH BOLTS, EXPANSION ANCHORS AND OTHER ANCHORING DEVICES.
 - 4.7. MAKE GOOD THE EXISTING WORK.
5. CUTTING AND CORING OF EXISTING STRUCTURE



| | | | |
|-----|-------------------|----|------------|
| 01 | ISSUED FOR TENDER | MH | 12/22/2025 |
| No. | DESCRIPTION | BY | DATE |

REVISIONS / STATUS

| | |
|--|--|
| | |
| | |

PROJECT:
VAUGHAN WILLARD P.S.
- AHU REPLACEMENT

Project No.: 25-14

Scale: N/A
Drawn by: AQV
Checked by: MH / STB

Address: 1911 Dixie Rd N, Pickering, ON L1V 1V4


LIST OF STRUCTURAL DRAWINGS

| Sheet No. | Sheet Title |
|-----------|-----------------|
| S-101 | GENERAL NOTES |
| S-102 | TYPICAL DETAILS |
| S-201 | FRAMING PLANS |



| STRUCTURAL ABBREVIATIONS | | TD-G01 |
|--------------------------|----------------------------------|-------------------------------|
| A BOLT(s) | ANCHOR BOLT(S) | F _y YIELD STRENGTH |
| AFF | ABOVE FINISHED FLOOR | G _A GAUZE |
| ALT | ALTERNATIVE | GALV GALVANIZED |
| ARCH | ARCHITECTURAL | GEN GENERAL |
| ASL | ADDITIONAL ACCUMULATED SNOW LOAD | H HORIZ HORIZONTAL |
| B, BOTT | BOTTOM | H1 HOOK ONE END |
| B/B | BACK TO BACK | HEF HORIZONTAL EACH FACE |
| B/EW | BOTTOM EACH WAY | FACTORED HORIZONTAL FORCE |
| BLL | BOTTOM LOWER LAYER | REF REFERENCE |
| BLDG | BUILDING | REQD REQUIRED |
| BPL | BASE PLATE, BEARING PLATE | REV REVISION, REVISED |
| BRDG | BRIDGING | RW REINFORCED WITH |
| BUL | BOTTOM UPPER LAYER | SEE ARCHITECTURAL DRAWINGS |
| C | CAMBER | HP HORIZONTAL |
| c/c | CENTRE TO CENTRE | H1E HOOK ONE END |
| CA | COLUMN ABOVE | HEF HORIZONTAL EACH FACE |
| CANT | CANTILEVERED | FACTORED HORIZONTAL FORCE |
| CB | COL BELOW | REF REFERENCE |
| CDL | COMPRESSION | REQD REQUIRED |
| Cf | DEVELOPED LENGTH | REV REVISION, REVISED |
| CfC | FACTORED COMPRESSIVE FORCE | RW REINFORCED WITH |
| CLS | COMPRESSION JOINT | SEE ARCHITECTURAL DRAWINGS |
| COL(s) | COMPRESSION LAP SPLICE | HP HORIZONTAL |
| COMP | COMPOSITE | H1E HOOK ONE END |
| CONC | CONCRETE | HEF HORIZONTAL EACH FACE |
| CONT | CONTINUOUS | FACTORED HORIZONTAL FORCE |
| c/w | COMPLETE WITH | REF REFERENCE |
| DEMO | DEMOLITION, DEMOLISH(ED) | REQD REQUIRED |
| DIAG | DIAGONAL | REV REVISION, REVISED |
| DIM | DIMENSION | RW REINFORCED WITH |
| DL | DEAD LOAD | SEE ARCHITECTURAL DRAWINGS |
| DP | DEEP | HP HORIZONTAL |
| DWG(s) | DRAWING(S) | H1E HOOK ONE END |
| DWLS | DWELLS | HEF HORIZONTAL EACH FACE |
| DN | DOWN | FACTORED HORIZONTAL FORCE |
| EA | EACH | REF REFERENCE |
| EE | EACH END | REQD REQUIRED |
| EF | EACH FACE | REV REVISION, REVISED |
| ELEC | ELECTRICAL | RW REINFORCED WITH |
| EL | ELEVATION | SEE ARCHITECTURAL DRAWINGS |
| ELEV | ELEVATOR | HP HORIZONTAL |
| EMBED | EMBEDMENT | H1E HOOK ONE END |
| EQ | EQUAL | HEF HORIZONTAL EACH FACE |
| ES | EACH SIDE | FACTORED BENDING |
| EX, EXIST | EXISTING | MOMENT ALONG x-AXIS |
| EJ, EXP JT | EXISTING JOINT | FACTORED BENDING |
| E-W | EASTWARD | MOMENT ALONG y-AXIS |
| EW | EACH WAY | NOT IN CONTRACT |
| EXT | EXTERIOR | WIDE FLANGE BEAM |
| fc | 28 DAYS CONCRETE | STRUCTURAL TEE |
| FDN | FOUNDATION | WELDED WIRE FABRIC |
| FIN | FINISHED | WELDED WIDE FLANGE |
| FL | FLOOR | WELDED WIDE FLANGE |
| ft | LINEAR FOOT, LINEAR FEET | WELDED WIDE FLANGE |
| FTG | FOOTING | WELDED WIDE FLANGE |

| DETAILS FOR HOUSEKEEPING PADS | | TD-CS11A |
|--|--|------------------------------|
| SEE ARCH DWGS | | |
| HOUSEKEEPING PAD | | |
| STRUCTURAL SLAB | | |
| PAD THICKNESS "I" | | REINFORCEMENT |
| 50 (2") | | WWF152x152MW18.7MW18.7 LAYER |
| 100 (4") | | 10@300 (10@12") ML EW |
| 150 (6") | | 10@400 (10@16") TEW & BEW |
| 200 (8") | | |
| NOTE: | | |
| 1. REFER TO ARCHITECTURAL, MECHANICAL, ELECTRICAL, DRAWINGS FOR LOCATION, THICKNESS AND SIZE OF HOUSEKEEPING PADS. | | |
| 1. PRIOR TO SUBSTANTIAL COMPLETION OF THE PROJECT, GROUT ALL CRACKS IN THE HOUSEKEEPING PADS AND FILL WITH MORTAR CONTAINING CEMENT, SAND AND LATEX BONDING AGENT OR AS NOTED IN SPECIFICATIONS. | | |

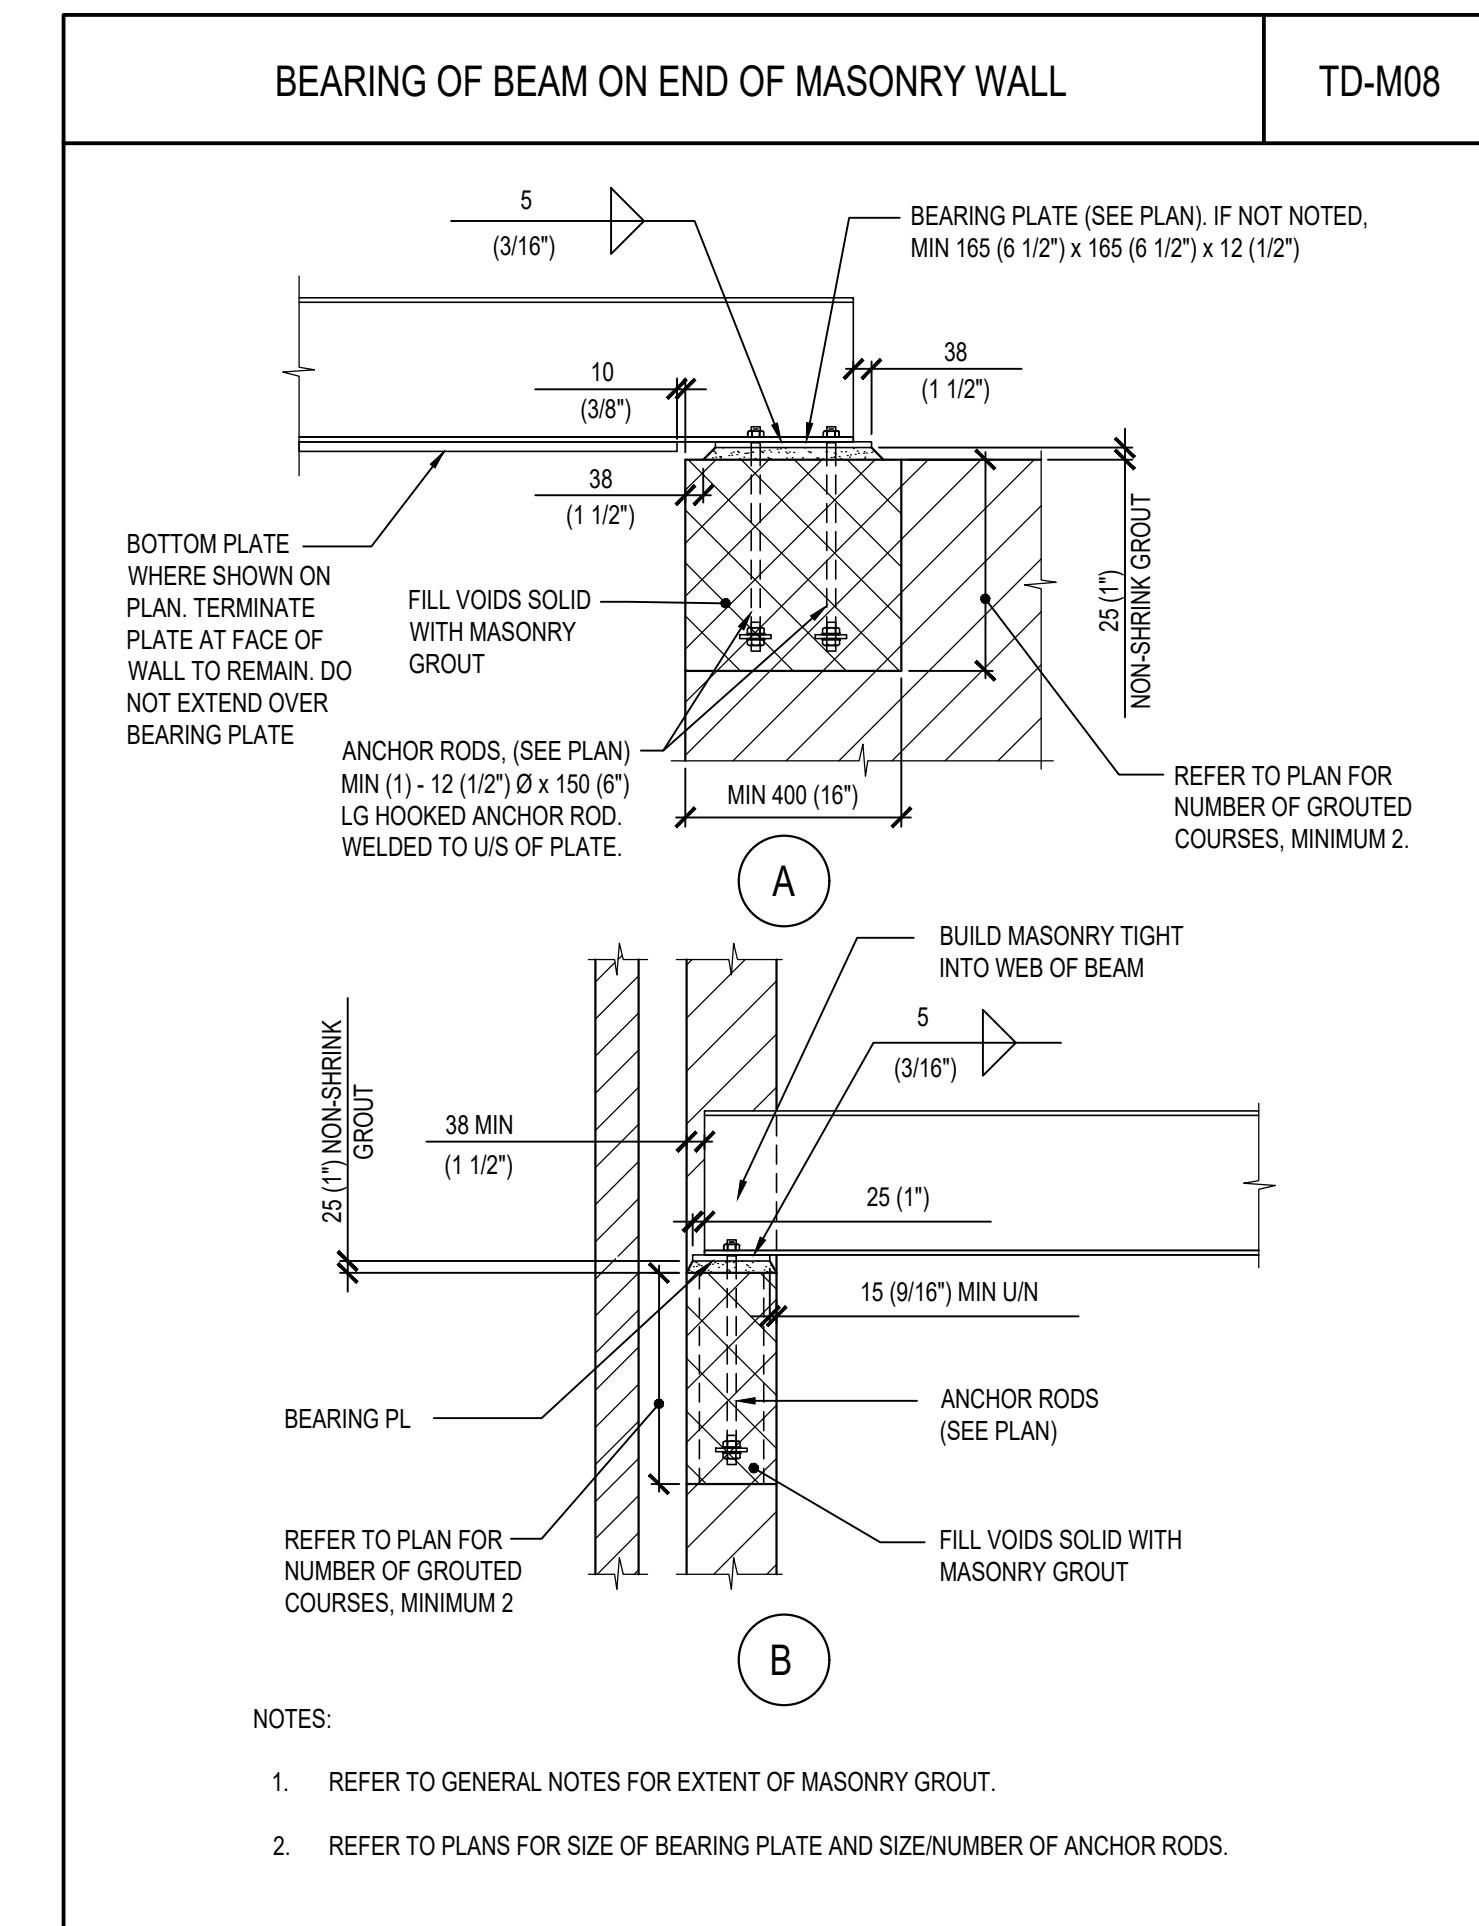

| STEEL LINTELS FOR NON-LOAD BEARING MASONRY WALLS | | TD-S01 |
|--|-------------------|--------------------|
| REINFORCING IS SHOWN ON PLAN OR DETAILS. WHERE AT SIDES OF OPENINGS PLACE TO CLEAR LINTEL BEARING. | | |
| PROVIDE FULLY GROUTED OR SOLID MASONRY FULL HEIGHT WHERE PIER IS LESS THAN 600 mm (2') WIDE | | |
| STEEL LINTEL | | |
| 200 (8") BEARING MIN FULLY GROUTED | | |
| L178x102x9.5 (LLV) + 2-16Ø (3/4") HILTI KWIK BOLT 3 ANCHORS PROVIDE MIN 100 mm (4") EMBED LENGTH LESS THAN MASONRY WALL THICKNESS | | |
| WHERE WALL THICKNESS IS REDUCED BY RECESSES INCLUDE WIDTH IN SPAN | | |
| STANDARD ELEVATION | | |
| CONNECTION OF ANGLE TO COLUMN SHALL BE CAPABLE OF SUPPORTING A VERTICAL SHEAR FORCE Vf=20 kN (4.5 kips) | | |
| L178x102x9.5 (LLV) LENGTH LESS THAN WIDTH OF MASONRY WALL | | |
| STEEL LINTEL | | |
| STEEL COLUMN | | |
| LINTEL SUPPORTED BY POURED CONCRETE ELEMENT | | |
| LINTEL SUPPORTED BY STEEL COLUMN | | |
| CLEAR SPAN | | |
| WALL THICKNESS | | |
| 90 (3 1/2") | 140 (5 1/2") | 190 (7 1/2") |
| 120 (4") | L80x9x6.4 | 2-L64x6x4 |
| 120 (4") TO 1800 (6") | L127x89x6.4 (LLV) | 2-L89x64x6 (LLV) |
| 1800 (6") TO 2400 (8") | L127x89x6.4 (LLV) | 2-L89x64x7.9 (LLV) |
| 2400 (8") TO 3000 (10") | L127x89x9.5 (LLV) | 2-L89x64x9.5 (LLV) |
| DETAIL | LL | LL |
| NOTES: | | |
| 1. CONNECT BACK TO BACK DOUBLE ANGLE LINTELS USING 16 mm (5/8") Ø BOLTS AT 450 mm (18") c/c MAX OR BY WELDING AT TOP AND BOTTOM USING 6 mm (1/4") WELDS x 50 mm (2") LONG AT 450 mm (18") c/c MAX. FIRST BOLT OR WELD TO BE A MAX OF 75 mm (3") FROM END OF LINTEL | | |
| 2. FULLY PACK LINTEL ENDS WITH STEEL SHIMS TO ENSURE EVEN BEARING. | | |
| 3. LINTELS AS COVERED UNDER THIS DETAIL ARE NOT NECESSARILY SHOWN ON THE STRUCTURAL DRAWINGS. REFER TO ARCHITECTURAL, MECHANICAL AND ELECTRICAL DRAWINGS FOR OPENING LOCATIONS AND SIZES. | | |


| | | | |
|--------------------|-------------------|----|------------|
| 01 | ISSUED FOR TENDER | MH | 12/22/2025 |
| No. | DESCRIPTION | BY | DATE |
| REVISIONS / STATUS | | | |

PROJECT:
VAUGHAN WILLARD P.S.
- AHU REPLACEMENT

Project No: 25-14

Scale: NTS
Drawn by: AQV
Checked by: MH / STB
Address: 1911 Dixie Rd N, Pickering, ON L1V 1V4

TITLE:
TYPICAL DETAILS

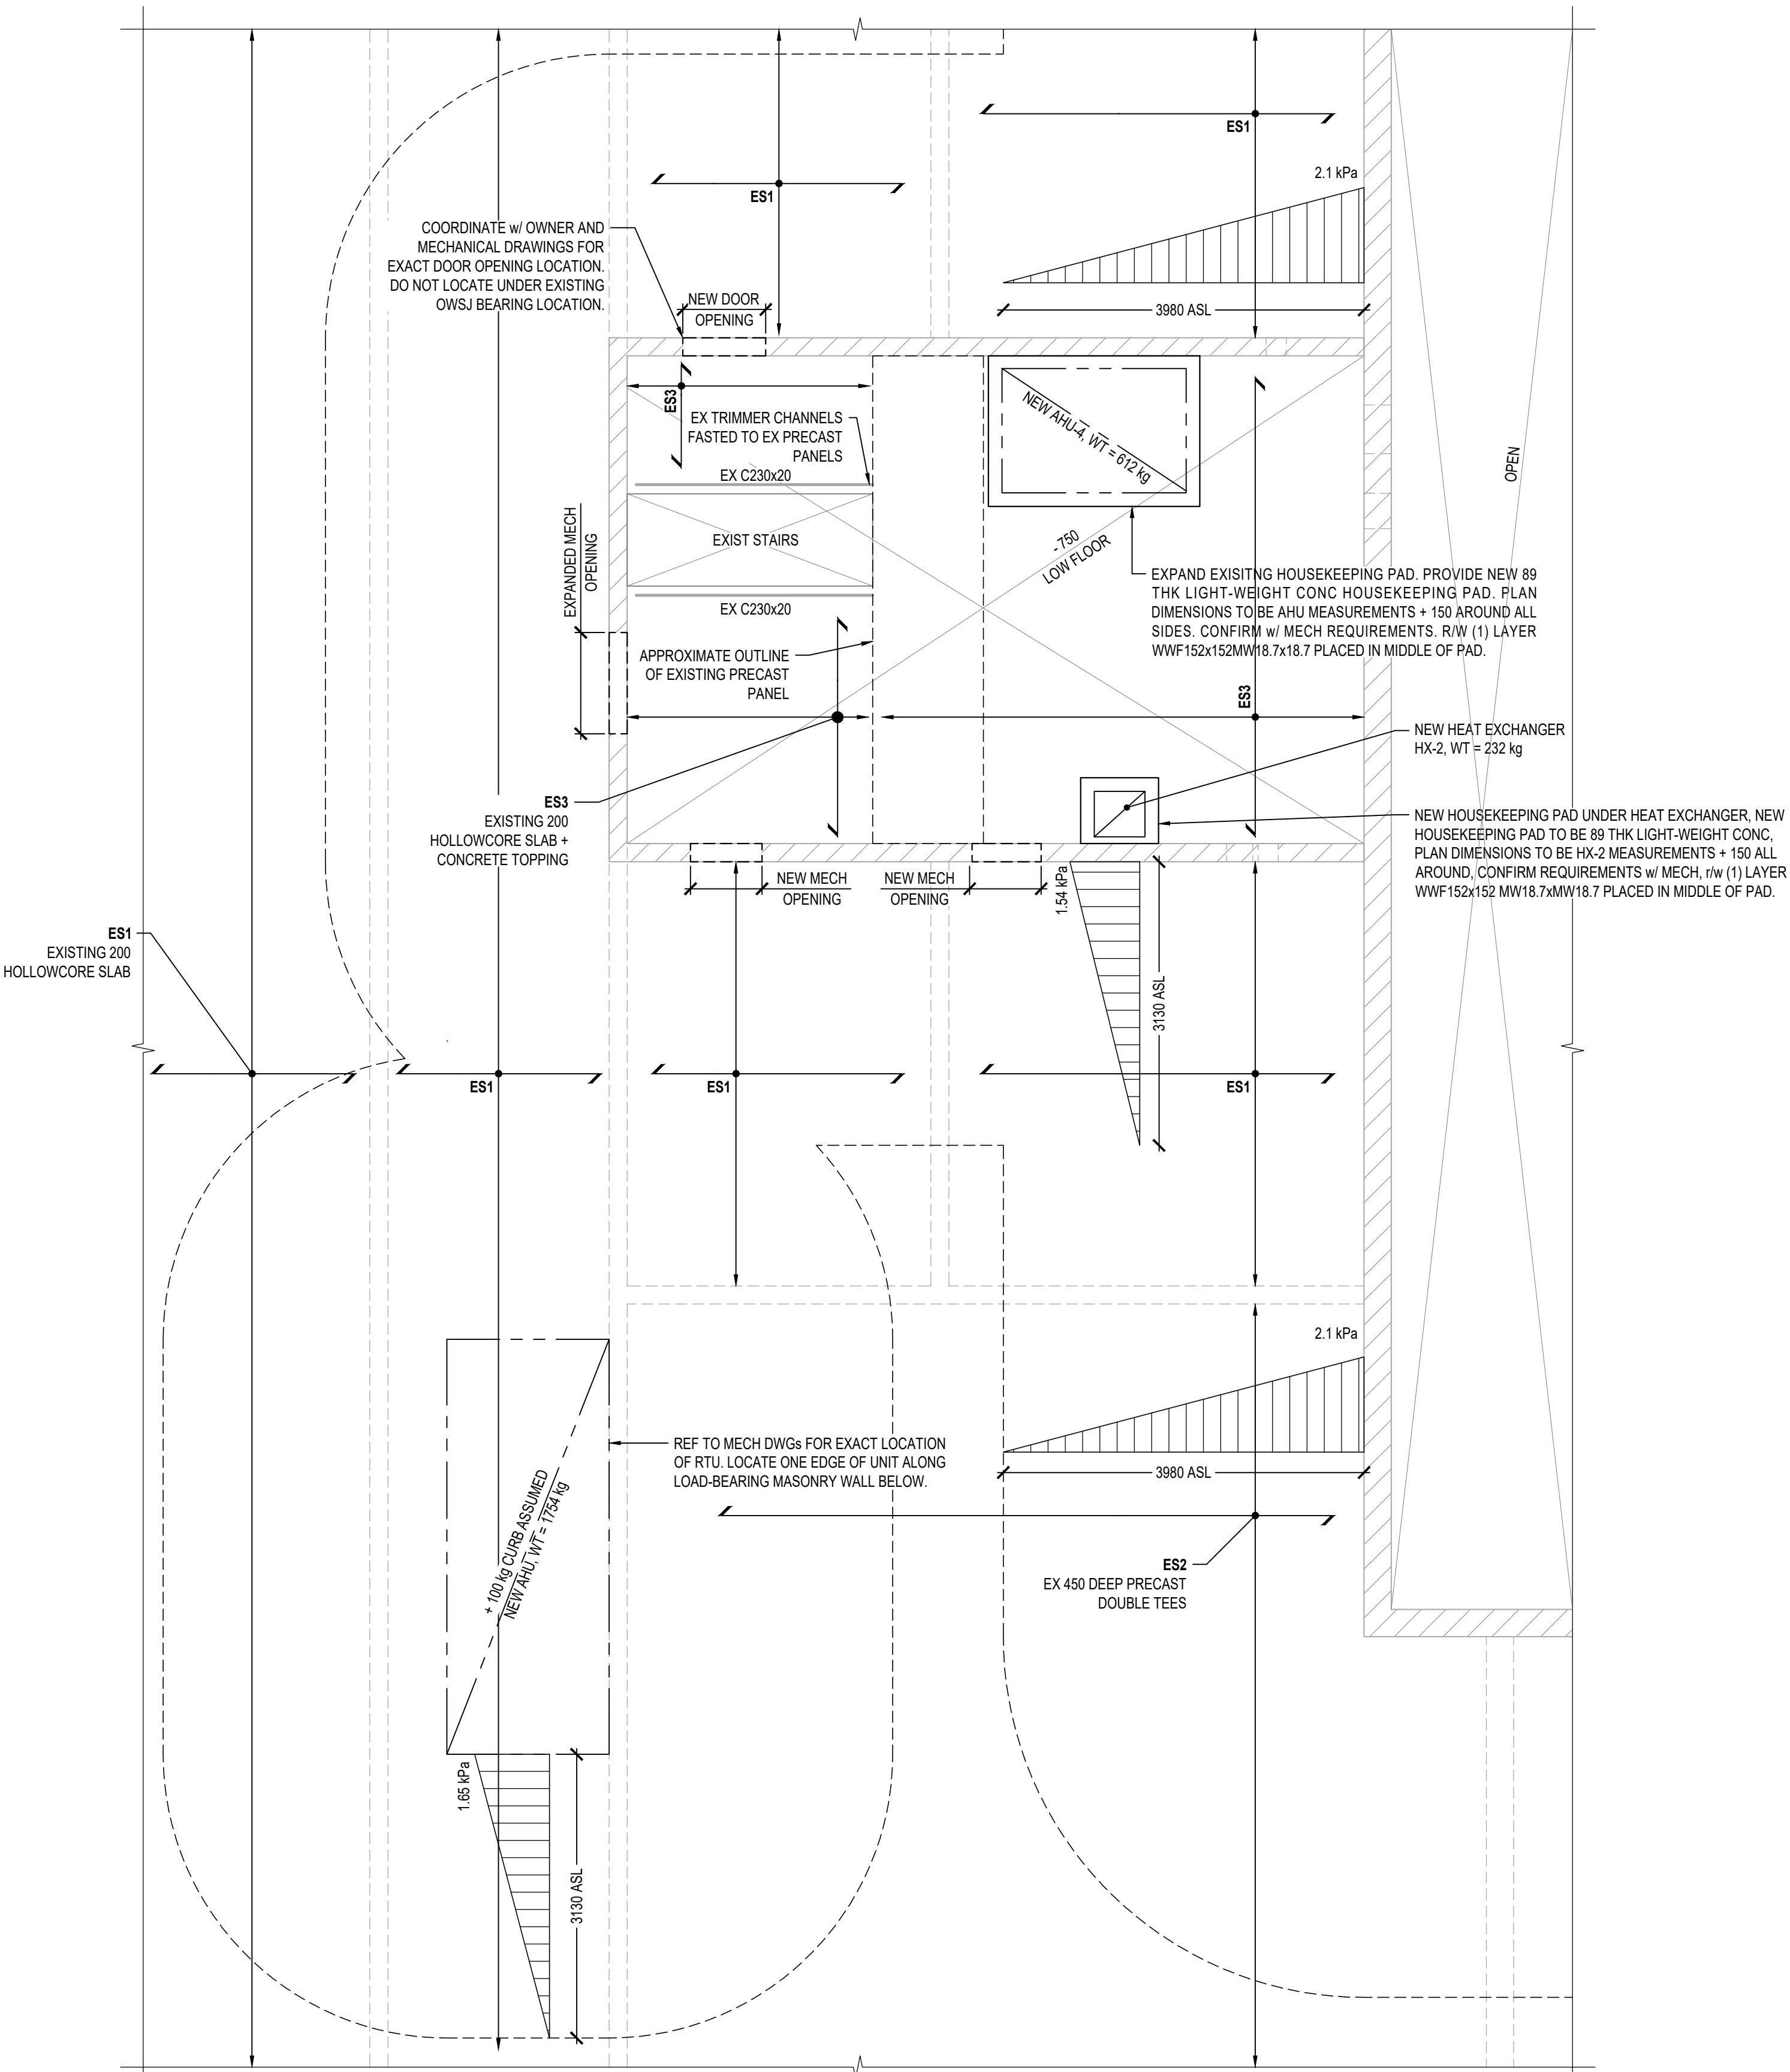

B SECOND FLOOR AND LOW ROOF FRAMING PART PLAN

S-201

1:50

SECOND FLOOR AND LOW ROOF FRAMING NOTES

- TOP OF EXISTING HOLLOW-CORE SLABS IS AT ELEVATION + 3600 ABOVE EXISTING SLAB ON GRADE UNLESS CROSSED AND NOTED. CONTRACTOR TO SITE VERIFY. ELEVATIONS NOTED ARE REFERENCED FROM TOP OF EXISTING HOLLOW-CORE SLAB ELEVATION + 3600.
- SECOND FLOOR (INTERIOR) DESIGN LOADS ARE:
SUPER-IMPOSED DEAD LOAD 1.4 kPa
LIVE LOAD 3.6 kPa INTERIOR
- ROOF (EXTERIOR) DESIGN LOADS ARE:
SUPER-IMPOSED DEAD LOAD 1.0 kPa
SNOW LOAD 1.2 kPa + ASL
MULTIPLIED BY HIGH IMPORTANCE IULS = 1.15, ISLS = 0.9
- REFER TO MECHANICAL DRAWINGS FOR ELEVATION OF ALL NEW LINTELS.
- PROVIDE CLEAN SAW CUT AND CORING LINES AT ALL NEW MECHANICAL OPENINGS. MAKE GOOD ALL DAMAGED BLOCK / BRICK ADJACENT TO OPENINGS. UNLESS NOTED OTHERWISE ON PLAN PROVIDE STEEL LINTELS ABOVE ALL SUCH OPENINGS IN ACCORDANCE WITH TYPICAL DETAIL TD-S01. REFER TO MECHANICAL FOR NUMBER OF OPENINGS AND LOCATIONS.
- REMOVE EXISTING CEILING FINISHES, MECHANICAL SERVICES, AND THE LIKE TO COMPLETE THE STRUCTURAL WORK. PATCH AND MAKE GOOD.
- CONNECT NEW RTU TO ITS ROOF CURB AND THE ROOF CURB TO THE STRUCTURE PER MANUFACTURER'S REQUIREMENTS.
- WE HAVE REVIEWED THE LOADS IMPOSED BY THE PROPOSED RTU ON THE EXISTING STRUCTURE AND IN OUR OPINION THE STRUCTURE CAN SAFELY SUPPORT THE LOAD WITHOUT REINFORCING.

C HIGH ROOF FRAMING PART PLAN

S-201

1:50

HIGH ROOF ROOF FRAMING NOTES

- TOP OF EXISTING HOLLOW-CORE SLABS IS AT ELEVATION + 5400 ABOVE EXISTING SLAB ON GRADE UNLESS CROSSED AND NOTED. CONTRACTOR TO SITE VERIFY. ELEVATIONS NOTED ARE REFERENCED FROM TOP OF EXISTING HOLLOW-CORE SLAB ELEVATION + 5400.
- ROOF (EXTERIOR) DESIGN LOADS ARE:
SUPER-IMPOSED DEAD LOAD 1.0 kPa
SNOW LOAD 1.2 kPa + ASL
MULTIPLIED BY HIGH IMPORTANCE IULS = 1.15, ISLS = 0.9
- REFER TO MECHANICAL DRAWINGS FOR ELEVATION OF ALL NEW LINTELS.
- CONTRACTOR TO RETAIN A PROFESSIONAL ENGINEER, LICENSED IN THE PROVINCE OF ONTARIO, TO PREPARE ENGINEERED DRAWINGS FOR ALL TEMPORARY SHORING AS INDICATED ON PLAN. THE
- ENGINEER MUST HAVE A MINIMUM OF 5-YEARS EXPERIENCE IN THE DESIGN OF TEMPORARY SHORING SYSTEMS AND WILL BE RESPONSIBLE FOR REVIEWING THE SHORING INSTALLATION TO ENSURE IT MEETS THEIR DESIGN REQUIREMENTS.
- THE CONTRACTOR IS RESPONSIBLE FOR COORDINATING NEW WORK WITH TEMPORARY SHORING REQUIREMENTS.
- PROVIDE CLEAN SAW CUT AND CORING LINES AT ALL NEW MECHANICAL OPENINGS. MAKE GOOD ALL DAMAGED BLOCK / BRICK ADJACENT TO OPENINGS. UNLESS NOTED OTHERWISE ON PLAN PROVIDE STEEL LINTELS ABOVE ALL SUCH OPENINGS IN ACCORDANCE WITH TYPICAL DETAIL TD-S01. REFER TO MECHANICAL FOR NUMBER OF OPENINGS AND LOCATIONS.
- REMOVE EXISTING CEILING FINISHES, MECHANICAL SERVICES, AND THE LIKE TO COMPLETE THE STRUCTURAL WORK. PATCH AND MAKE GOOD.

PROJECT:
VAUGHAN WILLARD P.S.
- AHU REPLACEMENT

Project No. 25-14

Scale: AS NOTED

Drawn by: AQV

Checked by: MH / STB

Address: 1911 Dixie Rd N, Pickering, ON L1V 1V4

TITLE:

FRAMING PLANS